

1 5000.00000 5000.00000 100.00000 C7
2 2344.89500 5000.00000 100.00000 B7
3 2998.00731 4999.47588 81.21337 C7
4 5000.05140 2349.29511 73.06626 IRON
5 4996.53073 2349.67685 73.12150 MON
6 4998.26966 3678.11656 87.85262 OCC
7 6324.75208 5000.00642 71.39331 OCC
8 2325.76669 7646.16219 93.04909 FNC P
9 4991.53031 6322.12802 115.85688 FNC P
10 4990.57902 6140.52173 117.22512 FNC
11 4993.91729 5868.67782 118.64927 FNC
12 4995.59454 5706.70040 119.58584 FNC
13 4994.36355 5484.01161 118.40363 FNC
14 385.13474 4983.67659 80.94218 TP
15 4684.04067 7396.82564 109.50143 TP
16 2561.43428 7974.76611 104.13020 FNC
17 2738.66037 7977.55792 110.27613 FNC
18 3005.70311 7979.27729 110.38488 FNC
19 3326.82453 7979.10614 101.88994 FNC
20 3587.54971 7979.74701 99.14955 FNC
21 3866.15872 7977.07961 96.97146 FNC
22 4529.81968 7980.40666 100.60274 FNC
23 5442.54358 7983.29243 96.02997 FNC
24 5227.96088 7980.95974 96.94889 FNC
25 4896.51710 7981.03162 97.54904 FNC
26 4673.61263 7980.78120 99.16370 FNC
27 4972.54043 10298.03657 109.05393 C5
28 2791.23557 10303.43132 125.25293 TP
29 2317.33696 10293.60110 111.49544 SEC CNR B5
30 -334.51504 10280.13151 102.29698 M5
31 -334.02846 10289.33706 101.66557 A5
32 -321.05811 7641.66449 87.84424 A6
33 -320.96691 7635.80506 87.15958 M6 ONON
34 -307.48320 5001.39987 86.04161 A7
35 -307.39366 4998.10929 86.27411 M7 ONON
36 385.00680 4983.41252 81.25892 TP 14
37 2344.73119 4999.72139 99.71389 B7/02
38 4986.27022 7649.01828 104.52696 e1/4sec7
39 2331.12359 7645.33933 0.00000 center7
40 2561.43053 7976.72567 0.00000 BESTFIT
41 5442.54559 7982.24193 0.00000 BESTFIT

LESLIE T INRIW A-4

	A	B	C	D	E	F	G	H	I	J	K	L	M
1													
2		6	-	5	-	4	-	3	-	2	-	1	-
3													
4		7	-	8	-	9	-	10	-	11	-	12	-
5													
6		18	-	17	-	16	-	15	-	14	-	13	-
7													
8													
9		19	-	20	-	21	-	22	-	23	-	24	-
10													
11		30	-	29	-	28	-	27	-	26	-	25	-
12													
13		31	-	32	-	33	-	34	-	35	-	36	-

INGHAM COUNTY SURVEY and REMONUMENTATION PROJECT

Township LESLIE , T 1 N , R 1 W

Corner Code A-4

OFF ROAD

Research Record:

	attachment number(s)	no. of sheets	researched by	reviewed by
Corner Recordation Certificate Liber Page	N.D.		LALONDE	J.M.
Recorded Land Survey Liber Page	N.D.			J.M.
Recorded Subdivision Plat Liber Page	N.D.			J.M.
MDSHT Right-of-Way Maps Sheet No.	N.D.			J.M.
Ingham County Road Comm. Maps Sheet No.	N.D.			J.M.
Record of the Ingham County Surveyor Vol. <u>5</u> Page <u>1</u> Year <u>1899</u>	<u>1</u>	<u>3</u>		J.M.
General Land Office Maps Sheet No. <u>8</u>	<u>2</u>	<u>1</u>		J.M.
Form 280, Gov't. Monument Witness Record	N.D.			J.M.
Ingham County Drain Comm. File No.	N.D.			J.M.
East Lansing City Engineer	N.D.			"
Lansing Public Service Office Cade's 1921 Survey p.	N.D.			"
Lansing Public Service Office J.B. Davis' Field Notes p.	N.D.			"
G.L.O. Field Notes	NO DATA			J.M.
Misc. I.C. S. Notes <u>BK. 15 P. 102-3</u>	<u>4</u>	<u>1</u>		J.M.
Field Recon. Form	N.D.			J.M.
RESEARCH COMPLETED	Total	Total		
Consumers Power Company Sheet No. Index No.	N.D.		LALONDE	J.M.
Chesapeake & Ohio Railroad Co. Val. Sec. Drawer Sheet	N.D.		↓	"
RESEARCH COMPLETED	Total	Total		
REMARKS <u>NOTHING NOTES</u>	N.D.		MARTIN	
<u>FOLDER #1 PAGE 13</u>	<u>5</u>	<u>1</u>	↓	
<u>FOLDER #2</u>	N.D.			

SOURCE: MISC. FIELD NOTES

Bk. # 15, P. 102-103

TRANSCRIBED from ~~ORIGINAL~~ DUPLICATE on file at REMONUMENTATION OFFICE

Page 102

Sec. 7 Leslie

Surveyed Oct. 16 & 30, 1899 for N. Van Anker and others.

N. Van Anker

Sworn

Geo. H. Pendleton

Chainmen

Com. at S. $\frac{1}{4}$ post Sec. 7 ^O ^F ~~Q.P.A.~~ & ~~Q.W.~~ Long blue stone set f.w.:
W. Oak 15" N. 52° W. 59 lks.

Maple 4" North 33 lks.

Thence S. $89\frac{1}{2}^{\circ}$ W. 40.19 ~~to~~ ^{to} S.W. cor. sec. Stone found 14 lks. North of Onondaga. Stone f.w.:

Plum 4" N. 48° E. 67 lks.

Butternut 8" S. $67\frac{1}{2}^{\circ}$ E. $82\frac{1}{2}$ lks.

Butternut 8" S. $34\frac{1}{4}^{\circ}$ W. 78 lks.

As there was no Gov. _____ on this line I set lost post at $\frac{1}{2}$ distance 20.09 $\frac{1}{2}$ East of sec. corner a blue stone f.w.:

Sug. 10" S. 03° W. 37 lks.

Elm 4" S. 51° W. 62 lks.

On sec. line 5.00 ch. west from lot post set blue stone & crock. for form corner f.w.:

Butternut 10" N. $58\frac{1}{2}^{\circ}$ E. 53 lks.

Also set stone 10.00 ch. west of lot post for form corner.

Thence back S. $\frac{1}{4}$ post and from there N. $89\frac{3}{4}^{\circ}$ E. along sec. line 40.25 $\frac{1}{2}$ ch. ~~to~~ Stone at S.E. cor. ~~Q.P.A.~~ & ~~Q.W.~~ Back on line 20.12 $\frac{3}{4}$ ch. set lot post a stone with broken tile f.w.:

Sug. 4" S.-E. 56 lks.

Sug. 4" S.-W. $147\frac{1}{2}$ lks.

Thence N. $3\frac{1}{4}^{\circ}$ W. 40.31 ch. to N.E. cor., W. $\frac{1}{2}$, S.E. $\frac{1}{4}$, Sec. 7 where

Page 103

using E. & W. $\frac{1}{4}$ line and determining center of sec. f.w.:

Beech 10" N. 10° W. 3 lks.

A-4 Thence ~~E.~~ ^{to} E. $\frac{1}{4}$ post S. $89\frac{3}{4}^{\circ}$ W. 80.66 ch. ^{to} ~~S.~~ W. $\frac{1}{4}$ post ~~Q.P.A.~~ ^O ^F ~~Q.P.H.~~

After running N. & S. $\frac{1}{4}$ line and determining the center of section. Posts were set on this line for lot posts and also ~~D.~~ ^{to} set off the E. 40 a. of W. frl. $\frac{1}{2}$ of S.W. $\frac{1}{4}$ Sec. 7 and posts each 5.00 ch. on all form lines except E. & W. $\frac{1}{4}$ line. N. var. allowed.

I hereby certify that on the 16 & 30 days of October 1899 I surveyed the established the corners and made the witnesses as above given.

Signed: W. A. Rowe Co. Surveyor

MONUMENTED CORNER REPORT

TECH. SUP'R. L.B. TOWNSHIP Leslie
 COMPANY Polaris CORNER CODE A-5
 FIELD SQUAD L. Faust #6 RECORDED CORNER —
 DATE 6-6-78 ROAD NAME Covert


Sketch, witness, and describe monuments found, and location relative to traverse point and centerline of road.

N Final Witnesses:

- 1) fd. N+T. ON S.E. side Power Pole N. 60° E. 63.38'
- 2) fd. N+T. ON S. side 16" Pine Tree N. 75° E. 76.18'
- 3) fd. N+T. ON E. side Power Pole S. 70° E. 54.74'
- 4) fd. N+T. ON S.E. side CORNER S. 50° E. 47.86'
- 5) fd. Monument w/cap (R.L.S. #18998) Due S. 9.26'
- 6) fd. N+T. ON E. side 36" DIA OAK S. 10° W. 196.35' 196.35'

Note: N+T's fd. All are R.L.S. # 18998

Set Monument (1/2" Iron encased with-in concrete) w/cap (R.L.S. #18998) to large Pointed stone. (see excavation report) 4" Below surface. Witnesses Above.

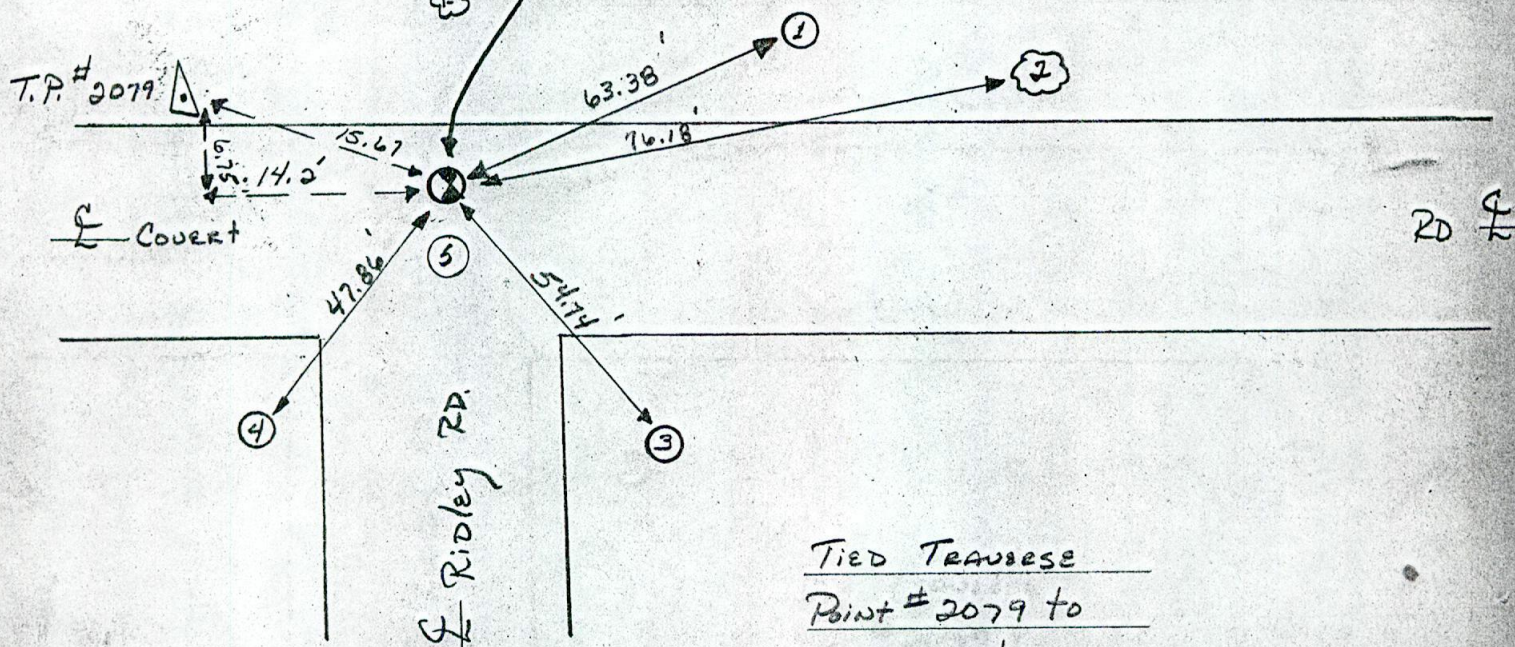

Tied Traverse
Point #2079 to
Monument. Measured
A Right triangle

MONUMENTED CORNER REPORT


TECH. SUP'R. L.B. TOWNSHIP Leslie
 COMPANY Polaris CORNER CODE A-5
 FIELD SQUAD L. Faust #6 RECORDED CORNER —
 DATE 6-6-78 ROAD NAME Covert

Sketch, witness, and describe monuments found, and location relative to traverse point and centerline of road.

N Final Witnesses:

- | | | | |
|------|--------|---------------------------------------|---------------------------------|
| D+G | S 5 | 1) to N.T. ON S.E. Side Power Pole | N. 60° E. 63.40' |
| 3.38 | 63.34 | 2) to N.T. ON S. Side 14" Pine Tree | N. 75° E. 76.17' |
| 6.16 | 76.17 | 3) to N.T. ON E. Side Power Pole | S. 70° E. 54.77' |
| 4.75 | 54.72 | 4) to N.T. ON S.E. Side Corner | S. 50° W. 47.85' |
| 7.85 | 47.85 | 5) to Monument w/cap (R.L.S. #18998) | Due S. 9.23' |
| 1.21 | 9.22 | 6) to N.T. ON E. Side 36" Dia Oak | S. 10° W. ^{COUNT FIND} |
| 6.34 | 196.29 | Notes: N.T.s to All are R.L.S. #18998 | |

Set Monument (1/2 Iron encased with-in concrete) w/cap (R.L.S. #18998) to large Painted Stone (see excavation Report) 4" Below Surface. Witnesses Above.

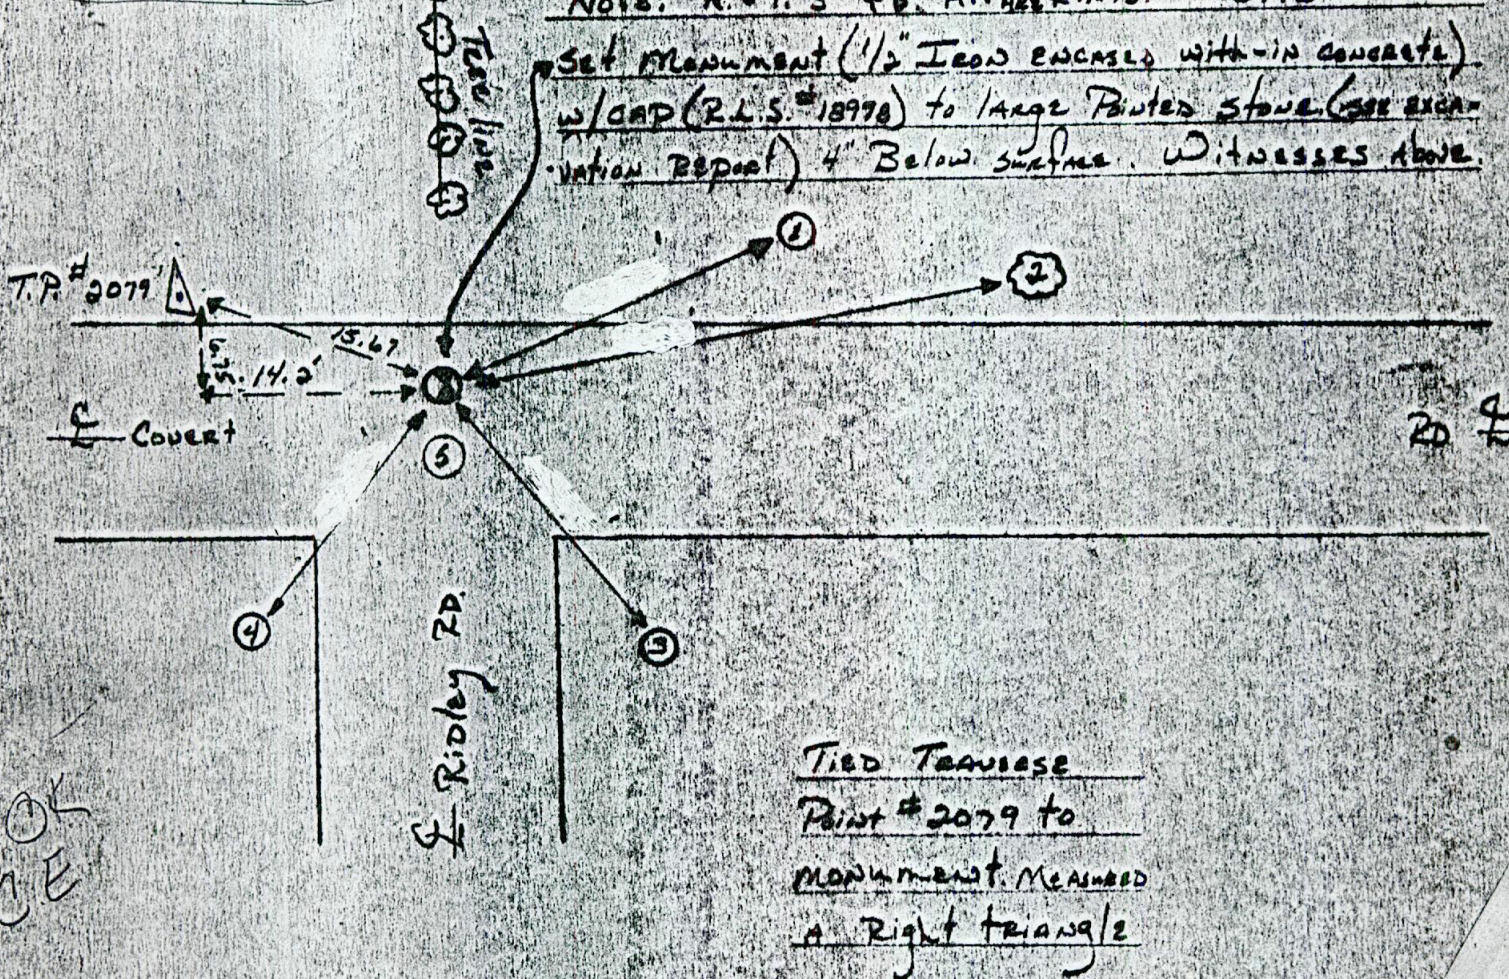



EXCAVATION REPORT

TECH. SUP'R. L. B. TOWNSHIP Leslie
COMPANY Polaris CORNER CODE A-5
FIELD SQUAD L. Faust #6 PAGE 1 OF 1 DATE 6-6-78

EXCAVATED AREA: 6' by 5' sq. 30 SQ. FT.; AVG. DEPTH 3.8' SURFACE Asphalt
Sketch and describe roads, monuments found or set, and witnesses established:

N FOUND:
Large Pointed Stone 1.6' below surface. (Stone referred to as "Leslie" stone) Pt. "A" 9.26' N. of monument M-5
Leslie Stone called for in M-5 Dossier. (see attachments ^{TIN ROW} 1, 2, 10, 11, 12, 13) See final witnesses Monument Report. Tree line Due N. of Pt. "A"

Note
N. Edge of excavation is even with N. edge of Covert Rd.

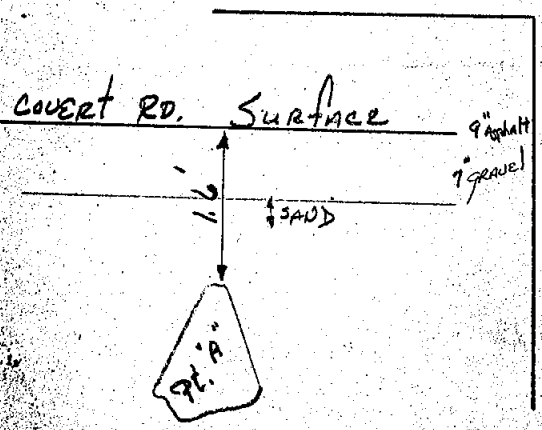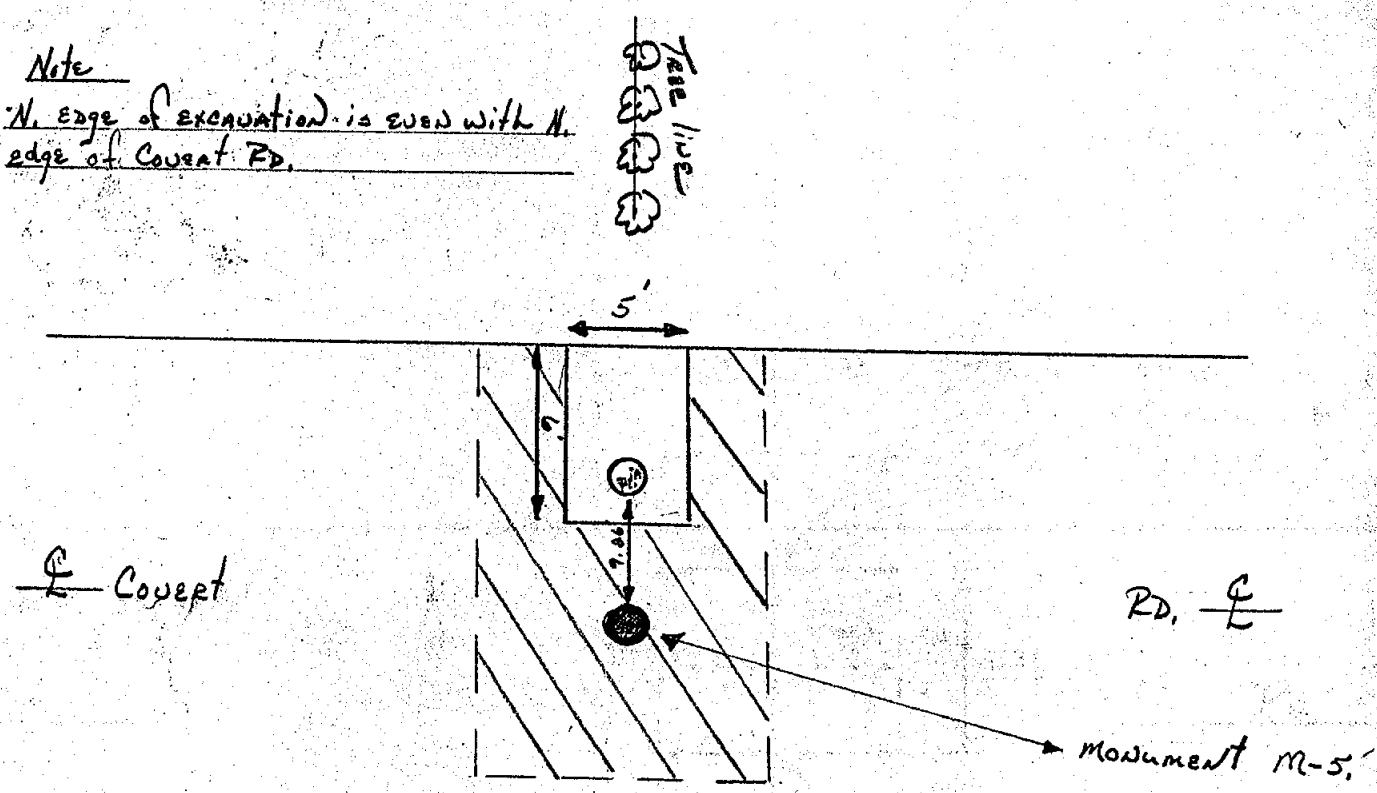


Ridley

EXCELLENT
CORNER ALSO
SEE M-5 ON MONUMENT
TWP.
L. BRYAN

TECH. SUP'R. L. BRYAN TOWNSHIP LESLIE
COMPANY POLARIS CORNER CODE A-5
FIELD SQUAD #9 MINCH-MARTIN ROAD NAME INTER. COVERT RD. / RIDLEY RD. / ASPHALT

Sketch, witness, and describe monuments found and proposed excavation site relative to traverse point and centerline of road.

- N
- BEGIN EXCAVATION AT A POINT 14.1' EAST & 4.9' SOUTH OF TP 2079 ON FENCE TO NORTH AT FD. R.R. SPIKE
 - FOR WITNESSES SEE MON. COR. REPORT
 - CALCULATED DIST. 9.24'
MEASURED DIST. 9.35'

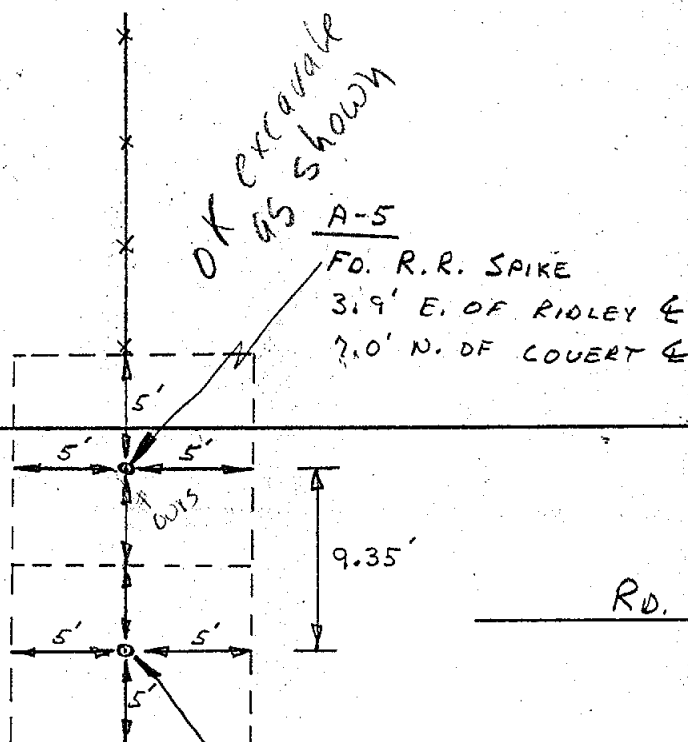

E RIDLEY RD.

M-5
FD. R.R. SPIKE
LOOK FOR STONE &
BRICK @ BOTH COR.

OK M-5

3-20-78; Fld. Form No. 5

TECH. SUP'R. L. BRYANTOWNSHIP LESLIECOMPANY POLARISCORNER CODE A-5FIELD SQUAD #9 MINCH - MARTINRECORDED CORNER NODATE 1-25-78ROAD NAME INTER. COVERT/RIDLEY

Sketch, witness, and describe monuments found, and location relative to traverse point and centerline of road.

N

1) I.C.R.P. N $\frac{1}{2}$ T S/S P.P. SE 55.7'2) I.C.R.P. N $\frac{1}{2}$ T. W/S Cor. Post SW 48.9'

3) TOP CENTER - UNDERGROUND CABLE BOX N. 13.8'

TP 2079

14.96'
4.9'
14.1'

FD. R.R. SPIKE 7.0'
N. OF COVERT $\frac{1}{2}$ 3.9'
E. OF RIDLEY $\frac{1}{2}$ ON
FENCE LINE NORTH;
.20' BELOW RD. SURFACE

 $\frac{1}{2}$ COVERTRd. $\frac{1}{2}$ RIDLEY RD.

3-20-78; Fld. Form No. 6

TRAVERSE POINT WITNESS REPORT

Traverse Point No. 2079

Tech. Sup'r. LARRY B

Company PAWNE

Field Squad #7 DAVID KOST


Township ANSONIA

Recorded
Corner
Code

Date 12-28-77

Sketch and describe roads, monuments found or set, and witness established:

1. S.S.W. 44.67 To Fence Post
2. N.E. 17.31 To Fence Post
3. E.S.E. 70.41 To Power Pole
4. E. 77.90 To S.W. CORNER ON House

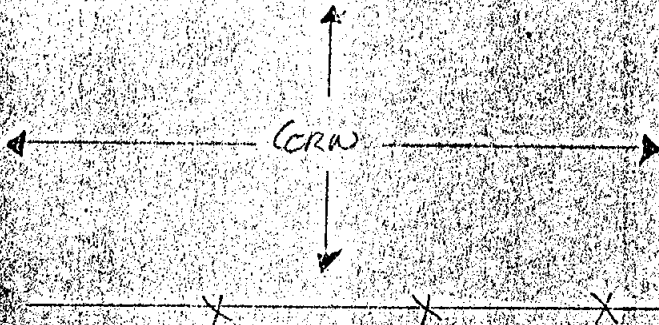

SET 1/2" BARY CAP

House
34946
COVERT

77.90



COVERT RD.

E

SIDLEY RD.

FENCE IS 11.0'
EAST OF TP

INGHAM COUNTY SURVEY and REMONUMENTATION PROJECT

Township LESLIE, T 1 N, R 1 W

Corner Code A-5

PAVED

Research Record:

	attachment number(s)	no. of sheets	researched by	reviewed by
Corner Recordation Certificate Liber <u>4</u> Page <u>277</u>	<u>0</u>		<u>LALONDE</u>	<u>J.M.</u>
Recorded Land Survey Liber Page	<u>N.D.</u>			<u>J.M.</u>
Recorded Subdivision Plat Liber Page	<u>N.D.</u>			<u>J.M.</u>
MDSHT Right-of-Way Maps Sheet No.	<u>N.D.</u>	<u>1</u>		<u>J.M.</u>
Ingham County Road Comm. Maps Sheet No. <u>8</u>	<u>1</u>	<u>1</u>		<u>J.M.</u>
Record of the Ingham County Surveyor Vol. <u>3</u> Page <u>135</u> Year <u>1878</u> <u>5</u> <u>1</u> <u>1899</u> <u>2</u> <u>246</u>	<u>2</u> <u>3</u> <u>N.D.</u>	<u>3</u> <u>3</u>		<u>J.M.</u>
General Land Office Maps Sheet No. <u>8</u>	<u>4</u>	<u>2</u>		<u>J.M.</u>
Form 280, Gov't. Monument Witness Record	<u>N.D.</u>			<u>J.M.</u>
Ingham County Drain Comm. File No.	<u>N.D.</u>			<u>J.M.</u>
East Lansing City Engineer	<u>N.D.</u>			<u>"</u>
Lansing Public Service Office Cade's 1921 Survey p.	<u>N.D.</u>			<u>"</u>
Lansing Public Service Office J.B. Davis' Field Notes p.	<u>N.D.</u>			<u>"</u>
G.L.O. Field Notes <u>P. 80</u>	<u>5</u>	<u>1</u>		<u>J.M.</u>
Misc. I.C. S. Notes <u>BK. 15 P. 102-103; BK. 16 P. 17</u>	<u>6/8</u>	<u>1/1</u>		<u>J.M.</u>
Field Recon. Form	<u>7</u>	<u>1</u>		<u>J.M.</u>
RESEARCH COMPLETED date	Total	Total		
Consumers Power Company Sheet No. Index No.	<u>N.D.</u>		<u>LALONDE</u>	<u>J.M.</u>
Chesapeake & Ohio Railroad Co. Val. Sec. Drawer Sheet	<u>N.D.</u>		<u>↓</u>	<u>"</u>
RESEARCH COMPLETED date	Total	Total		
REMARKS <u>NOTHING NOTES PAGE 1</u>	<u>9</u>	<u>1</u>	<u>MARTIN</u>	
<u>FOLDER #1 P. 13 & 35</u>	<u>10/11</u>	<u>1/1</u>	<u>↓</u>	
<u>FOLDER #2</u>	<u>N.D.</u>			

SOURCE: NOTES

TRANSCRIBED from ORIGINAL on file at REGIONAL OFFICE
DUPLICATE

TOWNSHIP: LESLIE
SECTION: 7

Point: A-5

Blue Pointed Stone (brick)

Jack Pine 7" ENE 76.7'

S.W. corner house N.E. 116.1'

Power pole S.E. 53.9'

[illegible]

INGHAM COUNTY SURVEY and REMONUMENTATION PROJECT

Township LESLIE, T 1 N, R 1W

Corner Code B-4

OFF ROAD

Research Record:	attachment number(s)	no. of sheets	researched by	reviewed by
Corner Recordation Certificate Liber <u>5</u> Page <u>29</u>	<u>0</u>	<u>1</u>	<u>LALONDE</u>	<u>MM</u>
Recorded Land Survey Liber Page				<u>MM</u>
Recorded Subdivision Plat Liber Page	<u>N.D.</u>			<u>MM</u>
MDSHT Right-of-Way Maps Sheet No.	<u>N.D.</u>			<u>MM</u>
Ingham County Road Comm. Maps Sheet No.	<u>N.D.</u>			<u>MM</u>
Record of the Ingham County Surveyor Vol. <u>5</u> Page <u>1</u> Year <u>1899</u> <u>4</u> <u>10</u> <u>1843</u>	<u>1</u> <u>N.D. - 2</u>	<u>3</u> <u>1</u>		<u>MM</u>
General Land Office Maps Sheet No. <u>8</u>	<u>3</u>	<u>1</u>		<u>MM</u>
Form 280, Gov't. Monument Witness Record	<u>N.D.</u>			<u>MM</u>
Ingham County Drain Comm. File No. <u>179</u>	<u>4</u>	<u>2</u>		<u>MM</u>
East Lansing City Engineer	<u>N.D.</u>			<u>MM</u>
Lansing Public Service Office Cade's 1921 Survey p.	<u>N.D.</u>			<u>MM</u>
Lansing Public Service Office J.B. Davis' Field Notes p.	<u>N.D.</u>			<u>MM</u>
G.L.O. Field Notes	<u>N.D.</u>			<u>MM</u>
Misc. I.C. S. Notes <u>BK. 15 P. 102-103</u>	<u>5</u>	<u>1</u>		<u>MM</u>
Field Recon. Form	<u>N.D.</u>			<u>MM</u>
RESEARCH COMPLETED date	Total	Total		
Consumers Power Company Sheet No. Index No.	<u>N.D.</u>		<u>LALONDE</u>	<u>MM</u>
Chesapeake & Ohio Railroad Co. Val. Sec. Drawer Sheet	<u>N.D.</u>			<u>MM</u>
RESEARCH COMPLETED date	Total	Total		
REMARKS <u>NOTHING NOTES</u>	<u>N.D.</u>		<u>MARTIN</u>	
<u>FOLDER #1 P. 13</u>	<u>6</u>	<u>1</u>		
<u>FOLDER #2</u>	<u>N.D.</u>			

TRANSCRIBED from ~~ORIGINAL~~ on file at REMONUMENTATION OFFICE
DUPLICATE

SURVEY OF HAINES DRAIN.

Survey of Haines Drain, located upon section 24, Town 1 north, Range 2 west (Onondaga township, Ingham county) and sections 7, 18, and 19, Town 1 north, Range 1 west (Leslie, Ingham county) Meridian of Michigan, and described as follows, to wit:

Commencing at the outlet of said Drain in the East Onondaga Drain, upon the south one-half (1/2) of northeast one-fourth (1/4) of said Section 24, George C. Ramsey and Lottie Ramsey, joint owners, at a point 1.88 chains east and 35 links south of the northwest corner of said land, thence north 82° 1/2' e 59 links to the north line of said land, at a point 2.42 chains east of the northwest corner thereof.

Thence north 89° 1/2' e upon the line between the above described land, owned by George C. and Lottie Ramsey, and the north one-half (1/2) of the northeast one-fourth (1/4) of said section 24, Ervin Johnson owner, 8.48 chains.

Thence wholly upon the last above described land, owned by Ervin Johnson, north 49° 1/2' e 3.44 chains, thence a 87° 1/2' e 1.52 chains, thence south 75° 1/2' e 1.90 chains, thence south 87° 1/2' e 2.46 chains, to the south line of said land at a point 18.51 chains east of the southwest corner thereof. Total length of drain wholly upon said land is 9.32 chains.

Thence upon the aforesaid south one-half (1/2) of the northeast one-fourth (1/4) of Section 24, George C. Ramsey and Lottie Ramsey, joint owners, south 47° 1/2' e 9.31 chains, thence south 75° 1/2' e 3.67 chains, thence north 44° 1/2' e 3.34 chains, thence north 48° 1/2' e 1.72 chains, thence south 83° 1/2' e 5.60 chains, thence south 89° 1/2' e 42 links to the east line of said land and range line at a point 6.64 chains south of the northeast corner of said land. Total length of drain wholly upon said land is 24.08 chains.

Thence upon the west fractional one-half (1/2) of the northwest fractional one-fourth (1/4) of said Section 19, less a parcel 80 rods east and west by 20 rods north and south out of the northwest corner thereof, Charles W. Harlow, owner. South 26° 1/2' e 27 links, thence north 47° e 4.79 chains, thence north 68° 1/2' e 16.52 chains to a point of curve, thence curve to the left (radius 1.33 chs) 2.12 chs, thence north 3.58 chs, thence north 22° w 7.48 chains, thence north 2.11 chains to the north line of said land and section line at a point 2.77 chains west of the northeast corner of said land. Total length of drain upon said land is 34.43 chs.

Thence upon the west fractional one-half (1/2) of the southwest fractional one-fourth (1/4) of said Section 18, Marion J. Jones, owner. North 21 links, thence north 89° 1/2' e 2.77 chains to the east line of said land at a point 25 links north of the southeast corner thereof. Total length of drain upon said land is 2.93 chains.

Thence upon the west one-half (1/2) of east one-half (1/2) of southwest fractional one-fourth (1/4) of said Section 18, Aaron J. Rayner owner. North 89° 1/2' e 92 links to point of curve, thence curve to the left (radius 65 links) 1.02 chains to point of tangent, thence north 44° 1/2' e 6.50 chains, thence north 48° 1/2' e 2.23 chains, thence north 89° 1/2' e 4.70 chains, thence north 31° 1/2' e 6.21 chains, thence north 60° 1/2' e 2.77 chains to the east line of said land at a point 21.19 chains south of the north-east corner thereof. Total length of drain wholly upon said land is 22.83 chains.

Thence north 1/4° w upon the line between the last above described land owned by Aaron J. Rayner and the east one-fourth (1/4) of southwest fractional one-fourth (1/4) of said section 18, George P. Faught owner, 11.57 chains to a point 8.82 chains south of the east and west quarter line of said Section 18.

Thence wholly upon the last above described land, owned by George P. Faught. North 29° e 4.46 chs, thence north 1/4° w 4.07 chains to the north line of said land at a point 1.12 chains east of the northwest corner thereof. Total length of drain wholly upon said land is 10.48 chains.

Thence west upon the line between the last above described land, owned by George P. Faught, and the east one-half (1/2) of the northwest fractional one-fourth (1/4) of said section 18, Norman F. Haines, owner, 1.12 chains to the northwest corner of the aforesaid land owned by George P. Faught. Total length of drain upon boundary lines of the aforesaid land owned by George P. Faught is 12.49 chains.

Thence west upon the line between the last above described land owned by Norman F. Haines and the aforesaid west one-half (1/2) of the east one-half (1/2) of southwest fractional one-fourth (1/4) of section 18, Aaron J. Rayner, owner, 9.43 chains, to a point of curve 50 links east of the west line of said lands. Total length of drain upon boundary lines of the aforesaid land owned by Aaron J. Rayner is 20.91 chains.

Thence curve to the right (radius 100 links)

wholly upon the aforesaid land owned by Norman F. Haines 1.57 chains to the west line of said land at a point 100 links north of the southwest corner thereof.

Thence north 1/4° w upon the line between the aforesaid land owned by Norman F. Haines and the southwest fractional one-fourth (1/4) of north-west fractional one-fourth (1/4) of said section 18, Louie Darrow, owner, 18.90 chains. Total length of drain upon boundary lines of the aforesaid land owned by Norman F. Haines is 29.03 chs.

Thence wholly upon the aforesaid east one-half (1/2) of the northwest fractional one-fourth (1/4) of said section 18, Norman F. Haines, owner, north 44° e 8.30 chs, thence north 1/4° e 18.29 chs to the north line of said land and section line at a point 4.08 chs east of the northwest corner of said land. Total length of drain wholly upon said land is 23.16 chs.

Thence upon the east one-half (1/2) of southwest fractional one-fourth (1/4) of said Section 7, Newell VanAuker, owner, north 1/4° e 30 links, thence north 23° 1/2' w 8.45 chs, thence north 1/4° e 2.17 chs, thence north 40° 1/2' w 6 links to the west line of said land at a point 10.18 chs north of the southwest corner thereof.

Thence upon the east 40 acres of the west fractional one-half (1/2) of southwest fractional one-fourth (1/4) of said Section 7, less a parcel of land 40 rods north and south by 20 rods east and west out of the southeast corner thereof, Archie I. Gibbs, owner. north 40° 1/2' w 3.17 chs, thence north 64° w 3.34 chs, thence north 1/4° e 2.04 chs, thence north 56° 5-8" e 5.59 chs, thence north 87° 1/2' e 30 links to the east line of said land at a point 19.13 chains north of the south line of said Section 7. Total length of drain upon said land is 14.44 chs.

Thence upon the aforesaid east one-half (1/2) of the southwest fractional one-fourth (1/4) of said Section 7, Newell VanAuker, owner, north 8° 1/2' e 9.39 chs, thence north 54° 1/2' e 3.34 chs, thence north 43° e 95 links, thence north 3° e 1.33 chs, thence north 61° e 6.12 chs, thence north 6-8" e 6.11 chs to the upper end of said drain upon said land at a point 23.81 chs west and 2.84 chs south of the interior quarter corner of said Section 7. Total length of drain upon said land is 7.87 chs. The total length of said drain is 2 miles 292 rods.

The line above described is the center line of said drain, and the excavations therefor are to be made in equal widths along each side of said center line. Said center line is marked by stakes at the beginning and end thereof, and at each angle and point of curve throughout the course thereof. Grade stakes and witness stakes are set at one side of said center line at the lower end of said drain at each two chains therefrom and at the upper end thereof. Said witness stakes are regularly numbered from the lower end of said drain on and to the upper end thereof.

Said drain is to be constructed with a bottom width of 1 1/2 feet from stake 0 to stake 50, and a bottom width of 1 foot from stake 50 to stake 116 1/2.

Said drain shall be constructed with banks each sloping outward 1 foot for each foot in the rise thereof.

Said drain shall be constructed with the following depths and grades:

Commencing at stake 0 (depth 4.42 feet); thence an ascending grade of .84 feet per 8 rods to stake 20 (depth 3.23 feet); thence a grade of .56 feet per 8 rods to stake 30 (depth 3.34 feet); thence a grade of .13 feet per 8 rods to stake 40 (depth 3.22 feet); thence a grade of .56 feet per 8 rods to stake 45 (depth 3.91 ft); thence a grade of .23 ft per 8 rods to stake 60 (depth 4.31 ft); thence a grade of .55 ft per 8 rods to stake 75 (depth 4.12 ft); thence a grade of .12 ft per 8 rods to stake 80 (depth 3.47 ft); thence a grade of .10 ft per 8 rods to stake 90 (depth 3.32 ft); thence a grade of .55 ft per 8 rods to stake 94 (depth 4.21 ft); thence a grade of .10 ft per 8 rods to stake 103 (depth 4.36 ft); thence a grade of 3.40 feet to stake 108 (depth 3.84 ft); thence a grade of .20 ft per 8 rods to stake 116 1/2 (depth 4.07 ft).

The total fall to said drain is 43.9 ft. The average depth of said drain is 4.04 ft.

The right of way for said drain shall be deemed to include the bottom width, depth, grade and slope of said drain as shown in the foregoing survey, together with a strip of land 33 feet in width along each side of and next adjoining the above described center line for the entire length of said drain, to be used for placing thereon the earth excavated from said drain, or for any other purpose necessary in constructing and maintaining said drain.

Surveyed December 4, 5, 7 and 8th, A. D. 1901. Computed, planned and described January 7 and 8, A. D. 1904.

E. A. GALKIN, Surveyor.

B-4
SEE PAGE

SOURCE: CO. DRAIN COMMISSION

File # 179

TRANSCRIBED from ORIGINAL
DUPLICATE on file at REMONUMENTATION OFFICE


Thence upon the aforesaid east one half ($\frac{1}{2}$) of the southwest fractional one fourth ($\frac{1}{4}$) of said section 7, Newell VanAuker, owner, north $87\frac{1}{2}^{\circ}$ east 4.39 chs., thence north $54\frac{2}{3}^{\circ}$ east 3.26 chs., thence north 43° east 95 links, thence north 3° east 4.82 chs., thence north 61° east 5.12 chs., thence north $5-6^{\circ}$ east 8.11 chs. to the upper end of said drain upon said land at a point 7.41 chs. west and 2.64 chs. south of the interior quarter post of said Section 7. Total length of drain upon said land is 37.83 chs.

RESISTANCE 35



82

	A	B	C	D	E	F	G	H	I	J	K	L	M
1	6	5	4	3	2								
2													
3													
4													
5													
6													
7													
8													
9													
10													
11													
12													
13													

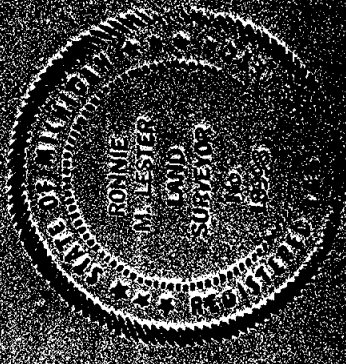

INGHAM COUNTY SURVEY and REMONUMENTATION PROJECT

Township LESLIE, T 1 N, R 1 W

Corner Code B-5

SAVED

Research Record:	attachment number(s)	no. of sheets	researched by	reviewed by
Corner Recordation Certificate Liber <u>5</u> Page <u>40</u>	<u>0</u>	<u>1</u>	<u>LALONDE</u>	<u>MM</u>
Recorded Land Survey Liber Page				<u>MM</u>
Recorded Subdivision Plat Liber Page	<u>N.D.</u>			<u>MM</u>
MDSHT Right-of-Way Maps Sheet No.	<u>N.D.</u>			<u>MM</u>
Ingham County Road Comm. Maps Sheet No. <u>8</u>	<u>1</u>	<u>1</u>		<u>MM</u>
Record of the Ingham County Surveyor Vol. <u>3</u> Page <u>135</u> Year <u>1878</u> <u>5</u> <u>1</u> <u>1899</u> <u>2</u> <u>246</u>	<u>2</u> <u>3</u> <u>N D</u>	<u>3</u> <u>3</u>		<u>MM</u>
General Land Office Maps Sheet No. <u>8</u>	<u>4</u>	<u>2</u>		<u>MM</u>
Form 280, Gov't. Monument Witness Record	<u>N.D.</u>			<u>MM</u>
Ingham County Drain Comm. File No.	<u>N.D.</u>			<u>MM</u>
East Lansing City Engineer	<u>N.D.</u>			<u>MM</u>
Lansing Public Service Office Cade's 1921 Survey p.	<u>N.D.</u>			<u>MM</u>
Lansing Public Service Office J.B. Davis' Field Notes p.	<u>N.D.</u>			<u>MM</u>
G.L.O. Field Notes <u>P.80</u>	<u>5</u>	<u>1</u>		<u>MM</u>
Misc. I.C. S. Notes <u>Bk. 15 P. 102-103</u>	<u>6</u>	<u>1</u>		<u>MM</u>
Field Recon. Form	<u>7</u>	<u>1</u>		<u>MM</u>
RESEARCH COMPLETED	Total	Total		
Consumers Power Company Sheet No. Index No.	<u>N.D.</u>		<u>LALONDE</u>	<u>MM</u>
Chesapeake & Ohio Railroad Co. Val. Sec. Drawer Sheet	<u>N.D.</u>		<u>↓</u>	<u>MM</u>
RESEARCH COMPLETED	Total	Total		
REMARKS				
<u>NOTHSTINE NOTES P. 4</u>	<u>8</u>	<u>1</u>	<u>MARTIN</u>	
<u>FOLDER #1 P. 13 & 35</u>	<u>9/10</u>	<u>1/1</u>		
<u>FOLDER #2</u>	<u>N O</u>			

SOURCE: PRELIMINARY FIELD INSPECTION

TRANSCRIBED from ORIGINAL
DUPLICATE on file at REMONUMENTATION OFFICE

PRELIMINARY CORNER FIELD INSPECTION

Date 3 NOV 77 CORNER
CODE B-5

Team C. G. G. + TWP LESLIE

FELIX Corner: ~~RECORDED~~
UNRECORDED

Road Name COVERT 1/2 MILE W OF 7046E

Road Surface: CONCRETE ASPHALT GRAVEL OTHER: _____

FILL CUT Section

VISIBLE MONUMENT EVIDENCE: _____ Monument Box

_____ Pipe

_____ Iron Bar

_____ Nail

_____ Other: _____

☒ No Evidence Visible

MONUMENT LOCATION (Relative to centerline of road)

Remarks:

TOWNSHIP LESLIE

CORNER CODE B-5

PAGE 1 OF 1 DATE 9-19-78

EXCAVATED AREA: 6 x 10' SQ. FT.; AVG. DEPTH 3.0' SURFACE ASPHALT

Sketch and describe roads, monuments found or set, and witnesses established:


N EXCAVATION COMPLETED AS PLANNED. RESULTS NEGATIVE.
EXCAVATION CENTERED 2.3' EAST OF TP 3103.

4"	ASPHALT
6"	GRAVEL
3"	ASPHALT
23"	SAND

T.P. IS DUE NORTH OF
W. EDGE OF EXC.

9/27/78

G. Hollon

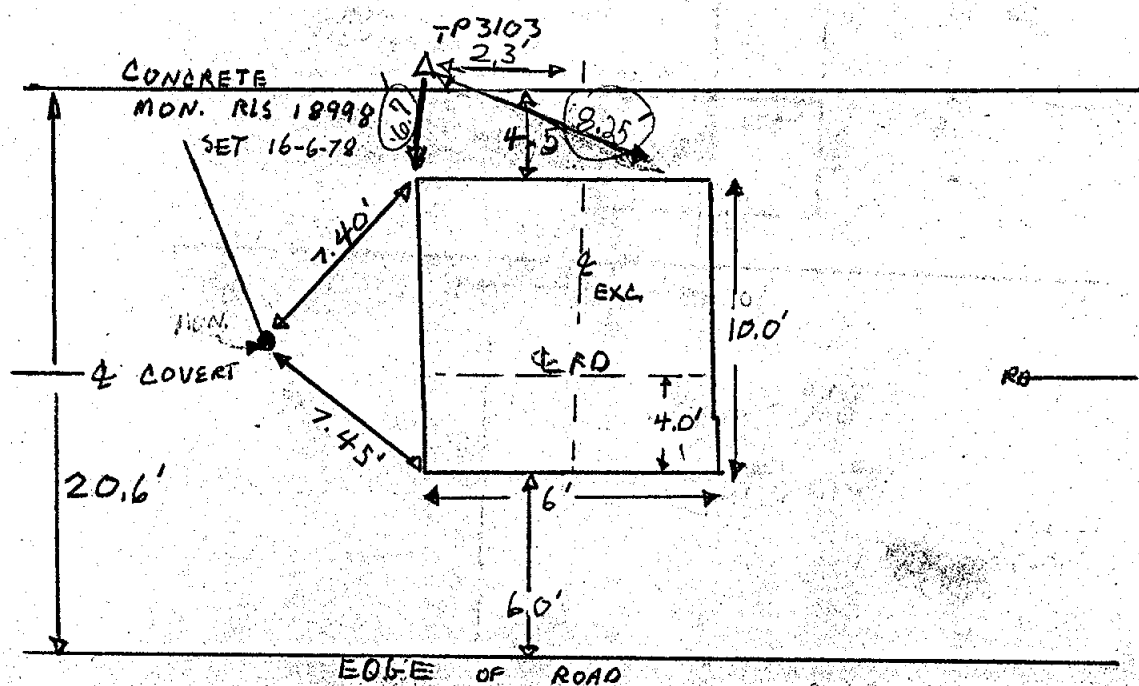

3-20-78; Fld. Form No.

TECH. SUP'R. L. BRYAN TOWNSHIP Leslie
COMPANY POLARIS CORNER CODE B-5
FIELD SQUAD GENEVAUX #4 PAGE 1 OF 1 DATE 6-19-78


EXCAVATED AREA: 2 Holes - 10' x 2' each SQ. FT.; AVG. DEPTH 2' SURFACE ASPHALT

Sketch and describe roads, monuments found or set, and witnesses established:

N
EXCAVATED east & west edge of site excavated
by Carlice - 6-16-78
Found no additional evidence

GOOD CORNER. MONUMENT SET
AT 11' BOLT AS CALLED FOR IN ATTACH #1 & 2
L. BRYAN

SET MON. BOX over
MONUMENT SET 6-16-78

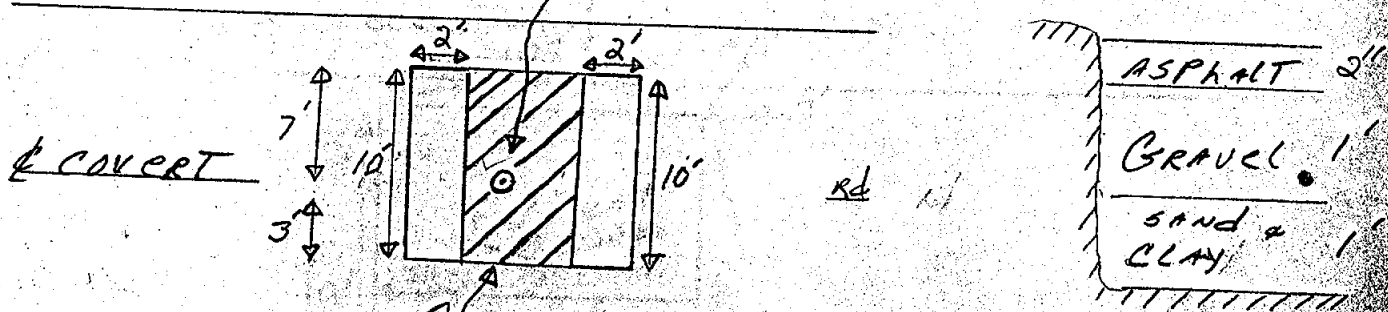

NOTE: shaded area excavated
by Carlice - 6-16-78

OVER →

TECH. SUP'R. L. RYAN TOWNSHIP LESLIE
COMPANY POLARIS CORNER CODE B-5
FIELD SQUAD #4 MARTIN ROAD NAME COVERT / ASPHALT

Sketch, witness, and describe monuments found and proposed excavation site relative to traverse point and centerline of road.


N
BEGIN EXCAVATION AT A POINT 2.1' EAST OF
TP 3103 AND 8.0' EAST OF CONC. MON. W/ CAP
RLS # 18998 IN E.

100 YR. FENCE

TP 3103
A 2.1'

CONCRETE
MONUMENT
RLS # 18998

E COVERT

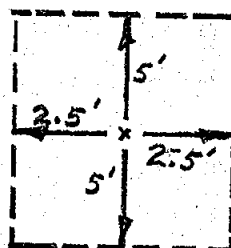

RD.

8.0'

100 YR. FENCE

9-5-78
6" ASPHALT

Charlie


TECH. SUP'R. L. RYAN TOWNSHIP LESLIE
COMPANY POLARIS CORNER CODE B-5
FIELD SQUAD #5. CARLICE RECORDED CORNER P
DATE 16 JUNE 1978 ROAD NAME COVERT

Sketch, witness, and describe monuments found, and location relative to traverse point and centerline of road.

N FD 1x15" IRON BOLT IN SAND TO FOLLOWING WITNESSES:

- 57.91 1. N+T RIS#18998, N/S 15" MAPLE, S60°W, 57.95'
66.16 2. N+T RIS#18998, N/S 38" MAPLE, S45E, 67.00'
44.45 3. N+T RIS#18998, ~~E/S~~ ^{N/S} 8" PINE, N15W, 44.51'
92.14 4. N+T RIS#18998, N/S 22" MAPLE, S46E 92.13'

NOTE: SET MON. BOX OVER
MONUMENT 6-19-78
G. GENECAUX

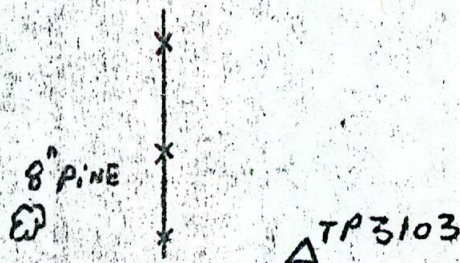

OK
CE

COVERT

○ SET
CONCRETE
MONUMENT

RD



TECH. SUP'R. L. BRYAN

TOWNSHIP LESLIE

COMPANY POLARIS

CORNER CODE B-5

FIELD SQUAD #5. CARLICE

RECORDED CORNER 1

DATE 16 JUNE 1978

ROAD NAME COVERT

Sketch, witness, and describe monuments found, and location relative to traverse point and centerline of road.

N FD 1X15" IRON Bolt in sand to following witnesses:

1. N+T RLS #18998, N/S 15" MAPLE, S60°W, 57.90'

2. N+T RLS #18998, N/S 38" MAPLE, S45E, 66.98'

3. N+T RLS #18998, E/S 8" PINE, N15W, 44.46'

4. N+T RLS #18998, N/S 22" MAPLE, S46E 92.17'

Note: Set mon. box over

Monument 6-19-78

G. GENECAUX

8" PINE
E

Δ TP 3103

COVERT

○ SET
CONCRETE
MONUMENT

RD

15"
MAPLE

38"
MAPLE

22"

3-20-78; Fld. Form No. 6

TECH. SUP'R. L. BRYAN

TOWNSHIP LESLIE

COMPANY POLARIS

CORNER CODE B-5



FIELD SQUAD # 9 MINCH - MARTIN ROAD NAME COVERT / ASPHALT

Sketch, witness, and describe monuments found and proposed excavation site relative to traverse point and centerline of road.




BEGIN EXCAVATION AT A POINT 5.6' WEST OF TP 3103 & ON FENCE LINES TO NORTH & SOUTH.

SEE MON. COR. REPORT FOR WITNESSES.

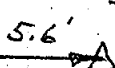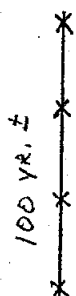

excavate as shown
100' for stone
approach #3
RL


E COVERT

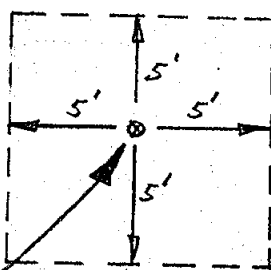

6-13-78
3" Blacktop

Ro


FD. BOATSPIKE 2' NORTH OF E ON FENCE LINE N. & S.

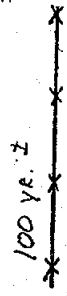

TECH. SUP'R. L. BRYANTOWNSHIP LESLIECOMPANY POLARISCORNER CODE R-5FIELD SQUAD #9 MINCH - MARTINRECORDED CORNER NoDATE 4-27-78ROAD NAME COVERT

Sketch, witness, and describe monuments found, and location relative to traverse point and centerline of road.

- N
- 1) I.C.R.A. N+T N/S 2" MAPLE S 60°W 59.3'
 - 2) I.C.R.A. N+T NE/S 38" MAPLE S 45°E 66.85'
 - 3) TP 3103 N 30°E 12.2'

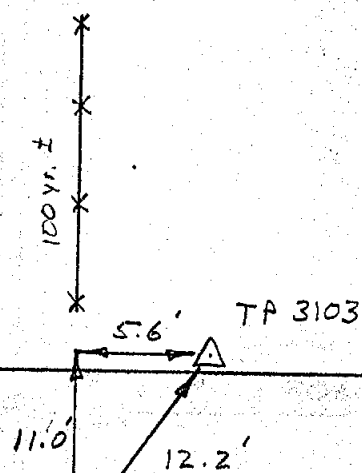E COVERTRd.

FD. BOATSPIKE 2' NORTH OF E
ON FENCE LINES N. & S.
• BOATSPIKE FALLS INTO E
800' ± W.

3-20-78: Fld. Form No. 6

TRAVERSE POINT WITNESS REPORT

Traverse Point No. 3103

Tech. Sup'r. LARRY B

Township LELIE

Company POLARIS

Recorded

Corner

Code

Field Squad #7 DAVE & CHRIS

Date JAN 25 78


Sketch and describe roads, monuments found or set, and witness established:

1 SET NAIL + TAG ON N.E. SIDE OF 40 IN SYCAMORE S.W. 68.94

2 " " " E. SIDE OF FENCE POST S.S.W. 42.97

3 " " " N.E. SIDE OF 100 IN SYCAMORE S.E. 62.20

100 OF EDGE OF RD. IS T.P.

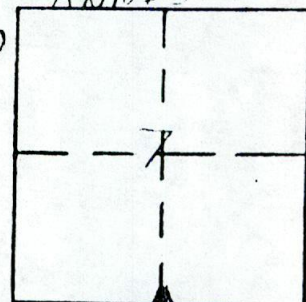

COVERT

CORN

PINE
TREES

SWAMP

SET 1/2" IRON ROD W/C

13.00

E COVERT RD.

E RD.

TREE

ROW 1

CORN

BARBED WIRE FENCE
+ SQUARE LINE

SWER
INES

SOURCE: CO. ROAD COMMISSION MAPS

Sh. # 8

TRANSCRIBED from ORIGINAL//
DUPLICATE on file at REMONUMENTATION OFFICE

B-5 1" Bolt

Anch. post N. 27.3'

Anch. post S. 29.4'

LESLIE


township

T 1 N, R 1 EW

B-5

corner code attachment no. 1

p. 1 of 1

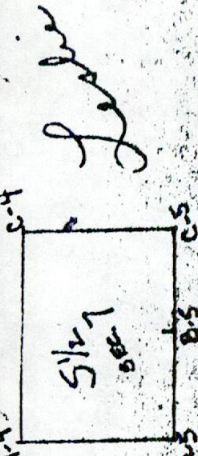

103
ing E 1/4 line and de-
termining center of sec for.
See ch 10 N 1/2 W 3/4
Cheney S 1/4 E 1/4 post - S 89 1/2°
W. 80.6 ch to 1/4 post - 1/4 H
After running the 1/4 S 1/4
line and determining the
center of the section post
we are 82.1 on this line for
lot post and also S 1/4
set post the E 1/4 a 7 and 1/4
12 1/2 S 1/4 W 1/4 sec 7 Post -
not with witness taken
in 1900 set - words B
mark post. 2 1/4 E 1/4 W 1/4
40 1/2 1/4 in S E corner of
1/4 S 1/4 W 1/4 sec 7 + post
each 500 ch on all four
lines except E 1/4 W 1/4
line - 10.00. Below
hereby certify that
on Jan 16 1930 days
before 1899 I purchased
the established the corners
and made the witness
as were given
W. H. Pringle as surveyor

102
Sec. 7 Leslie
Surveyed Oct-16 & 80 1899
for N. Van Curen & others.
N. Van Curen & Swain
W. H. Pringle & Swain
Corner set - S 1/4 post - see 7 C.P.H.
9 1/2 W. 1/4 sec 7 line stone set - 1/4
W. 1/4 1/4 S 1/4 W 1/4 59 1/2 & 1/4
with 33 1/2
Thence S 89 1/2° W 1/4 S 1/4 cor A-B
sec. Stone found 14 1/2
north of line found stone
New Plumber 17 1/4 S 1/4 E 1/4 69 1/2
Bottom set 8 3/4 1/4 E 1/4 S 1/4 1/4 Butte
and 8 1/4 3/4 1/4 W. 1/4 1/4
As there was no 1000. surplus
in this line 2 set - lot - post -
at 1/2 distance 2009 1/2 east
of sec cor - a stone stone for
line 10 1/4 S 1/4 W 1/4 37 1/2 E 1/4
S 1/4 W 1/4 1/4 1/4. An sec line
500 ch west - from lot post
at - blue stone - corner for
form corner - New Plumber
110 1/4 S 1/4 E 1/4 59 1/2
also set - about 10.00 ch
west - of lot post - for form
corner
Thence back S 1/4 post -
and from there 17 1/4
along sec line 40.25 1/2 ch
along set - S E cor C.P.H. & 1/4
back on line 20.12 1/4 ch set -
lot post a stone with witness
100.00. Day 4 E - E. 56 1/2. Day
48 - SW 1/4 1/4 1/2
Thence N 1/4 W 1/4 40.31 ch
to NE cor W 1/4 S 1/4 sec 7 where

SOURCE:

NOTES

TRANSCRIBED from ORIGINAL on file at REMON. OFFICE
DUPLICATE


TOWNSHIP: LESLIE
SECTION: 7

Point: B-5

1" Bolt

Anchor post N 27.3'

Anchor post S 29.4'

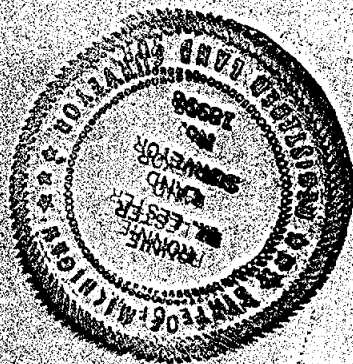

1	2	3	4	5	6	7	8	9	10	11	12	13
A	1	2	3	4	5	6	7	8	9	10	11	12
B	1	2	3	4	5	6	7	8	9	10	11	12

73312 7M21W
217327 C4

TECH. SUP'R. J. B. TOWNSHIP Polaris
 COMPANY Polaris CORNER CODE C-4
 FIELD SQUAD L. Faust #6 RECORDED CORNER _____
 DATE 6-16-78 ROAD NAME Tuttle & Ingalls

Sketch, witness, and describe monuments found, and location relative to traverse point and centerline of road.

- 37.84 3786 N 1) FOUND N.T. (R.L.S. #12034) ON S.E. side FENCE CORNER Post N.68E
 61.99 6199 2) Set N.T. (R.L.S. #18998) ON S.E. side 8" DIA Ash N.70°E.
 46.73 4673 3) FOUND N.T. (R.L.S. #12034) ON W. side FENCE CORNER Post S.30°E.
 57.29 5729 4) FOUND N.T. (R.L.S. #12034) ON N.W. side 30" DIA Maple N.60°W.
 86.68 8670 5) FOUND N.T. (R.L.S. #12034) ON N.W. side 30" DIA Maple N.40°W.
 NEEDS NEW RLS #18998 YELLOW CAP


CHECKED WITNESSES
 8/15/78 C. EVERETT
 OK.

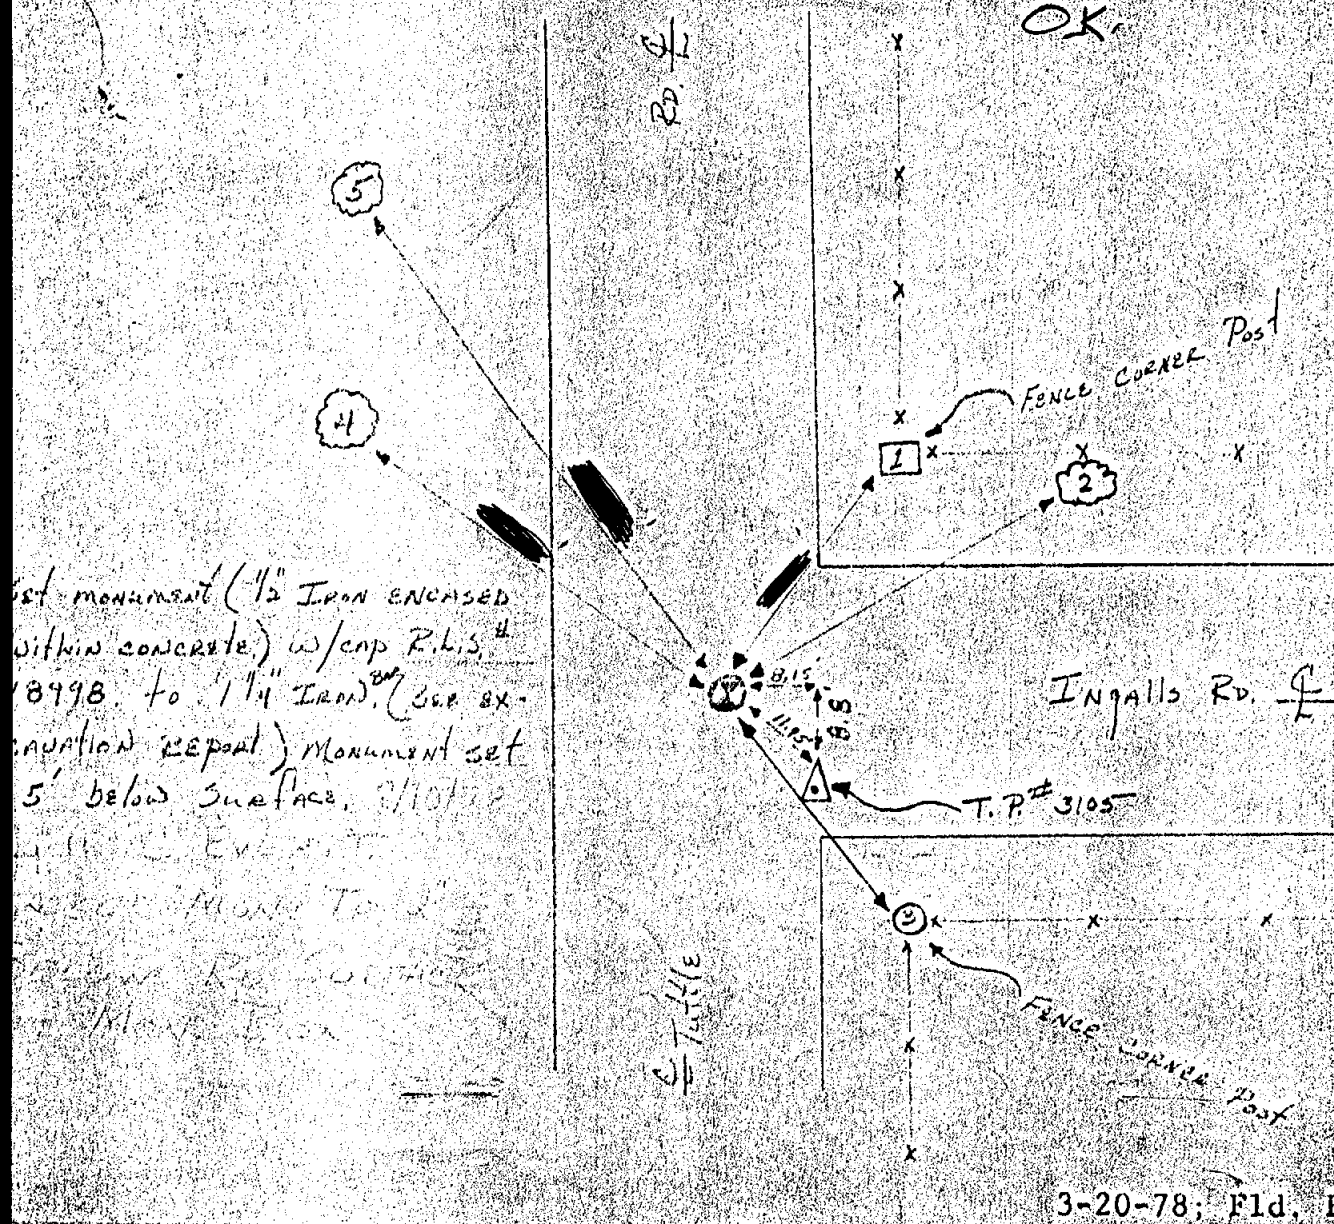

TECH. SUP'R. L.B. TOWNSHIP Leslie
 COMPANY Polaris CORNER CODE C-4
 FIELD SQUAD L. Faust #6 RECORDED CORNER _____
 DATE 6-16-78 ROAD NAME Tuttle & Ingalls

Sketch, witness, and describe monuments found, and location relative to traverse point and centerline of road.

- FINAL WITNESSES:**
- 1) FOUND N.T. (R.L.S. #12034) ON S.E. side FENCE CORNER Post N. °E. 37.86'
 - 2) Set N.T. (R.L.S. #18998) ON S.E. side 8" DIA Ash N. °E. 62.01'
 - 3) FOUND N.T. (R.L.S. #12034) ON W. side FENCE CORNER Post S. 30° E. 46.73'
 - 4) FOUND N.T. (R.L.S. #12034) ON N.W. side 32" DIA Maple N. 60° W. 57.31'
 - 5) FOUND N.T. (R.L.S. #12034) ON N.W. side 30" DIA Maple N. 40° W. 86.76'

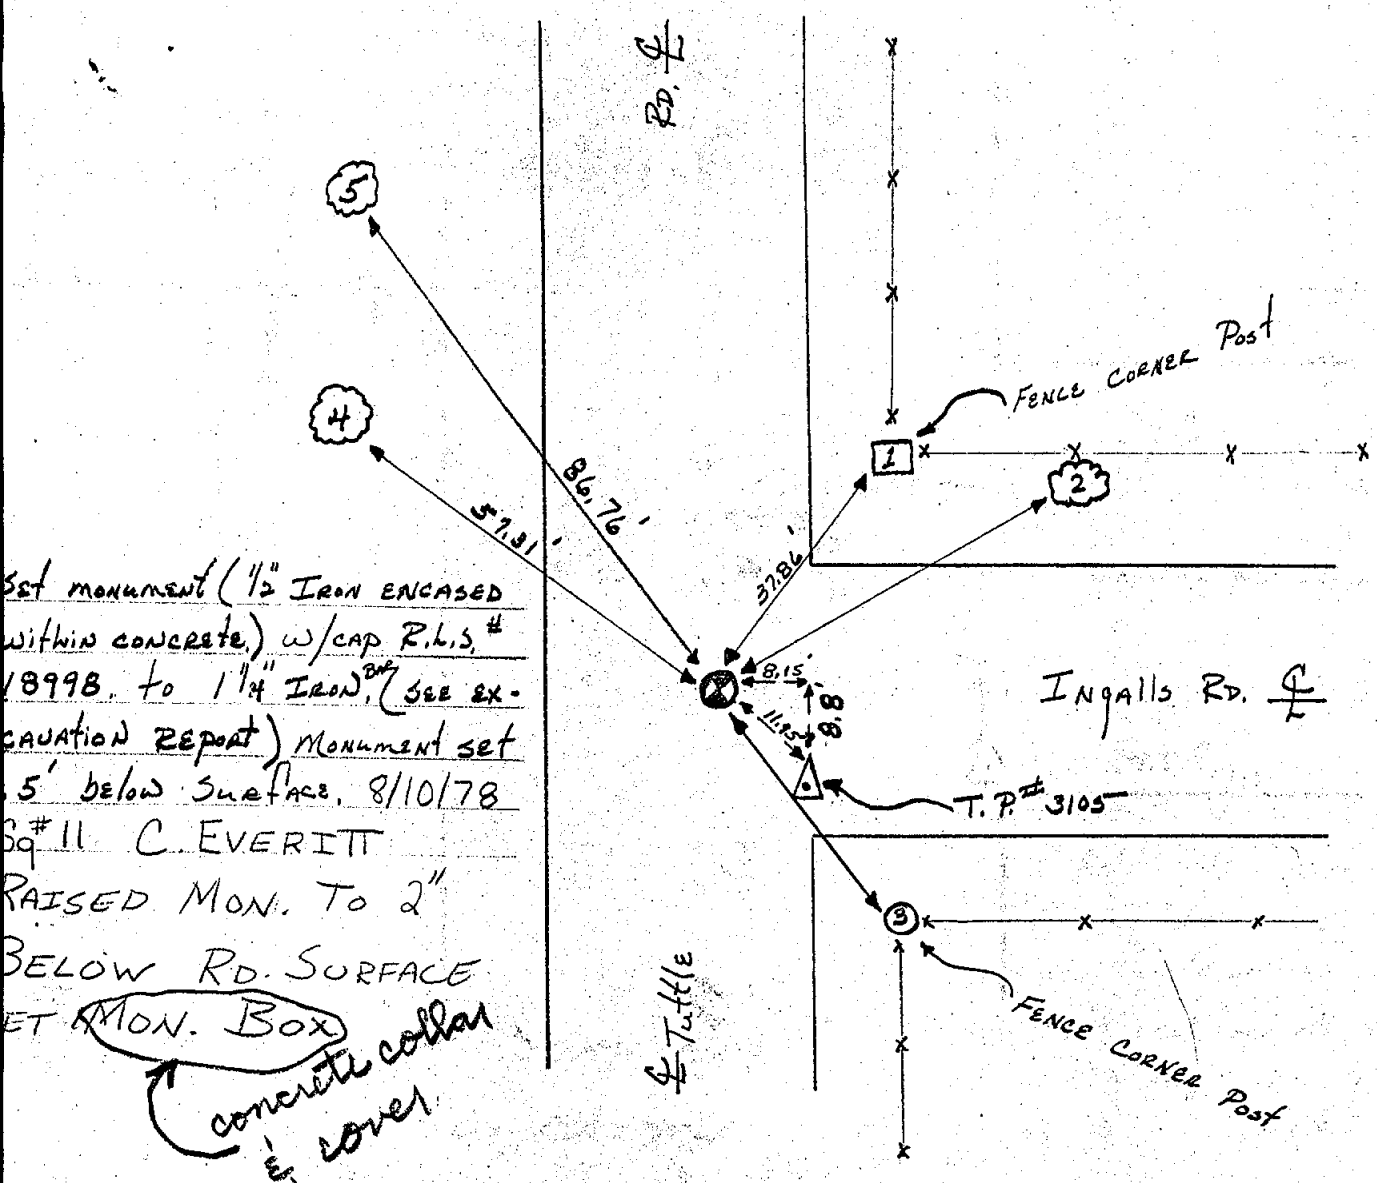


TECH. SUP'R. L. D. TOWNSHIP Leslie
COMPANY Polaris CORNER CODE C-4
FIELD SQUAD L. Faust #6 PAGE 1 OF 1 DATE 6-11-78
16

EXCAVATED AREA: 3.9 by 2.4' sq. 9.56 SQ. FT.; AVG. DEPTH 4.25' SURFACE Asphalt 9" thick

Sketch and describe roads, monuments found or set, and witnesses established:

N FOUND:

1 1/4" Sq. headed IRON BAR 6" Below surface surrounded by
RED BRICK AS CALLED FOR BY I.C.R.C. (NO DATE), NOTKISTINE NOTES
(NO DATE), & W.A. ROWE (1899). (SEE ATTACHMENTS #s 3, 8, & 10.
1 1/4" sq. headed IRON BAR WAS 3' IN LENGTH, AND LOCATED
IN OE OF TUTTLE & INGALLS RD. INTERSECTION.

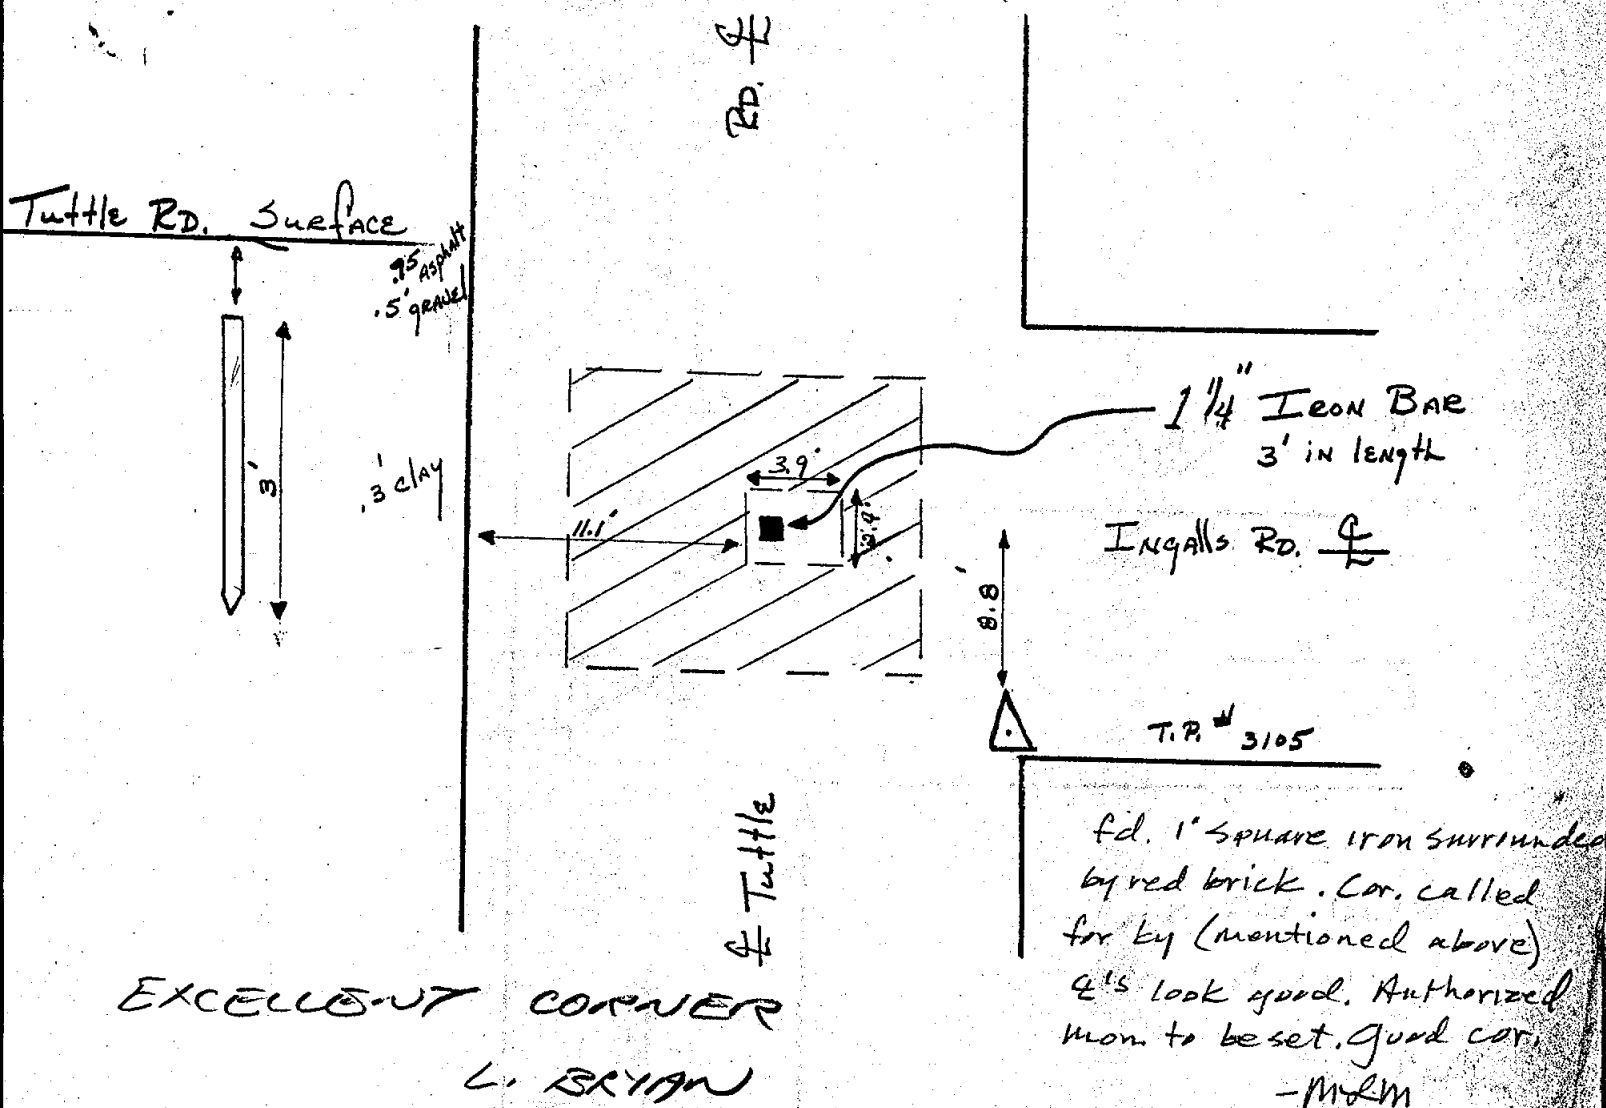

TECH. SUP'R. L. BRYAN

TOWNSHIP LESLIE

COMPANY POLARIS

CORNER CODE C-9

FIELD SQUAD #9 MINCH - MARTIN

ROAD NAME INTER: TUTTLE & INGALLS / ASPHALT

Sketch, witness, and describe monuments found and proposed excavation site relative to traverse point and centerline of road.


- N
- BEGIN EXCAVATION AT A POINT 8.7' NORTH OF TP 3105 1.0' EAST OF N & S E ON E TO THE EAST & ON FENCE LINE TO THE WEST.
 - SEE MON. COR. REPORT FOR WITNESSES
 - START AT FD. IRON

6-14-78

6" Blacktop
Charlie

excavate as
shown
look for witness
in attach #3
attach #8
attach #10

FD. 1 1/4" IRON BAR
1.0' EAST OF N & S E,
ON E EAST & FENCE
LINE WEST

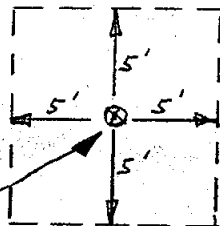

E INGALLS

8.7'
TP 3105

TUTTLE

LOOK FOR BRICK
around iron.


OK Mfm

TECH. SUP'R. L. BRYAN TOWNSHIP LESLIE
COMPANY POLARIS CORNER CODE C-4
FIELD SQUAD #9 MINCH - MARTIN RECORDED CORNER No
DATE 4-27-78 ROAD NAME INTER. TUTTLE & INGALLS

Sketch, witness, and describe monuments found, and location relative to traverse point and centerline of road.

- N
- 1) I.C.R.A. N $\frac{1}{2}$ T S/S 24" MAPLE NW 57.1'
 - 2) I.C.R.A. N $\frac{1}{2}$ T N/S COR. POST W. 37.5'
 - 3) TP 3105 SE 11.96'

FD. 1 $\frac{1}{4}$ " IRON ON
FENCE LINE WEST,
IN $\frac{1}{2}$ EAST $\frac{1}{2}$ 1.0'
EAST OF $\frac{1}{2}$ N $\frac{1}{2}$ S.

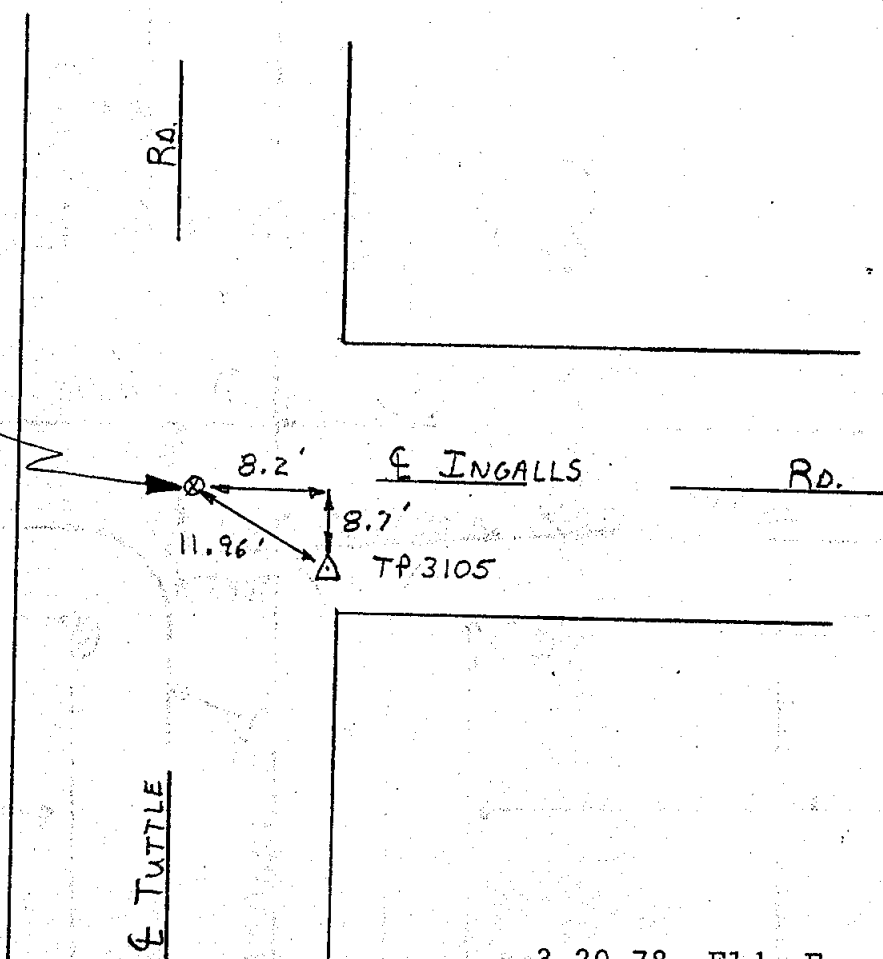

TRAVERSE POINT WITNESS REPORT

Traverse Point No. 3105

Tech. Sup'r. LARRY B

Company POLARTS

Field Squad #7 DAVE CHRIS

Township LESLIE

Recorded
Corner
Code

Date JAN 25 78

Sketch and describe roads, monuments found or set, and witness established:

1. SET NAIL + TAG ON E/SIDE OF PENCE POST W.W.N. 44.39






2. FOUND RLS. TAG 12034 ON PENCE POST S.E. 35.62

3. FOUND " " " " " " " " N.E. 38.50

4. SET NAIL + TAG ON S/SIDE OF OAK N.W. 68.78

IRON SET IN LINE WITH E. EDGE TUTTLE & S. EDGE OF INGALLS RD.

MOBILE HOME
3256

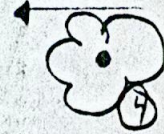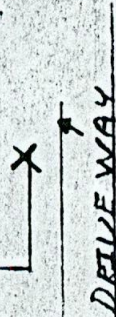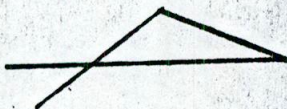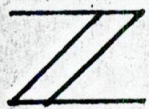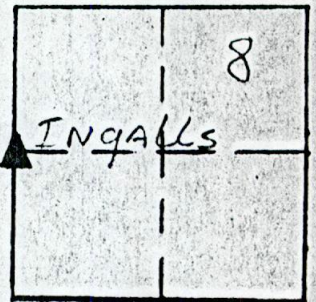

TUTTLE RD.

Both Rds.

SET 1/2" IRON ROD w/c

PASTURE

INGALLS RD.

CORN



INGHAM COUNTY SURVEY and REMONUMENTATION PROJECT

Township LESLIE, T 1 N, R 1W
 Corner Code C 4

Research Record:	attachment number(s)	no. of sheets	researched by	reviewed by
Corner Recordation Certificate Liber <u>4</u> Page <u>360</u>	<u>ND</u>	<u>1</u>	SAM- D.K.H.	DKH
Recorded Land Survey Liber Page	<u>ND</u>		"	DKH
Recorded Subdivision Plat Liber Page	<u>ND</u>		"	DKH
MDSHT Right-of-Way Maps Sheet No.	<u>ND</u>		"	"
Ingham County Road Comm. Maps Sheet No. <u>8</u>	<u>3</u>	<u>1</u>	<u>h</u>	DKH
Record of the Ingham County Surveyor Vol. <u>5</u> Page <u>1</u> Year <u>1899</u> <u>2</u> <u>199</u> ✓	<u>1</u> <u>7</u>	<u>3</u> <u>1</u>	<u>h</u> mm	DKH
General Land Office Maps Sheet No. <u>8</u>	<u>2</u>	<u>1</u>	<u>h</u>	DKH
Form 280, Gov't. Monument Witness Record	<u>ND</u>		.	DKH
Ingham County Drain Comm. File No.	<u>ND</u>		.	DKH
East Lansing City Engineer	<u>ND</u>		.	DKH
Lansing Public Service Office Cade's 1921 Survey p.	<u>ND</u>		.	DKH
Lansing Public Service Office J.B. Davis' Field Notes p.	<u>ND</u>		.	DKH
G.L.O. Field Notes P. <u>81</u>	<u>6</u>	<u>1</u>	<u>h</u>	DKH
Misc. I.C. S. Notes <u>BOOK 15</u> p. <u>103</u>	<u>5</u>	<u>1</u>	<u>h</u>	DKH
Field Recon. Form	<u>4</u>	<u>1</u>	<u>h</u>	DKH
RESEARCH COMPLETED date	Total	Total		
Consumers Power Company Sheet No. Index No.	<u>ND</u>		.	DKH
Chesapeake & Ohio Railroad Co. Val. Sec. Drawer Sheet	<u>ND</u>		.	DKH
RESEARCH COMPLETED date	Total	Total		
REMARKS <u>NOTHING NOTES P. 4</u>	<u>8</u>	<u>1</u>	<u>MARTIN</u>	
<u>FOLDER #1 PAGE 1-13</u>	<u>9/10</u>	<u>1/1</u>		
<u>PAGE 14-17</u>	<u>11/12</u>	<u>1/1</u>		
<u>FOLDER #2</u>	<u>ND</u>			

SOURCE

REGISTERED NOTES

TRANSCRIBED From ORIGINAL on file at REMON OFFICE
DUPLICATE

TOWNSHIP: , LESLIE
SECTION: 7

Point: C-4

Set $1-\frac{1}{4}$ sq. iron (brick)

Elm 30" N 13° 30' E 125.9'

Iron road sign post WNW 23.4'


Maple 10" N 58° W 57.4'

CORNER REPORT

TECH. SUP'R. L. BRYAN TOWNSHIP Co. 5 Lx
 COMPANY POLARIS CORNER CODE C-5
 FIELD SQUAD General RECORDED CORNER
 DATE 6-16-78 ROAD NAME COVERT & TUTTLE

Sketch, witness, and describe monuments found, and location relative to traverse point and centerline of road.


- N
- Fd. pointed Rock 1.5' x 0.8' with IRON stake
 Leaning against and over center of road
 Surrounded by small pieces of Red brick or Tile
 Replaced with monument witnessed as follows:
- 1) SET N 75° E side 36" sycamore N 75° E 129.75'
 - 2) SET N 75° E side P.P. 75 50° W 61.31'
 - 3) SET N 75° E side P.P. N 45° W 73.05'
 - 4) dent in E. Covert end N 20° W 67.70'
 - 5) dent in E. Covert end N 20° E 68.86'

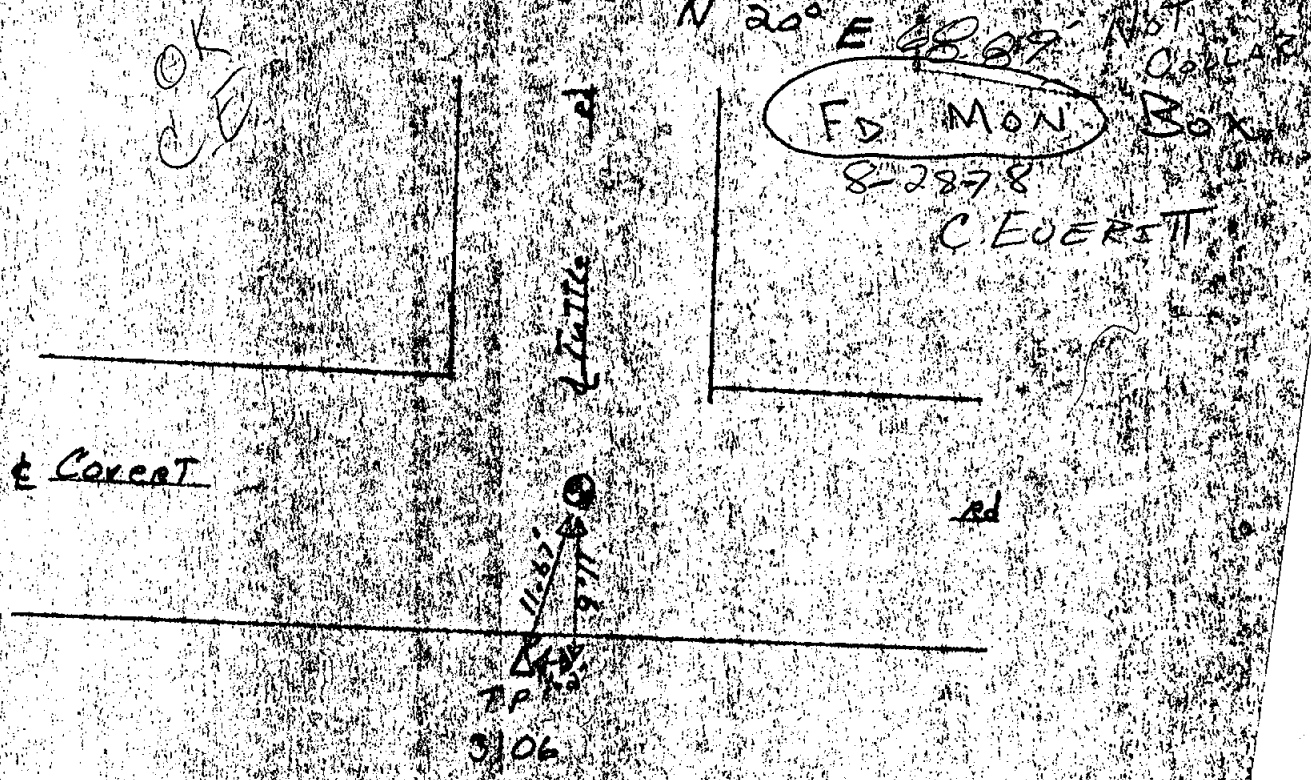

TECH. SUP'R. L. BRYAN TOWNSHIP Leslie
COMPANY POLARIS CORNER CODE C-5
FIELD SQUAD GENEVAUX RECORDED CORNER _____
DATE 6-16-78 ROAD NAME COVERT & Tuttle

Sketch, witness, and describe monuments found, and location relative to traverse point and centerline of road.

N
Pt. "C"
Fd. pointed Rock 1.5' x 0.8' with IRON stake
Leaning against and over center of rock
Surrounded by small pieces of Red brick or Tile
Replaced with monument witnessed as follows:
1) set N+T S.E. side 36" Sycamore N 75° E 129.72'
2) set N+T S side P.P. S 50° W 61.28'
3) set N+T N side PP N 45° W 73.03'
4) dent in & culvert end N 20° W 67.63'
5) dent in & culvert end N 20° E 68.80'

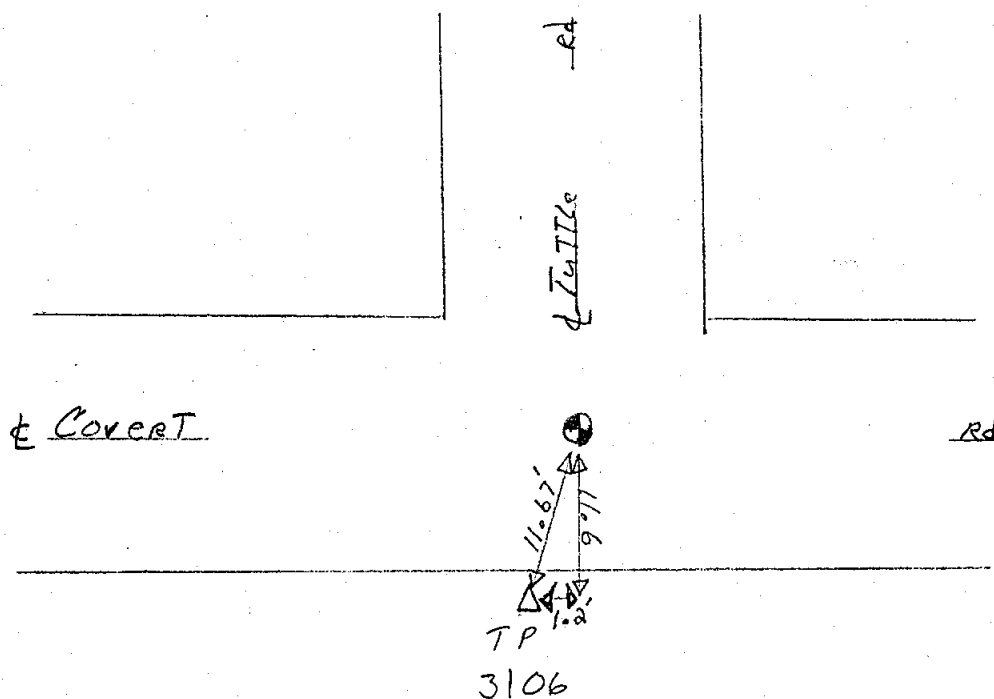

TECH. SUP'R. L. BRYAN TOWNSHIP Leslie
COMPANY POLARIS CORNER CODE C-5
FIELD SQUAD Genereaux #4 PAGE 1 OF 1 DATE 6-16-78

EXCAVATED AREA: 7 SQ. FT.; AVG. DEPTH 3' SURFACE Asphalt

Sketch and describe roads, monuments found or set, and witnesses established:

PT. "A" N Fd. boat spike in E of Covert & Tuttle Rd.
witnesses:

1) I.C.R.C. witness 36" sycamore N.E. 129.5'

2) South end of west head wall W.N.W. 60.74'

3) T.P. 3106 South 11.6'

PT "B" 3/4" sq. iron spike directly under PT "A" - 0.8' deep
witnesses: P.K. NE 7.39' P.K. SE 7.10'


Leaning against center and 0.10' above large pointed rock -

PT "C" Fd. large pointed rock with 0.5' long point
surrounded by pieces of red brick - 0.09' deep
witnesses: 1) P.K. N.E. 7.38' 2) P.K. S.E. 7.10'

PT "D" Fd. bent boat spike approx. 0.8' deep
1.6' W. and 0.4' N. of PT. "C"

2" ASPHALT
1' GRAVEL
1' CLAY & SAND

EXCELLENT
CORNER
L. BRYAN

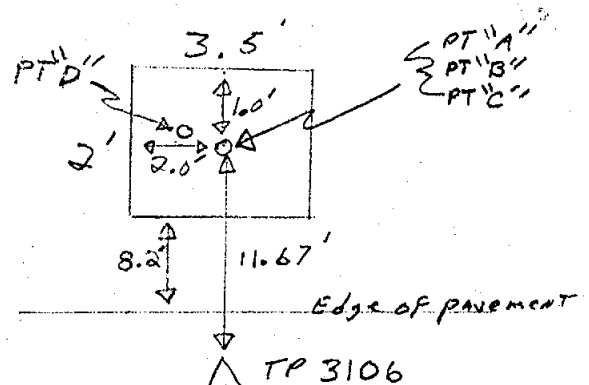

N.W. CORNER 12.6'
 N.E. CORNER 13.4'
 S.E. CORNER 11.7'
 S.W. CORNER 10.7'


Used T.P. 3106 as witness to corners of excavation

TECH. SUP'R. L. P. RYAN TOWNSHIP LESLIE
 COMPANY POINTEIS CORNER CODE C-5

FIELD SQUAD #9 MINCH - MARTIN ROAD NAME JOHN T. TUPPER & CO. / ACAPULCO

Sketch, witness, and describe monuments found and proposed excavation site relative to traverse point and centerline of road.


- BEGIN EXCAVATION AT A POINT 1.0' EAST OF TP 3106 ON E TO THE NORTH & .75' SOUTH OF E TO THE EAST & WEST AT FD. BOATSPIRE.
- SEE MON. COR. REPORT FOR WITNESSES.

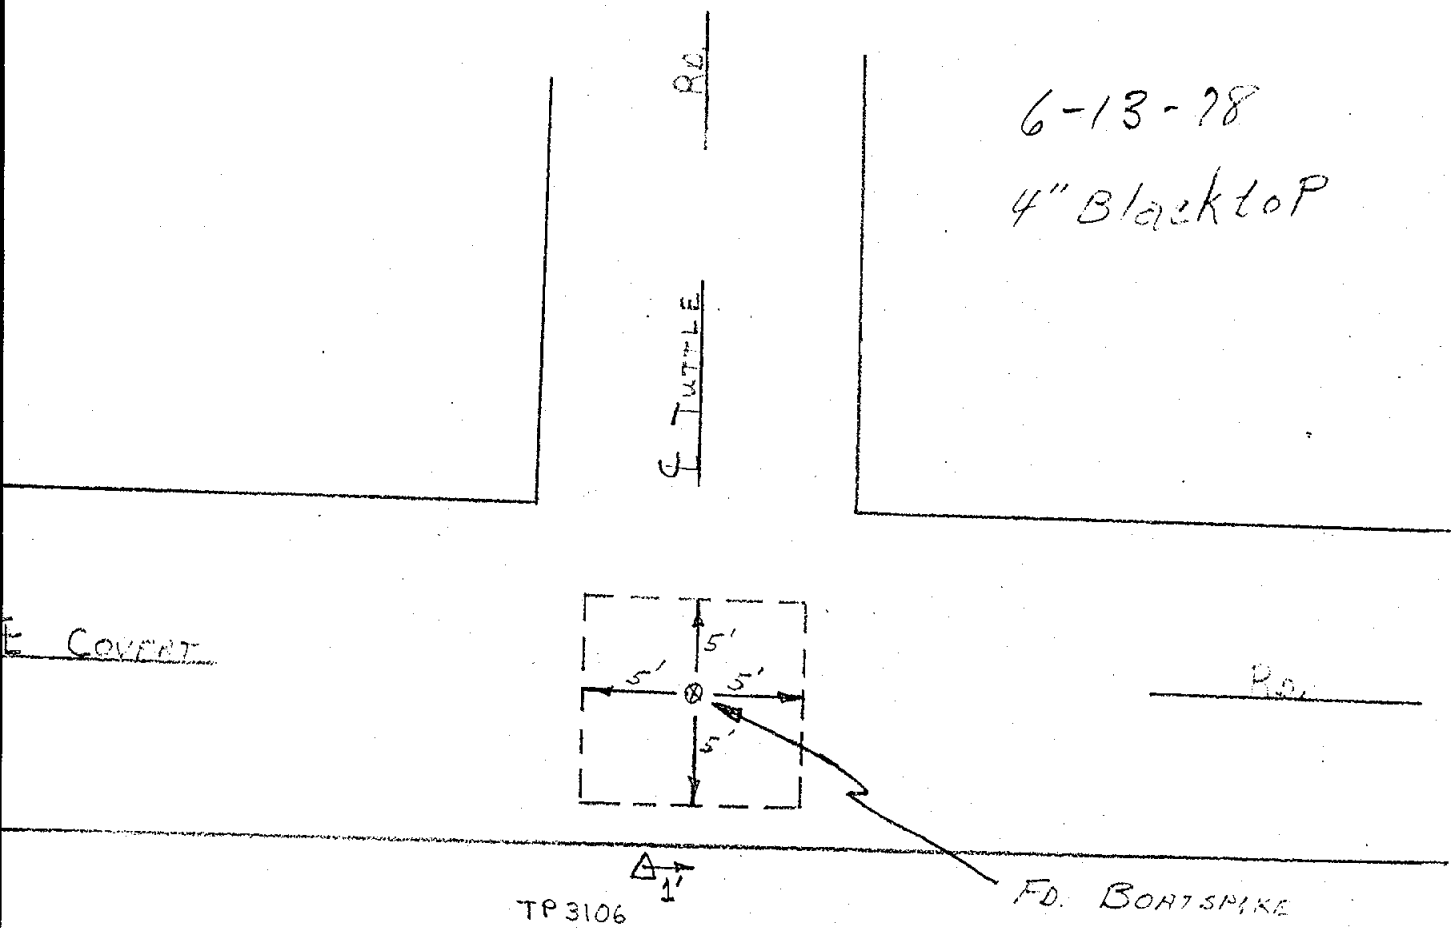

TECH. SUP'R. L. BRYAN TOWNSHIP LESLIE
COMPANY POLARIS CORNER CODE C-5
FIELD SQUAD #9 MINCH - MARTIN RECORDED CORNER No
DATE 4-27-78 ROAD NAME INTER: TUTTLE & COVERT

Sketch, witness, and describe monuments found, and location relative to traverse point and centerline of road.

- N
- 1) I.C.R.C. WITNESS 36" SYCAMORE NE 129.5'
 - 2) SOUTH END OF WEST HEAD WALL WNW 60.74'
 - 3) TP 3106 S. 11.6'

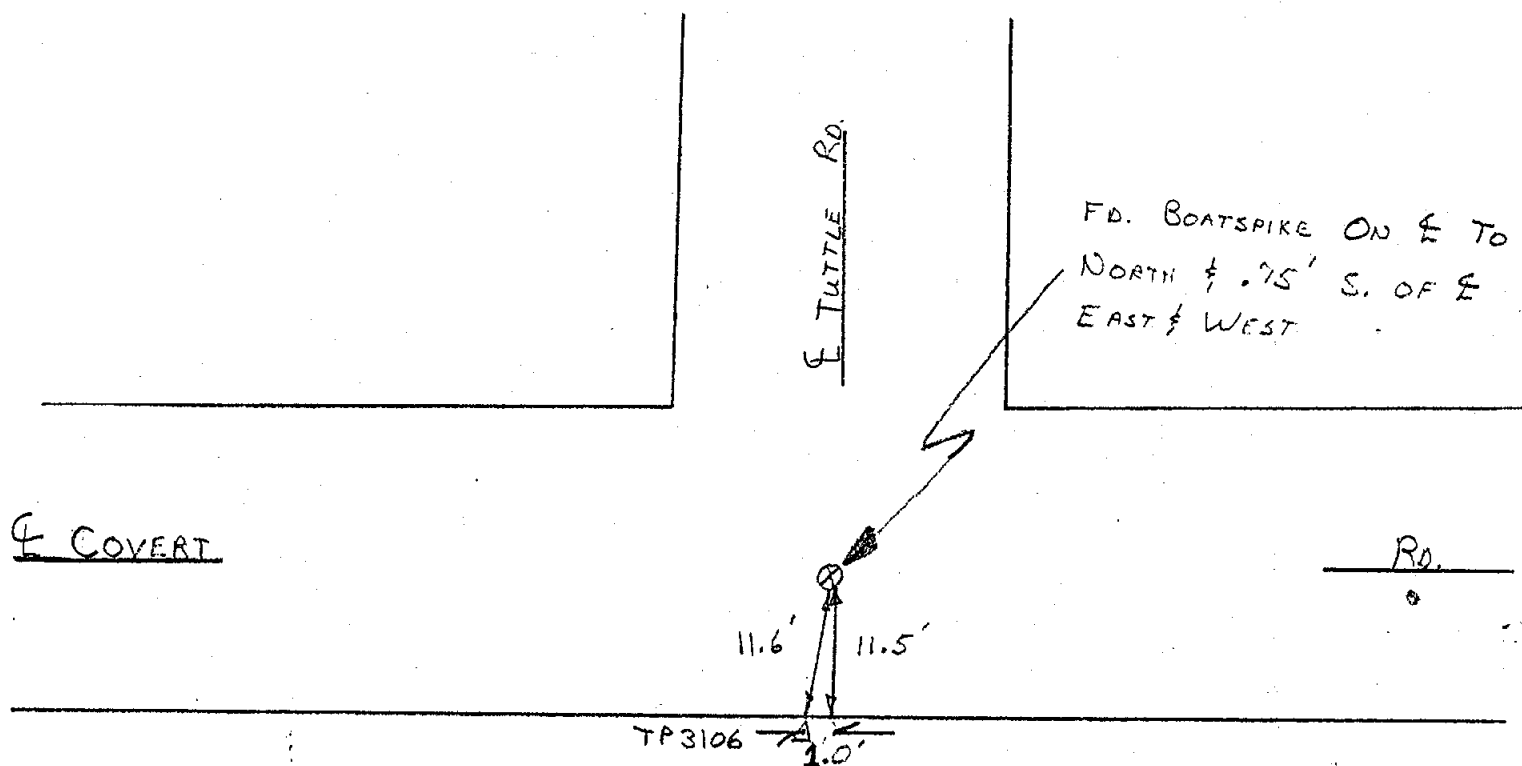

127.38

TRAVERSE POINT WITNESS REPORT

Traverse Point No. 3106

Tech. Sup'r. LARRY B

Township LESLIE

Company POLARIS

Recorded Corner Code


Field Squad #7 DAVE & CHRIS

Date JAN 25 78



Sketch and describe roads, monuments found or set, and witness established:

- 1 SET NAIL TAG ON E/SIDE OF PENCE POST N.W. ~~64.65~~ 64.57
- 2 " " " ON N.W./SIDE OF P.P. N.E. ~~95.61~~ 95.57
- 3 " " " ON N./SIDE OF P.P. W.S.W. ~~55.09~~ 54.09

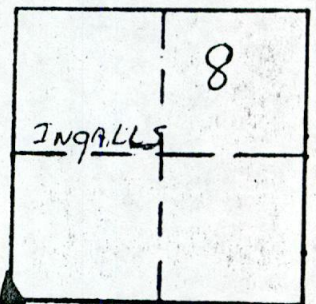

COVERT

CORN

ORCHARD

TITTLE RD.

POWER LINE

P.P. ②

COVERT RD.

E BOTH RDS

12.50

SET 1/2" IRON ROD w/c

POWER LINE

ROAD SIGN

P.P. ③

INGHAM COUNTY SURVEY and REMONUMENTATION PROJECT

Township LESLIE, T 1 N, R 1W
 Corner Code C 5

Research Record:	attachment number(s)	no. of sheets	researched by	reviewed by
Corner Recordation Certificate Liber <u>4</u> Page <u>393</u>	<u>NO</u>	<u>1</u>	SAM — DKH	DKH
Recorded Land Survey Liber Page	<u>NO</u>		"	DKH
Recorded Subdivision Plat Liber Page	<u>↓</u>		"	DKH
MDSHT Right-of-Way Maps Sheet No.	<u>↓</u>		"	DKH
Ingham County Road Comm. Maps Sheet No. <u>8</u>	<u>6</u>	<u>1</u>	<u>h</u>	DKH
Record of the Ingham County Surveyor Vol. <u>5</u> Page <u>1</u> Year <u>1899</u> <u>3</u> <u>135</u> <u>1878</u> <u>2</u> <u>199</u> <u>1854</u>	<u>1</u> <u>2</u> <u>10</u>	<u>3</u> <u>2</u> <u>1</u>	<u>h</u> <u>h</u> <u>h</u>	DKH
General Land Office Maps Sheet No. <u>8</u>	<u>3</u>	<u>1</u>	<u>h</u>	DKH
Form 280, Gov't. Monument Witness Record	<u>NO</u>		"	DKH
Ingham County Drain Comm. File No. <u>303</u>	<u>9</u>	<u>1</u>	DKH	DKH
East Lansing City Engineer	<u>↓</u>		"	DKH
Lansing Public Service Office Cade's 1921 Survey p.	<u>↓</u>		"	DKH
Lansing Public Service Office J.B. Davis' Field Notes p.	<u>↓</u>		"	DKH
G.L.O. Field Notes <u>p. 78</u>	<u>7</u>	<u>1</u>	<u>h</u>	DKH
Misc. I.C. S. Notes <u>BOOK 15</u> <u>p. 102</u>	<u>8</u>	<u>1</u>	"	DKH
Field Recon. Form	<u>4</u>	<u>1</u>	<u>h</u>	DKH
RESEARCH COMPLETED	Total	Total		
Consumers Power Company Sheet No. <u>1</u> Index No. <u>20</u>	<u>5</u>	<u>1</u>	<u>h</u>	DKH
Chesapeake & Ohio Railroad Co. Val. Sec. Drawer Sheet	<u>NO</u>		"	DKH
RESEARCH COMPLETED	Total	Total		
REMARKS				
<u>NOTHING NOTES P. 4</u>	<u>10</u>	<u>1</u>	<u>MARTIN</u>	
<u>FOLDER #1 PAGE 17-31-35</u>	<u>11/2/13</u>	<u>11/1</u>	<u>↓</u>	
<u>FOLDER #2</u>	<u>N.D.</u>			

SOURCE: Preliminary Corner Field Inspection

TRANSCRIBED from ORIGINAL on file at Remonumentation Office

PRELIMINARY CORNER FIELD INSPECTION

Date 3 Nov 77

CORNER
CODE C-5

Team Clinton

TWP Leslie

Pelican

Corner: ~~RECORDED~~
UNRECORDED

Road Name Little & Dover

Road Surface: CONCRETE ASPHALT GRAVEL OTHER: _____

FILL CUT Section

VISIBLE MONUMENT EVIDENCE: _____ Monument Box

_____ Pipe

_____ Iron Bar

_____ Nail

☒ Other: Symmetrical Hole

_____ No Evidence Visible

MONUMENT LOCATION (Relative to centerline of road)

Hole 4" South of center

Remarks:

LESLIE TWSP. T1 N, R1W

C 5 4 p. 1 of 1
cor. code attach.

SOURCE: CONSUMER POWER CO. SH. # 1 IND. # 20
TRANSCRIBED from ORIGINAL on file at REMON. OFFICE
DUPLICATE

C 5

S. W. CORNER OF SECTION 8

STONE & BOAT SPIKE

36" SYCAMORE NE

ANCHOR POST S 12° E

STEEL ANCHOR POST NE

CULY. HOLL N 10° W

MSHD 33-79

1957

SOURCE: Ongnam County Road Commission

Sheet #8

TRANSCRIBED from ORIGINAL
DUPLICATE on file at Remonumentation Office

C-5

Stone, brick
36" Sycamore NE 129.5'
Anch. post NW 52.45'
PP ESE 31.22'
Anch. post NE 42.0'
Hd. Wall WNW 60.74'

SOURCE: DRAIN FILE 303 ROYSTON COUNTY DRAIN OF LESLIE
TRANSCRIBED from ORIGINAL on file at REMON. OFFICE
DUPLICATE

An open main drain to be located and known as the Royston County Drain of Leslie, commencing at a point 15 chains and 76 links south of the section corner of sections 20, 21, 28 and 29 of the township of Leslie, county of Ingham, state of Michigan, the above named point of commencement being upon section line between sections 23 and 29 and under the center of the bridge in highway upon said section line.

BEARINGS OF THE DRAIN'S CENTER LINE.	DISTANCE.		NO. OF THE ANGLE	UNITED STATES SURVEY LINES AND CORNERS AND FARM BOUNDARY LINES AND CORNERS.
	CH'S.	L'KS.		
Beginning.....	0	0	0	On section line between sections 23 and 29 at point 15 chs and 76 lks south of section corner.
N 87° 30' west.....	7	31	1	Farm line between n $\frac{1}{4}$ and s $\frac{1}{4}$ of n e $\frac{1}{4}$ of sec 29, 11 chs 70 lks west of farm corner. Leave s $\frac{1}{4}$, enter n $\frac{1}{4}$ of n e $\frac{1}{4}$ of section 29.
N 40° west.....	2	34	2	
N 47° west.....	8	57	3	Farm line between the n $\frac{1}{4}$ of the n e $\frac{1}{4}$ of n e $\frac{1}{4}$ of sec 29 and w $\frac{1}{4}$ of n e $\frac{1}{4}$ of sec 29, 1 ch 65 lks south of farm corner. Leave n $\frac{1}{4}$ of n e $\frac{1}{4}$ of n e $\frac{1}{4}$ of sec 29, enter w $\frac{1}{4}$ of n e $\frac{1}{4}$ of sec 29.
N 47° west.....	2	12	4	Section line between sections 20 and 29, 1 ch 60 lks west of n e corner of w $\frac{1}{4}$ of n e $\frac{1}{4}$ of sec 29. Leave w $\frac{1}{4}$ of n e $\frac{1}{4}$ of sec 29, enter s $\frac{1}{4}$ of a e $\frac{1}{4}$ of sec 20.
North.....	12	12	5	
North.....	12	12	6	
N 34° 10' west.....	7	92	7	N and s $\frac{1}{4}$ line in sec 20, 2 chs 77 lks s of n w corner of a w $\frac{1}{4}$ of a e $\frac{1}{4}$ of sec 20. Leave s $\frac{1}{4}$ of a e $\frac{1}{4}$ of sec 20. Enter e $\frac{1}{4}$ ac of a e $\frac{1}{4}$ of a w $\frac{1}{4}$ of sec 20.
N 32° 30' west.....	3	50	8	Farm line between e $\frac{1}{4}$ and w $\frac{1}{4}$ ac of a e $\frac{1}{4}$ of a w $\frac{1}{4}$ of sec 20, 1 ch 90 lks s of farm corner. Leave e $\frac{1}{4}$ ac. Enter w $\frac{1}{4}$ ac of a e $\frac{1}{4}$ of a w $\frac{1}{4}$ of sec 20.
N 44° west.....	12	50	9	Farm line between w $\frac{1}{4}$ ac and n e $\frac{1}{4}$ of a w $\frac{1}{4}$ of sec 20, 3 chs 53 lks w of n e corner of w $\frac{1}{4}$ ac of a e $\frac{1}{4}$ of a w $\frac{1}{4}$ of sec 20. Leave w $\frac{1}{4}$ ac of a e $\frac{1}{4}$ of a w $\frac{1}{4}$ and enter n e $\frac{1}{4}$ of a w $\frac{1}{4}$ of sec 20.
N 61° 30' west.....	2	15	10	And farm line between n e $\frac{1}{4}$ of a w $\frac{1}{4}$ and w $\frac{1}{4}$ of a w $\frac{1}{4}$ of sec 20. Enter w $\frac{1}{4}$ of a w $\frac{1}{4}$ and continue on line.
N 61° 30' west.....	2		11	E and w $\frac{1}{4}$ line in section 20 at lot post in w $\frac{1}{4}$ of $\frac{1}{4}$ line. Leave w $\frac{1}{4}$ and n e $\frac{1}{4}$ of a w $\frac{1}{4}$ of sec 20. Enter w $\frac{1}{4}$ and e $\frac{1}{4}$ of n w $\frac{1}{4}$ of sec 20 on farm line and continue on line.
N 61° 30' west.....	3	13	12	
N 61° 30' west.....	23	8	13	
N 65° 30' west.....	11	50	14	
N 88° 45' west.....	3	13	15	
N 0° 30' west.....	14	12	16	
N 0° 30' west.....	10	25	17	
N 31° 30' east.....	4	12	18	
N 31° 30' east.....	4	13	19	
N 25° east.....	3	50	20	
N 32° 30' west.....	2	33	21	
N 0° 15' west.....	4	17	22	
N 2° 30' east.....	1	16	23	
N 42° 30' east.....	3	55	24	
N 1° 15' east.....	10	93	25	
N 1° 15' east.....	10	30	26	
N 13° 45' east.....	11	80	27	
N 34° 45' west.....	7	23	28	
N 1° east.....	2	39	29	
N 1° east.....	10	91	30	
N 89° west.....	2	60	31	
N 22° 30' west.....	3	49	32	
N 34° 30' west.....	3	49	33	
N 0° 45' west.....	5	77	34	
N 63° 40' west.....	6	83	35	
N 62° 40' west.....	2	77	36	
N 83° 15' west.....	6	80	37	
N 0° 30' west.....	2	97	38	
N 0° 30' west.....	7	20	39	
West.....	25	30	40	
West.....	43	31	41	
N 18° 15' west.....	11	65	42	
N 30° 45' west.....	5		43	
N 0° 15' west.....	4	30	44	
N 33° 15' west.....	8	60	45	
N 33° 15' west.....	8	90	46	
N 2° 45' west.....	7	10	47	
N 12° 45' west.....	3	30	48	
N 12° 45' west.....	3	30	49	
West.....	16	61	50	
N 38° 15' west.....	9	80	51	
N 38° 15' west.....			52	

All of the above described main drain, together with the lands benefited thereby and to be assessed therefor, being situated in the township of Leslie, county of Ingham, state of Michigan. The above described drain is marked on and along its center line by grade stakes at equal distances of two chains each and numbered consecutively from No. 0 at the commencement on and to the end thereof, together with angle stakes consecutively numbered in their order from the commencement on and to the last angle of said drain. The above described drain to have an average depth of four feet below the lowest levels of the lands to be drained with a bottom width of two feet, with banks sloping outward at an angle of forty-five degrees (45°), making an average width on top of ten feet in the lowest lands, together with a strip of land ten feet wide next to and adjoining either side of the top of the said proposed drain as constructed its entire length for the purpose of placing the excavations thereof; the grade hubs from which the grade is estimated are placed and driven opposite the regular grade stakes which mark the center line of the said proposed drain. The said hubs are placed and driven upon the right hand side of the drain up to and including grade stake No. 39 and thence to the end of said drain. The hubs are driven upon the left hand side of the drain up to and including grade stake No. 135 which marks the end of the said proposed drain.

The side notes which give the place of entering and leaving each individual parcel and ownership of land, together with the U. S. survey lines, thus clearly define and set forth the particular lands to be taken for the use and purposes of the said proposed drain as defined and set forth by the above survey. The lines and bearings of which are run with reference to the true geographical meridian, the magnetic variation being set off by the vernier of the compass.

The above described line was run May 12th, 13th, and the levels run May 14th, 1922.

JOHN MCCREARY, Surveyor.

SOURCE

TRANSCRIBED FROM ORIGINAL
DUPLICATE on file at

TOWNSHIP: LESLIE
SECTION: 7

Point: C-5

Pointed stone (brick)

Sycamore 36" N.E. 129.5'

Anchor post N.W. 52.0'

Fence South 28.0'

Steel Anchor post N.E. 42.0'

CULV. HEAD WALL N. 10° W. 60.74'

LESLIE
township

T 1 N, R 1 EW

C-5
corner code attachment no.

10
p. 1 of 1