


CHANDLER 11/11/20
K 4

	A	B	C	D	E	F	G	H	I	J	K	L	M
1													
2	6	5	4	3	2								
3													
4	7	8	9	10	11	12							
5													
6	8	17	16	15	14	13							
7													
8	19	20	21	22	23	24							
9													
10	30	29	28	27	26	25							
11													
12	31	32	33	34	35	36							
13													

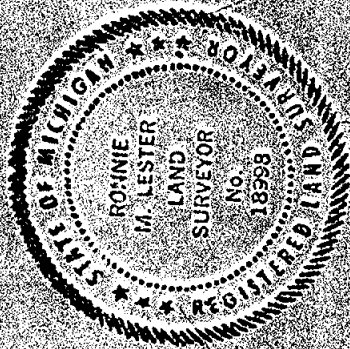

LAND CORNER RECORDATION CERTIFICATE

FILING REQUIREMENT OF ACT 74, MICH. P.A.1970

FOR CORNERS OF--	LOCATED IN--	CORNER CODE NUMBER
1. PUBLIC LAND SURVEY _____ T. <u>1</u> N. <u>2</u> W.		<u>K-4</u>
2. PROPERTY CONTROLLING IN SECTION _____, T. _____ N. _____ E. _____ S. _____ R. _____ W. _____		
3. MISCELLANEOUS PROPERTY IN SECTION _____, T. _____ N. _____ E. _____ S. _____ R. _____ W. _____		
4. LOT NO. _____, RECORDED PLAT _____		
5. PRIVATE CLAIMS _____		

L4 P289

REGISTER OF DEEDS STAMP AND FILING NUMBER

I, Ronnie M. Lester, do hereby certify that under requirements of P.A. 74, Michigan P.A. of 1970, the corner points mentioned in lines 1 and 2 above were, in a field survey on June 5, 1978, established, re-established, monumented, re-monumented, recovered or restored as expressed below and in conformance with regulations and rules therefore as required in the current manual of survey instructions of the United States Department of the Interior, Bureau of Land Management or by a decree of a court of law. Furthermore, that the corner points mentioned in lines 3, 4 and 5 above were, in a field survey on _____, 19____, found, recovered, restored, established or re-established as expressed below and in conformance with the rules of the Michigan State Board of Registration for Land Surveyors or, by a Decree of a Court of law:

A. Description of original monument and accessories and/or subsequent restoration:

K-4

Post set in original government survey by Harvey Parke dated Oct. 1825 to Jan. 1826.

Corner referred to in a subsequent survey by A. Jackson, County Surveyor, dated Nov. 1844 (v.1, p.26) and W. Rayner, April, 1868.

B. Description of corner evidence found and/or method applied in restoring or re-establishing corner:

K-4

Excavated a hole 5' x 5' at average depth of 3' on centerline Edgar Road on fence line to the east and west. Found two large rocks 1' x 0.6' on centerline Edgar Road, 1' north of fence line to east and west, and 2' below road surface. Found 2" x 2" pre-cut pointed wood stake directly underneath large rocks and 2.5' below road surface. Found three rocks at base of wood stake. Excavation discontinued due to high water table. Measured north +2640' to K-3. Measured south +2620' to K-5.

Excavation conducted by Ingham County Survey and Remonumentation Project crew.

C. Description of monument for corner and accessories established to perpetuate locating the position of the corner:

K-4

E $\frac{1}{2}$ Corner, Section 11, T1N-R2W

Set 4" x 36" concrete monument with $\frac{1}{2}$ " x 38" rerod with cap #18998 with concrete collar and cover in place of wooden stake described above:

Nail & tag, #18998, east side 4" Poplar, SSW, 142.20'

Nail & tag, #18998, west side 4" Apple, NE, 88.42'

Nail & tag, #18998, north side 12" Willow, West, 90.24'


Nail & tag, #18998, west side 20" Twin Elm, SSE, 391.05'

SIGNED BY Ronnie M. Lester DATE Aug 21, 1978

SURVEYOR'S MICHIGAN REGISTRATION NO. 18998

(SEAL)

XXXXXXXXXXXXXXXXXXXXXXXXXXXXXXXXXXXX

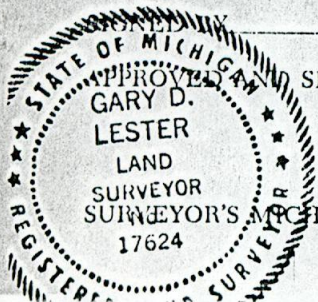

DATE _____
SIGNED BY Ronnie M. Lester DATE 8-22-78
DIRECTOR, Ingham County Survey and Remonumentation Project
MICHIGAN REGISTERED LAND SURVEYOR
SURVEYOR'S MICHIGAN REGISTRATION NO. 17624





MONUMENTED CORNER REPORT

TECH. SUP'R. LARRY BRYAN TOWNSHIP DANONDA
COMPANY POLARIS CORNER CODE K-4
FIELD SQUAD #7, KONA RONI RECORDED CORNER NO
DATE 6-5-78 ROAD NAME EDGAR

Sketch, witness, and describe monuments found, and location relative to traverse point and centerline of road.


N IN PLACE OF WOODEN STAKE, A 36" CONC. MONUMENT WITH
 $\frac{1}{2}$ " IRON BAR AND ~~PLS~~ CAP 18998 WAS SET 1' NORTH OF DIRECT LINE
 BETWEEN THE TWO CORNER FENCE POSTS, AND AT THE APPROX. CENTER
 J. S. OD G. FLANK RD. WITNESSES ARE AS FOLLOWS:

142.16	142.24	1) SET RLS N+T 18998 S 20° W E/S 4" POPULAR
88.43	88.42	2) SET RLS N+T 18998 N 35° E W/S 4" APPLE
		3) SET RLS N+T 18998 DUE EAST ON S/S 16" CHERRY
90.23	90.24	4) SET RLS N+T 18998 S 85° W ON N/S 12" WILLOW
391.03	391.05	3 SET RLS N+T 18998 S. 10° E. ON W/S TWIN 20" ELM

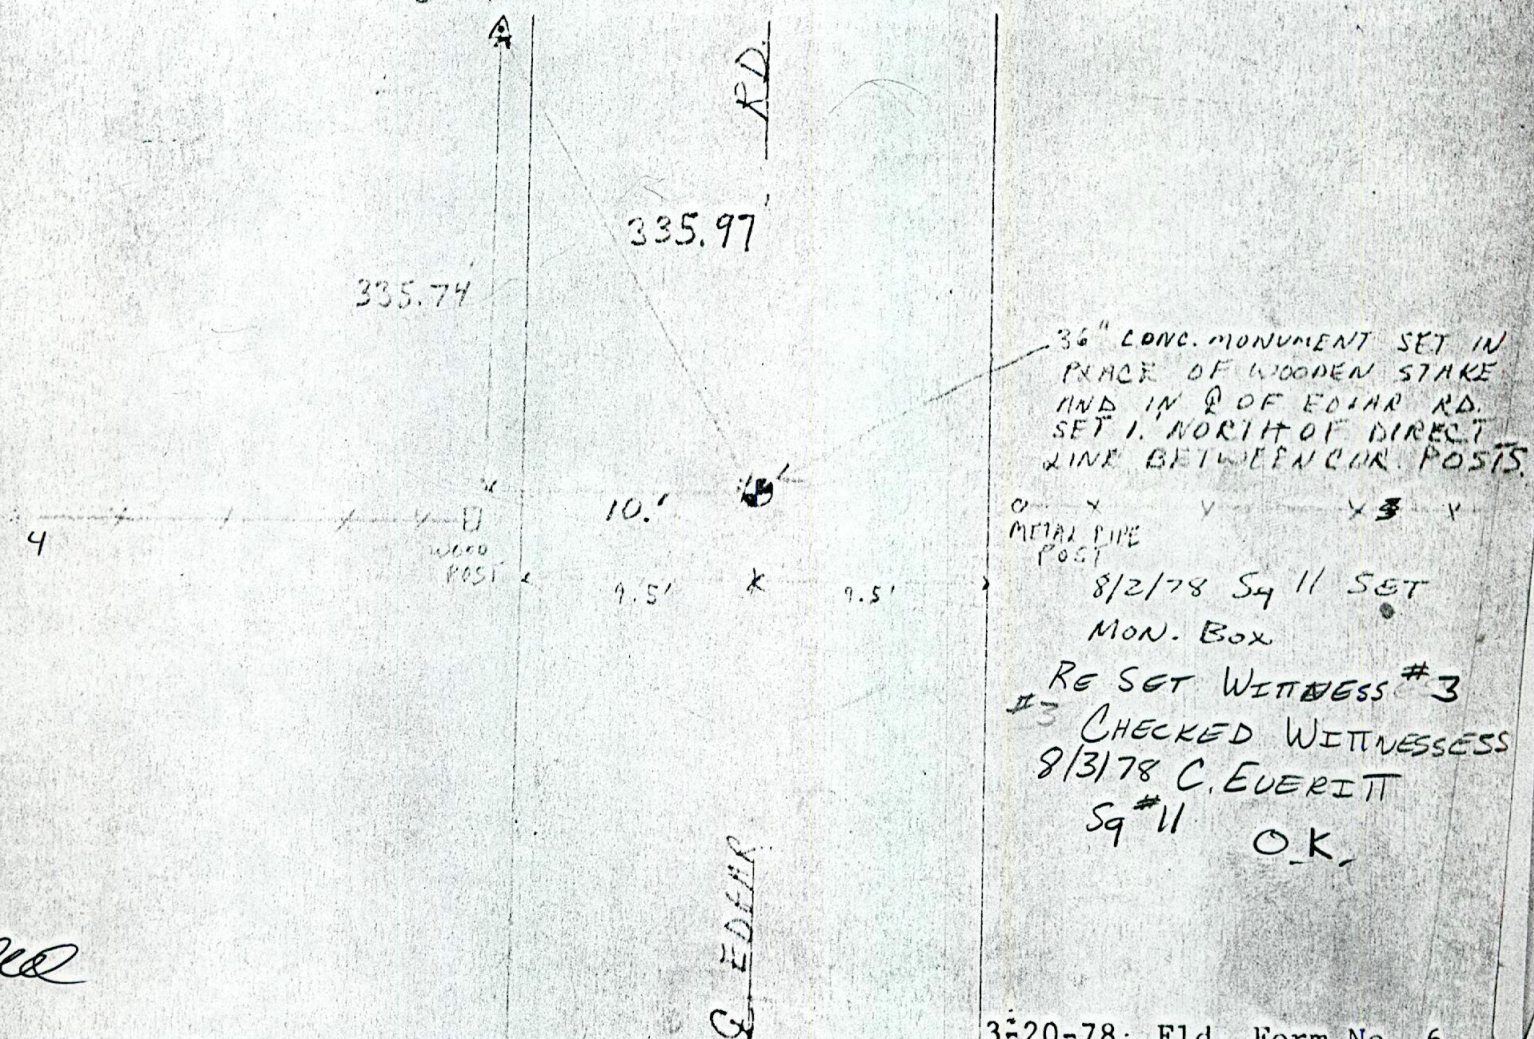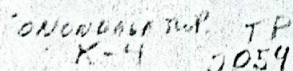

witness, and describe monuments found, and location relative to point and centerline of road.

- 1) SET RLS N+T 18998 S 20°W E/S 4" POPULAR 142.34
- 2) SET RLS N+T 18998 N 35°E W/S 4" APPLE 88.41
- 3) SET RLS N+T 18998 DUE EAST ON S/S 16" CHERRY 137.06
- 4) SET RLS N+T 18998 S 85°W ON N/S 12" WILLOW 90.27

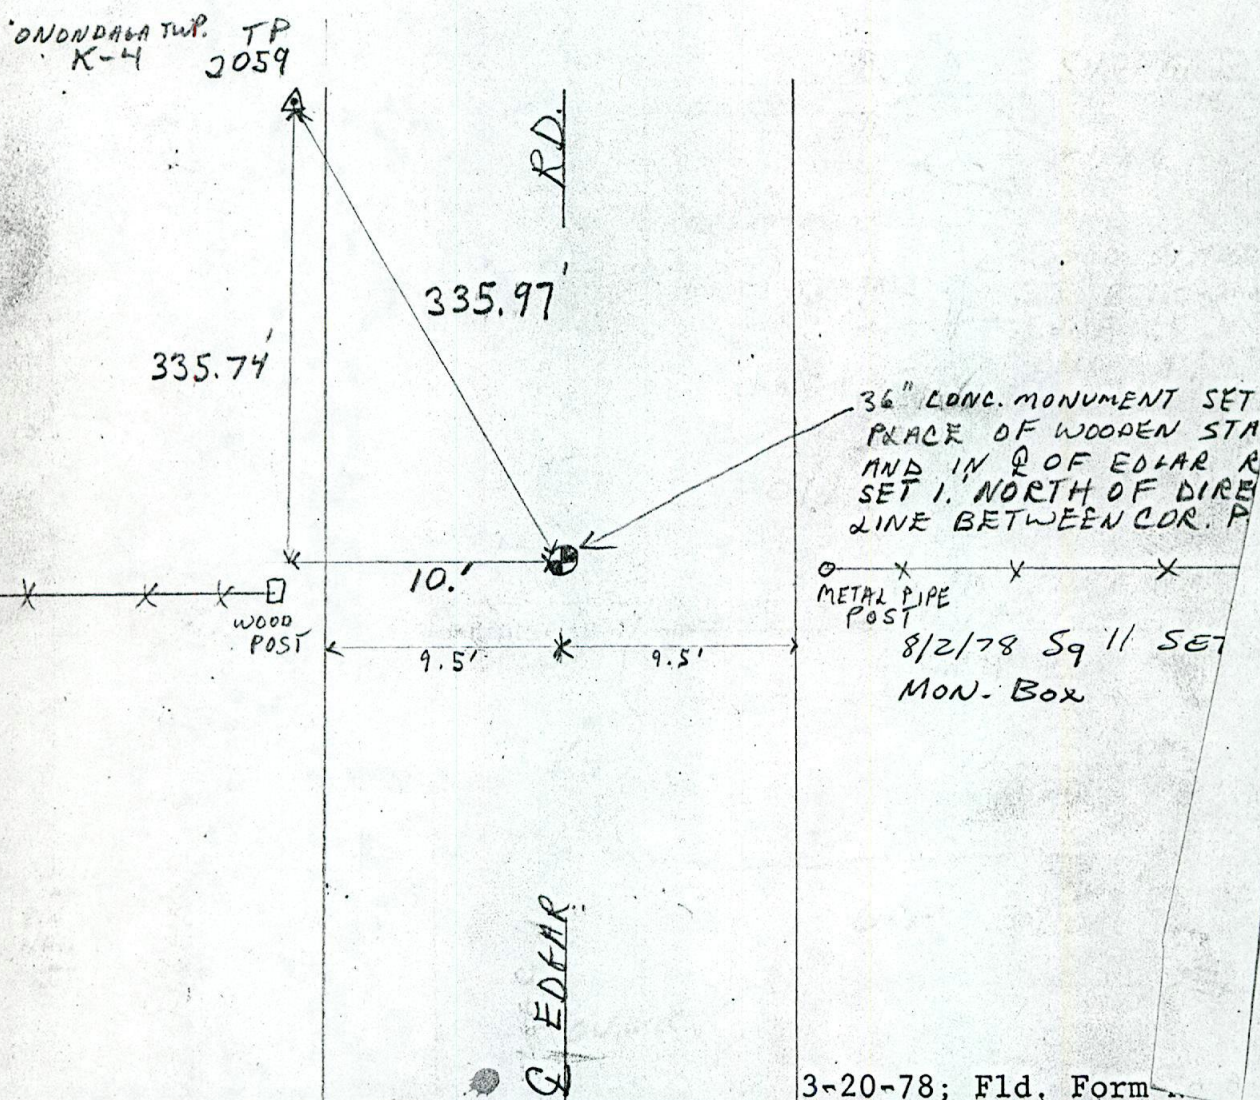

3-20-78; Fld. Form.

NOTHS


NOTHS

TECH. SUP'R. LARRY BRYAN TOWNSHIP ONONDAGA
COMPANY POLARIS CORNER CODE K-4
FIELD SQUAD #7, Komaromi PAGE 1 OF 1 DATE 6-5-78

EXCAVATED AREA: 5' X 5 SQ. FT.; AVG. DEPTH 3' SURFACE 2" ASPHALT

Sketch and describe roads, monuments found or set, and witnesses established:

N. BEGAN EXCAVATING A 5' X 5' AREA WHERE A DIRECT LINE BETWEEN COR. POSTS 4 & 0 OF EDGAR RD. CROSSED AS LAYED OUT BY MARK MINSHALL. TWO FEET BELOW THE ROAD SURFACE 2 LARGE ROCKS + A SMALLER ROCK BELOW THEM WERE FOUND AND WITNESSED FROM 2 P.K.
WKS SET IN THE ROAD SURFACE AS FOLLOWS: 1) N 45° W 8.53' 2) S 45° W 9.46'
2" X 2" WOOD STAKE WAS THEN FOUND AT A DEPTH OF 2.5' BELOW ROAD SURFACE AND DIRECTLY BELOW 3 ROCKS FOUND AS MENTIONED. STAKE (WOOD) WITNESSES AS FOLLOWS: 1) N 45° W 8.43' 2) S 45° W 9.24' FROM TWO SET P.K. MARKS. THE WOOD STAKE WAS POINTED AND HAD BEEN PRE-CUT.

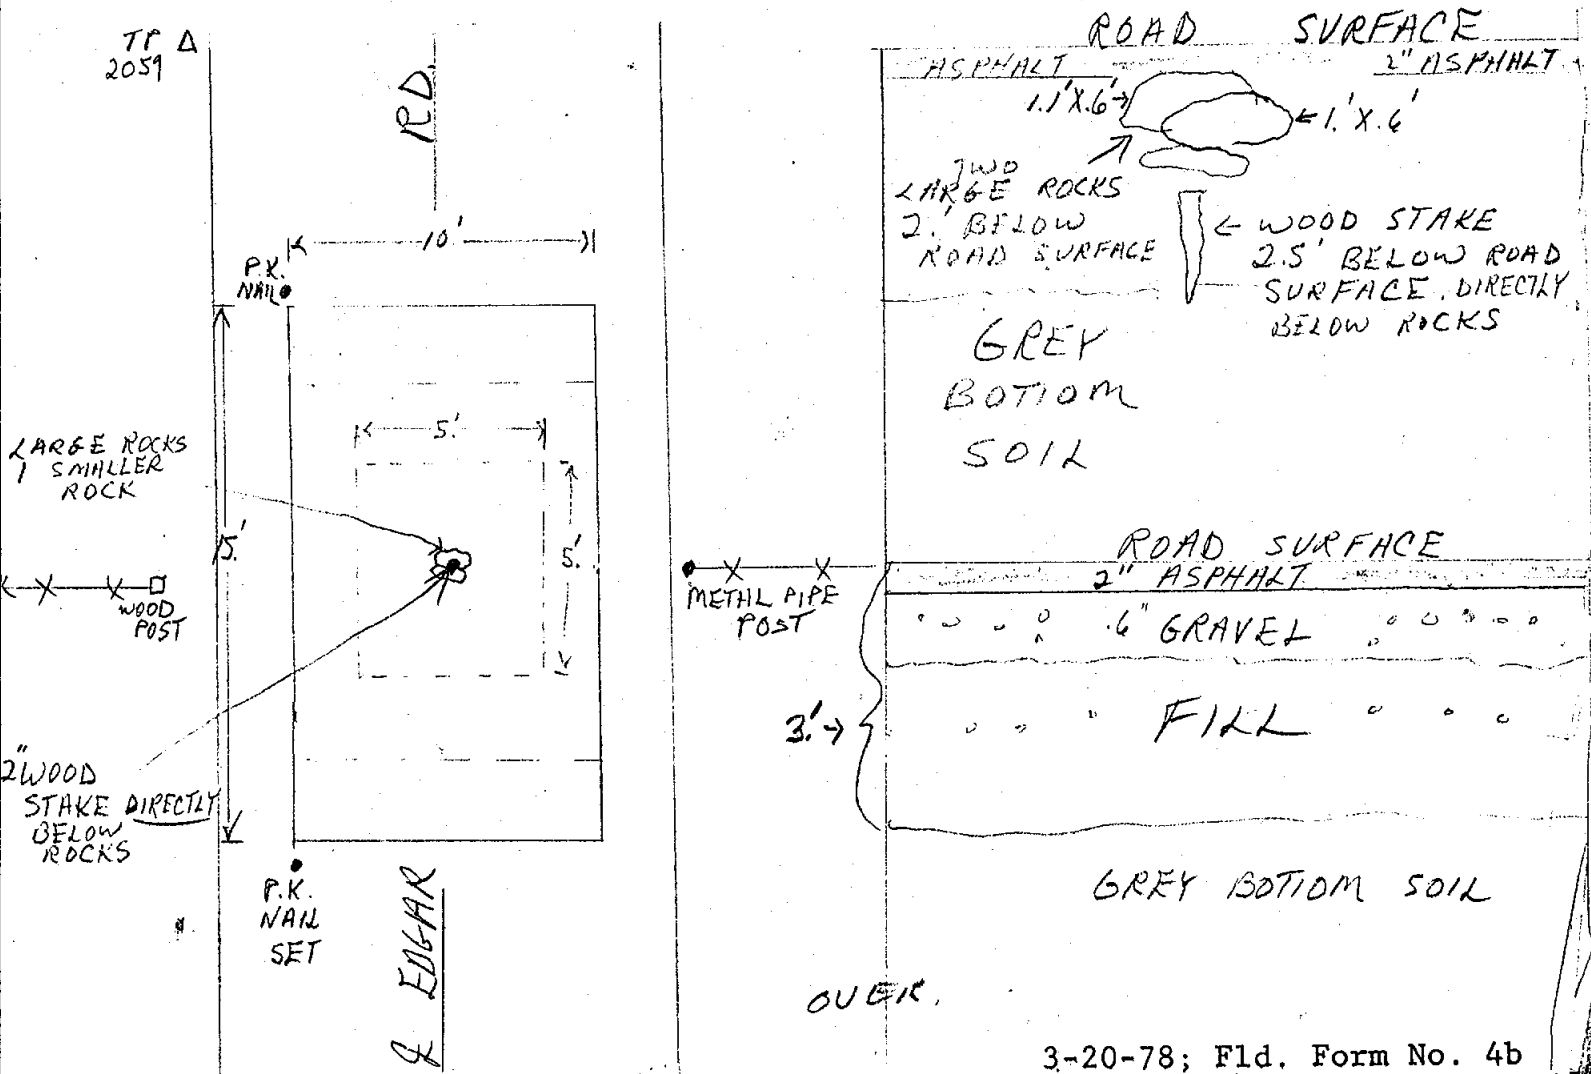

THIS IS NO FILE AREA AND ON THE GROUND


TECH. SUP'R. L. BRYAN TOWNSHIP ONDONADA
COMPANY POLARIS CORNER CODE K-4
FIELD SQUAD #9 MINSHALL ROAD NAME EDGAR RD. / ASPHALT

Sketch, witness, and describe monuments found and proposed excavation site relative to traverse point and centerline of road.



BEGIN EXCAVATION AT A POINT 339' SOUTH OF TP 2059
& IN 4 OF RD.

SPLIT A DIRECT LINE BETWEEN COR. POSTS FOR BEG.
GO 5' ALL DIRECTIONS.

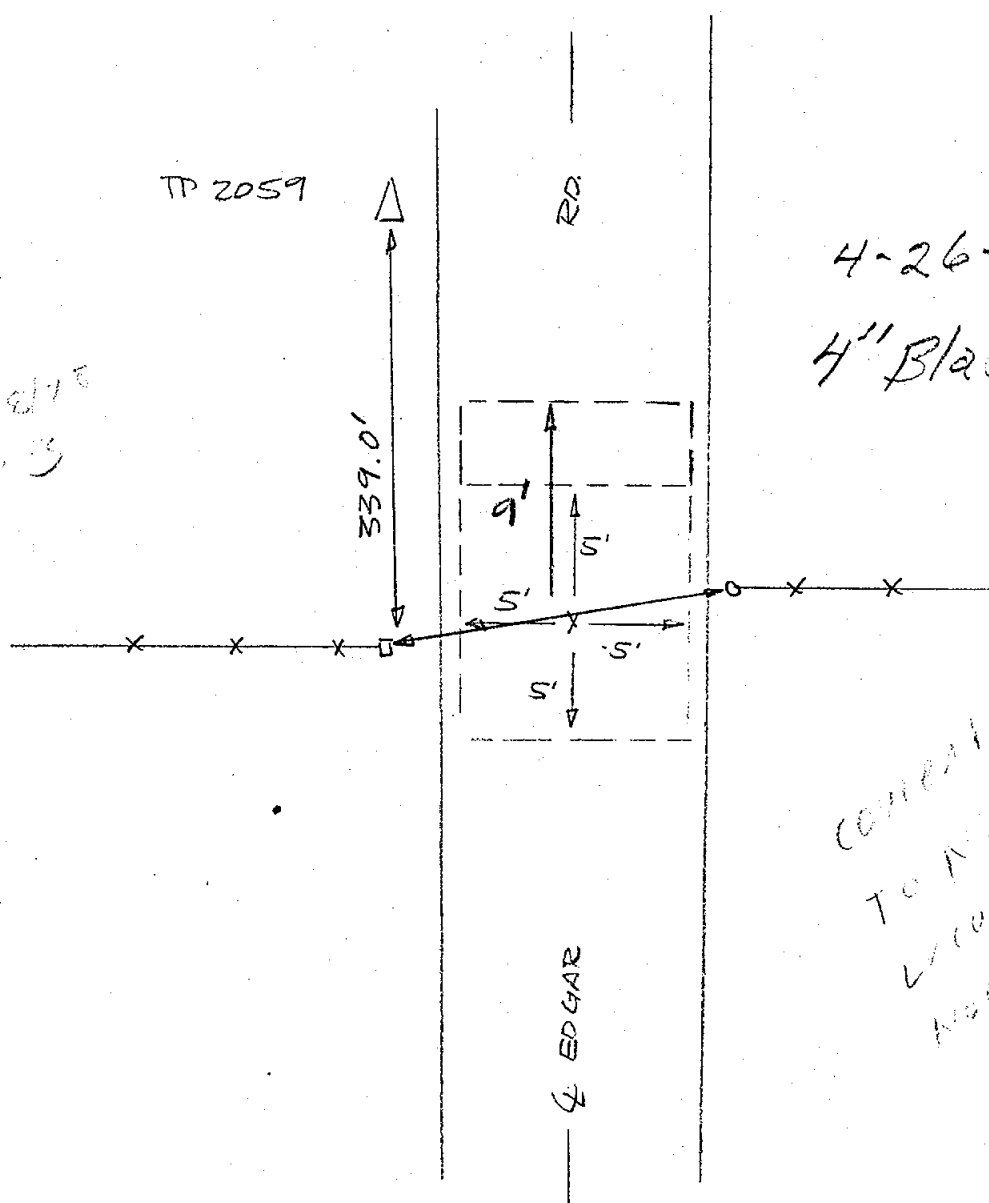

4-26-78
4" Blacktop
CONCRETE TO NORTH
L. BRYAN 2-4-78
Not if no monument
found

OIC M

GO S' ALL DIRECTIONS
SPLIT A DIRECT LINE BETWEEN CO. POSTS FOR BLY.
8 IN 4 OF RD.
BEGIN EXCAVATION AT A POINT 339' SOUTH OF TP 2059

N

Sketch, witness, and describe monuments found and proposed excavation site relative to traverse point and centerline of road.

FIELD SQUAD #4 MINSHALL
ROAD NAME EMYAR RD. ASPHALT

COMPANY POLARIS
CORNER CODE K-4

TECH. SUP. R. L. BRYAN
TOWNSHIP ONONDAGA

THIS IS AN FILL AREA AND ORIGINAL GROUND
LEVEL WAS UNABLE TO BE REACHED. DUE
TO HIGH WATER TABLE; I HAD SQUAD SET
MONUMENT AT WOOD STAKE FOR LACK
OF ANY OTHER EVIDENCE. A IDENTICAL
WOOD STAKE WAS FOUND AT K-3 AND WAS
PROVED NOT TO BE THE SECTION CORNER

L. BRYAN

TO BE REVIEWED BY R.L.S. I SEE
NO REASON FOR MORE EXCAVATIONS

TRAVERSE POINT WITNESS REPORT

5/21/2017
K-4



Traverse Point No. 2059

Tech. Sup'r. LARRY B
Company POLARIS
Field Squad #7 DAVE + CHRIS

Township 0 N 43 36 E
Recorded Corner Code ~~~~~
Date 12/27/77

Sketch and describe roads, monuments found or set, and witness established:

- W. S. W. 18.55 To STUMP
- W. 15.60 To WOOD POST
- N. W. 24.10 To WOOD POST
- E. 40.89 To MAPLE TREE 6 in DIM

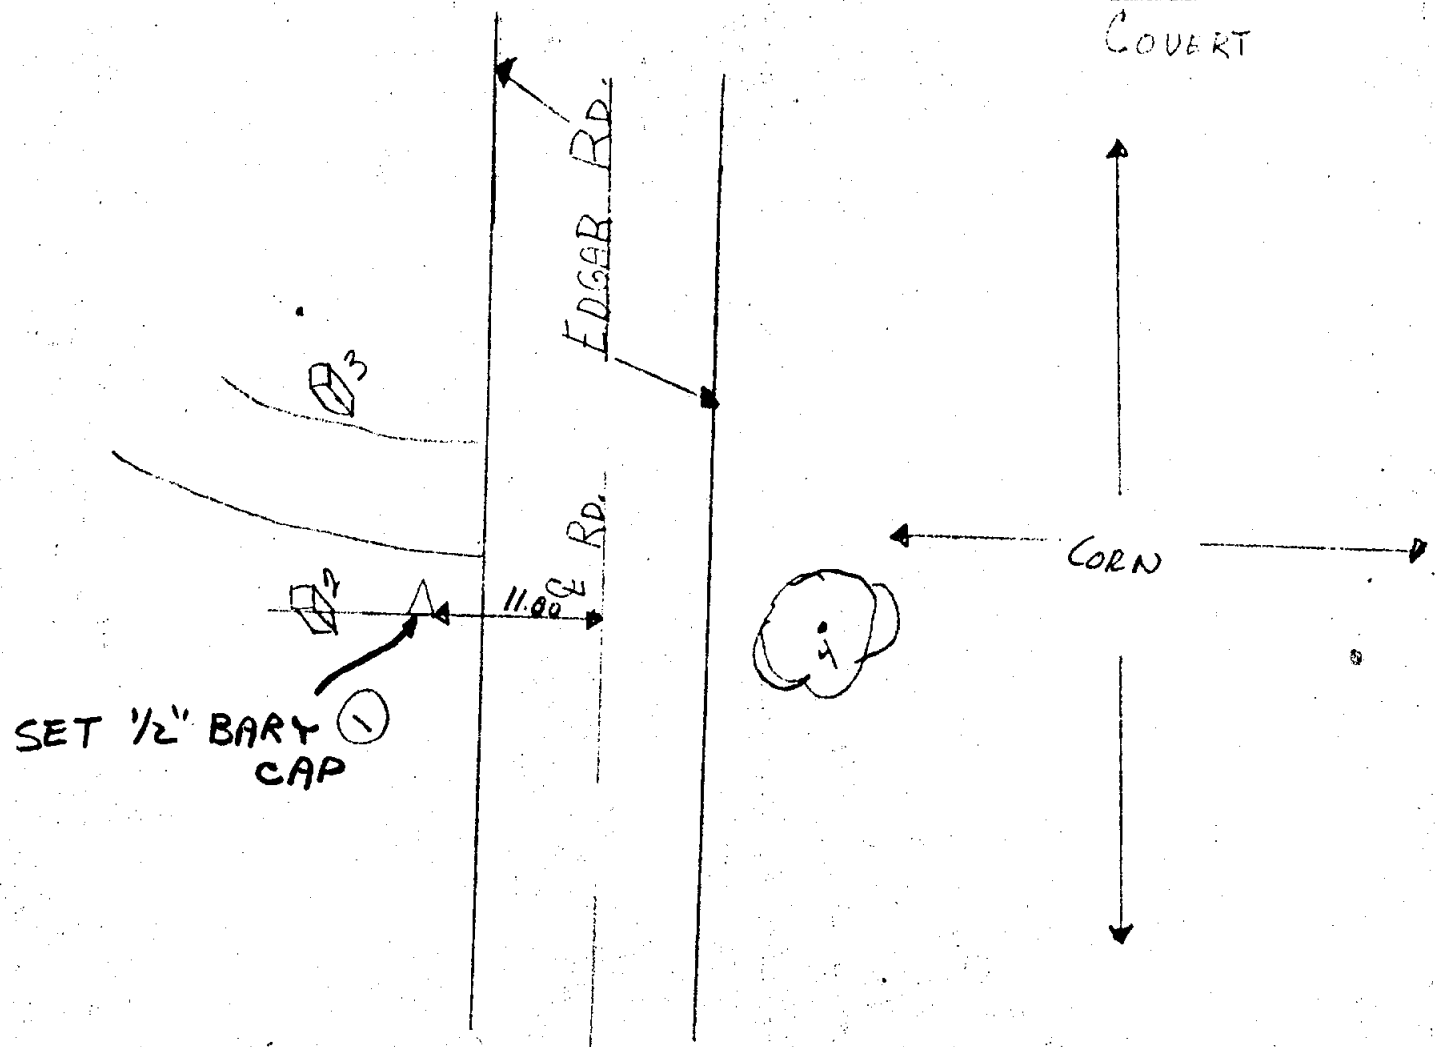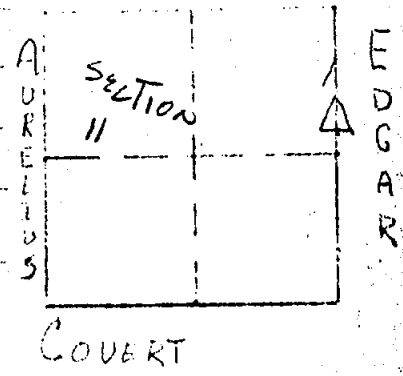

INGHAM COUNTY SURVEY and REMONUMENTATION PROJECT

Township ONONDAGA , T 1 N , R 2W
 Corner Code K 4

Research Record:	attachment number(s)	no. of sheets	researched by	reviewed by
Corner Recordation Certificate Liber <u>4</u> Page <u>289</u>	<u>0</u>	<u>1</u>	<u>h</u>	<u>geh</u>
Recorded Land Survey Liber Page	<u>ND</u>		<u>"</u>	<u>geh</u>
Recorded Subdivision Plat Liber Page	<u>}</u>		<u>"</u>	<u>geh</u>
MDSHT Right-of-Way Maps Sheet No.	<u>}</u>		<u>"</u>	<u>geh</u>
Ingham County Road Comm. Maps Sheet No.	<u>}</u>		<u>"</u>	<u>geh</u>
Record of the Ingham County Surveyor Vol. <u>1</u> Page <u>26</u> Year <u>1844</u>	<u>1</u>	<u>1</u>	<u>h</u>	<u>geh</u>
General Land Office Maps Sheet No. <u>11</u>	<u>2</u>	<u>1</u>	<u>h</u>	<u>geh</u>
Form 280, Gov't. Monument Witness Record	<u>ND</u>		<u>"</u>	<u>geh</u>
Ingham County Drain Comm. File No.	<u>}</u>		<u>"</u>	<u>geh</u>
East Lansing City Engineer	<u>}</u>		<u>"</u>	<u>geh</u>
Lansing Public Service Office Cade's 1921 Survey p.	<u>}</u>		<u>"</u>	<u>geh</u>
Lansing Public Service Office J.B. Davis' Field Notes p.	<u>}</u>		<u>"</u>	<u>geh</u>
G.L.O. Field Notes p. <u>33</u>	<u>3</u>	<u>1</u>	<u>h</u>	<u>geh</u>
Misc. I.C. S. Notes <u>Collection of Various...</u> p. <u>12</u>	<u>5</u>	<u>1</u>	<u>h</u>	<u>geh</u>
Field Recon. Form	<u>4</u>	<u>1</u>	<u>h</u>	<u>geh</u>
RESEARCH COMPLETED date	Total	Total		
Consumers Power Company Sheet No. Index No.	<u>ND</u>		<u>4</u>	<u>geh</u>
Chesapeake & Ohio Railroad Co. Val. Sec. Drawer Sheet	<u>ND</u>		<u>4</u>	<u>geh</u>
RESEARCH COMPLETED date	Total	Total		
REMARKS FOLDER #1	<u>N.D.</u>		<u>LALONDE</u>	
FOLDER #2	<u>N.D.</u>		<u>↓</u>	
NOTHSTINE NOTES	<u>N.D.</u>		<u>↓</u>	

SOURCE: RECORD OF CO. SURVEYOR V. 1 P. 26 Yr. 1844


TRANSCRIBED from ORIGINAL on file at REG. OF DEEDS
DUPLICATE

SURVEYOR'S NAME A. JACKSON SURVEYOR NO. _____

DATE OF SURVEY Nov. 27, 1844 SECTION NO. 12

MAGNETIC VARIATION 3 1/6 E

A Jam 10 N 65 W 16 lks.
B Ash 10 N 81 E 13
B Whitewood 40 N 49 1/2 W 26
Whitewood 32 N 83 3/4 E 58 1/2
B. Oak 20 N 56 4 E 58 1/2
C Beech 10 N 72 W 5 33
D W. Oak 36 S 81 2/3 W 61
do 36 N 42 1/2 E 15
E Beech 8 S 87 E 20 W 57 1/2
Beech 67 S 50 1/4 W 43
Beech 9 N 62 W 22 1/2 63
F W. Oak 9 S 59 W 41
Sugar 8 N 52 W 86
G Sugar 12 S 50 E 16
H Syr 22 S 82 1/2 W 26
H Maple 20 N 80 W 18
R. Oak 18 N 65 1/2 E 40 1/2
I Beech 14 N 24 1/2 E 21
J W. Oak 24 N 73 E 20 1/2
K B. Oak 10 S 35 W 8
B. Oak 10 N 64 E 27

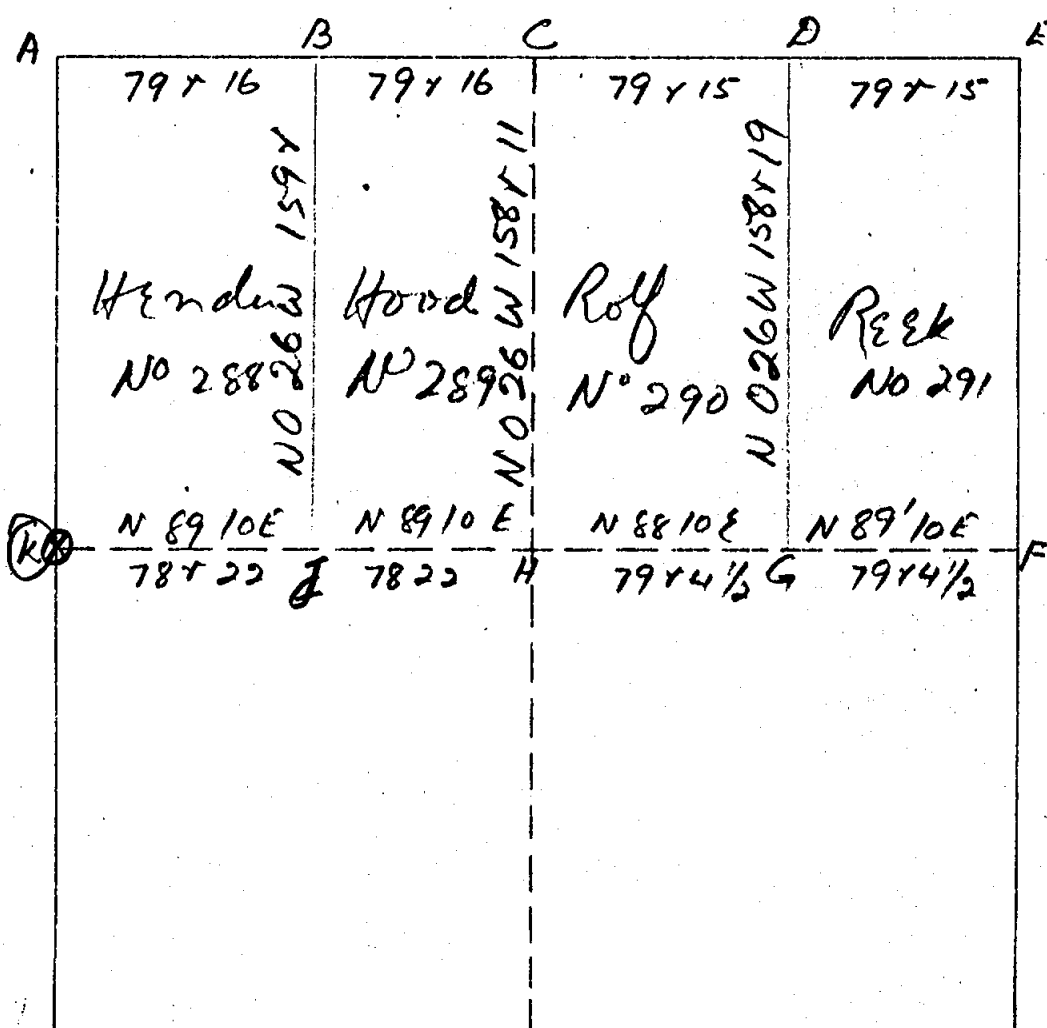

NOT TO
SCALE

ONONDAGA
TOWNSHIP

T 1 N, R 2 W

K 4
CORNER CODE

1
ATTACHMENT NO.

P. 1 of 1

SOURCE: Preliminary Corner Field Inspection

TRANSCRIBED from ORIGINAL on file at Remonumentation Office

PRELIMINARY CORNER FIELD INSPECTION

Date Nov. 4, 1977

CORNER
CODE K-4

Team McK Y.

TWP Onondaga

Dave K.

Corner: ~~XXXXXX~~
UNRECORDED

Road Name Edgar north of Corvett

Road Surface: CONCRETE ASPHALT GRAVEL OTHER: _____

FILL CUT Section

VISIBLE MONUMENT EVIDENCE: _____ Monument Box
_____ Pipe
_____ Iron Bar
_____ Nail
_____ Other: _____
☒ No Evidence Visible

MONUMENT LOCATION (Relative to centerline of road)

Remarks:

Onondaga TWSP. T 1 N, R 2 W

K 4 4 p 1 of 1
cor. code attach.



Collection of Various Surveys

Misc. I. C. S. NOTES

SOURCE:

TRANSCRIBED from ORIGINAL on file at
DUPLICATE

REMON. OFFICE

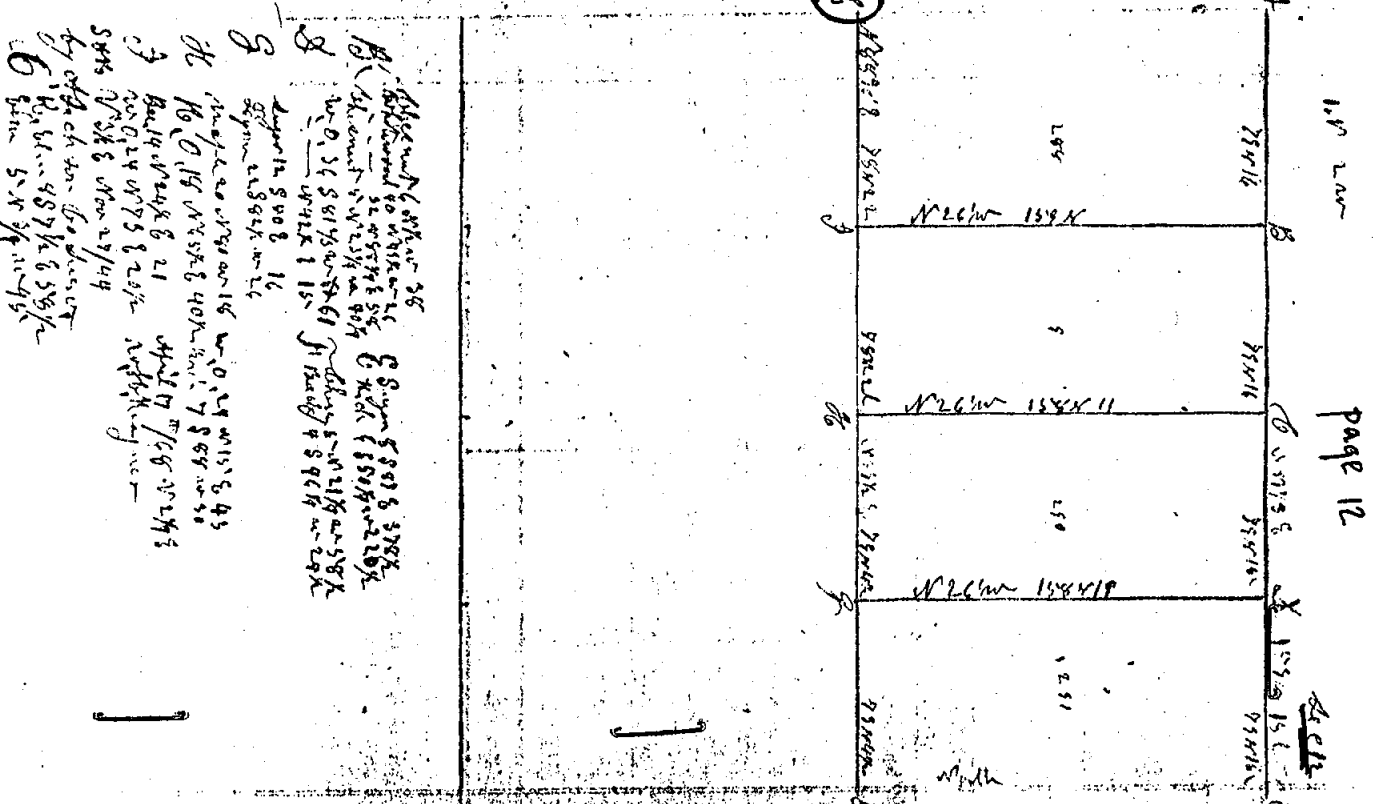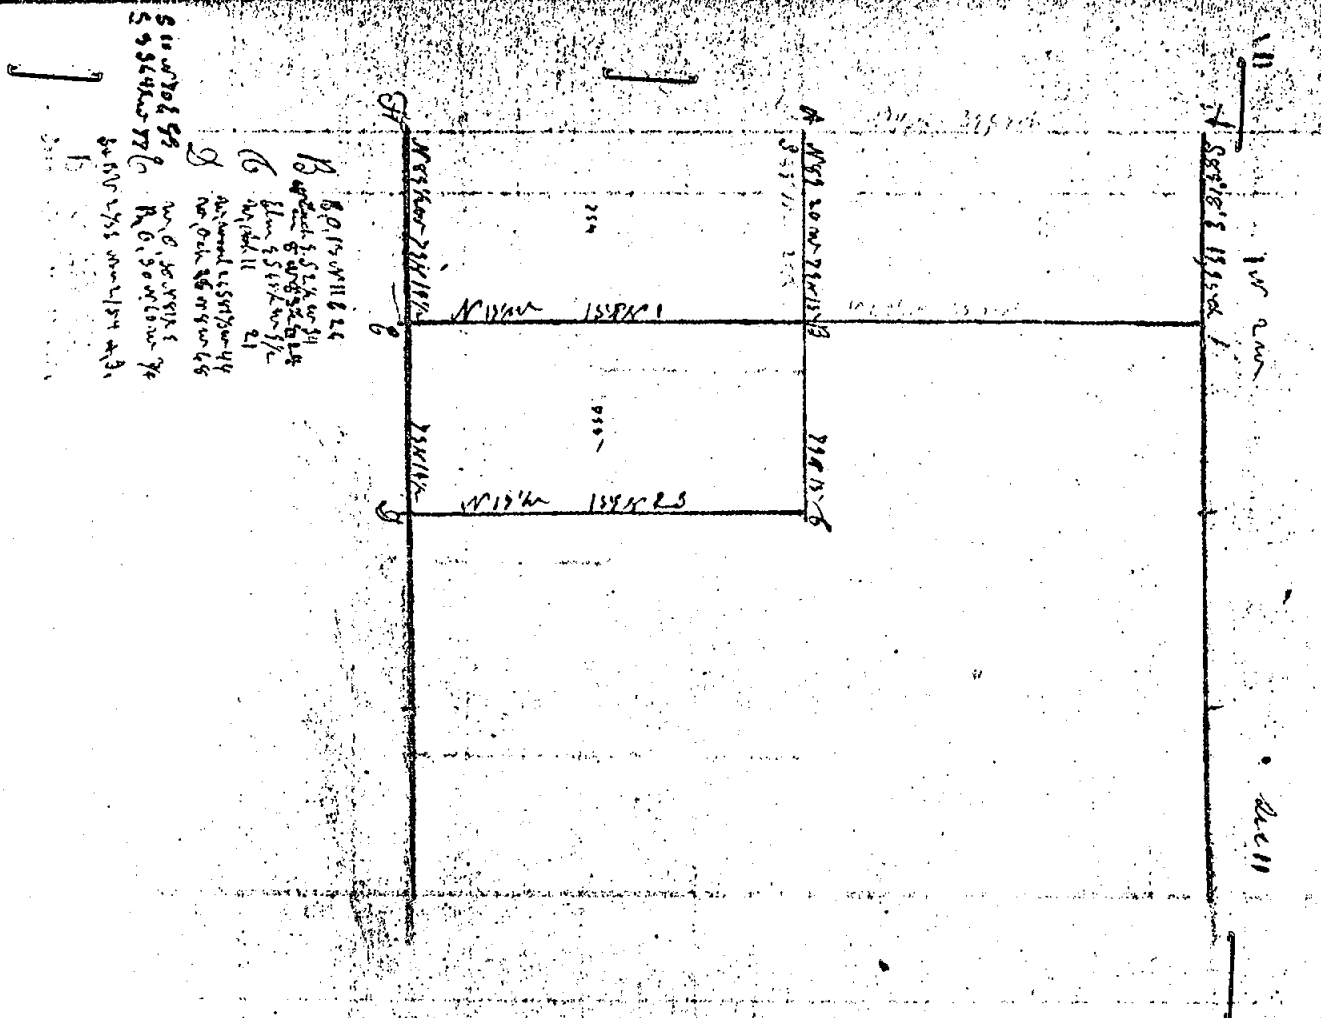

no witness shown for
corner "K"

ONONDAGA T1NR2W
K 5

1	2	3	4	5	6	7	8	9	10	11	12	13
A	B	C	D	E	F	G	H	I	J	K	L	M
6	5	4	3	2								
7	8	9	10	11	12							
18	17	16	15	14	13							
19	20	21	22	23	24							
30	29	28	27	26	25							
31	32	33	34	35	36							

11516

• 30



-
- A hand-drawn map showing a street intersection. The vertical street is labeled "EDGAR RD." and the horizontal street is labeled "COVERT RD.". A small building is located at the intersection, with a distance of "100.00" marked from the intersection to the building. Four numbered locations are marked: (1) is a small circle on the right side of Edgar Rd.; (2) is a small circle on the right side of Covert Rd.; (3) is a small circle on the left side of Edgar Rd.; (4) is a small circle on the left side of Covert Rd. A small building is also located on the right side of Edgar Rd., with a distance of "100.00" marked from the intersection to the building. The building is labeled "HOUSE 3990 COVERT RD.".

<u>RECORDED</u> Research Record:		attachment number(s)	no. of sheets	researched by	reviewed by
Corner Recordation Certificate Liber Page <i>1</i> <i>331</i>		<i>1</i>	<i>1</i>	<i>ds</i>	<i>jeh</i>
Recorded Land Survey Liber Page					
Recorded Subdivision Plat Liber Page					
MDSHT Right-of-Way Maps Sheet No.					
Ingham County Road Comm. Maps Sheet No.					
Record of the Ingham County Surveyor Vol. Page Year					
General Land Office Maps Sheet No.					
Form 280, Gov't. Monument Witness Record					
Ingham County Drain Comm. File No.					
East Lansing City Engineer					
Lansing Public Service Office Cade's 1921 Survey p.					
Lansing Public Service Office J.B. Davis' Field Notes p.					
G.L.O. Field Notes					
Misc. I.C. S. Notes					
Field Recon. Form		<i>2</i>	<i>1</i>	<i>ds</i>	<i>jeh</i>
RESEARCH COMPLETED date	Total	Total			
Consumers Power Company Sheet No. Index No.					
Chesepeak & Ohio Railroad Co. Val. Sec. Drawer Sheet					
RESEARCH COMPLETED date	Total	Total			
REMARKS					

SOURCE: CORNER RECORDATION CERTIFICATE L 1 P 331

TRANSCRIBED from ORIGINAL on file at REMONS. OFFICE
DUPLICATE

LAND CORNER RECORDATION CERTIFICATE

FILING REQUIREMENT OF ACT 74, MICH. P.A. 1970

FOR CORNERS OF:	LOCATED IN:	CORNER CODE NUMBER
1. PUBLIC LAND SURVEY <u>Sec. 11</u> T <u>1</u> N, R <u>2</u> W		<u>J-5</u> <u>K-5</u>
2. PROPERTY CONTROLLING IN SECTION		
3. MISCELLANEOUS PROPERTY IN SECTION		
4. LOT NO.	RECORDED PLAT	
5. PRIVATE CLAIMS		

FILED
DEC 16 2 36 PM '71
REGISTER OF DEEDS
Min Ball Humphrey
INGHAM COUNTY, MICH.
REGISTER OF DEEDS STAMP AND FILING NUMBER

I, Lawrence J. Hendryx, do hereby certify that under requirements of P.A. 74, Michigan P.A. of 1970, the corner points mentioned in lines 1 and 2 above (identified with circles on index code diagram—over) were, in a field survey on Sept 20 1971, established, re-established, monumented, re-monumented, recovered or restored as expressed below and in conformance with regulations and rules therefore as required in the current manual of survey instructions of the United States Department of the Interior, Bureau of Land Management or by a decree of a court of law. Furthermore, that the corner points mentioned in lines 3, 4 and 5 above were, in a field survey on 19, found, recovered, restored, established or re-established as expressed below and in conformance with the rules of the Michigan State Board of Registration for Land Surveyors or, by a Decree of a Court of law:

A. Description of original monument and accessories and/or subsequent restoration:

K-5 SE 1/4 Sec 11, T1N, R2W
20" Walnut NW 1/4 61.6
Center 6" Ash SW 70.13
6" Walnut SE 59.3
10" Walnut NW 68.0
found blue stone from old witnesses
Set 25 Reinf bar

B. Description of corner evidence found and/or method applied in restoring or re-establishing corner:

C. Description of monument for corner and accessories established to perpetuate locating the position of the corner:

J-5 S 1/4 Sec 11, T1N, R2W
Set 25 Reinf bar
Anchor post N 35
Found line 8 35
Center 18" Walnut NW 54.67
16" Walnut ENE 50.5



SIGNED BY Lawrence J. Hendryx

DATE Sept 20, 1971

SURVEYOR'S MICHIGAN REGISTRATION NO. 3276

FOR STATE AND UNITED STATES AGENCIES:

SIGNED BY _____ CHIEF OF SURVEY PARTY

DATE _____

APPROVED AND SIGNED BY _____ MICHIGAN REGISTERED LAND SURVEYOR

DATE _____

SURVEYOR'S MICHIGAN REGISTRATION NO.

Form No. 10, 1970
Revised by M.S.B. 10/1/70, 10/1/71

FORM APPROVED BY MICHIGAN STATE BOARD OF REGISTRATION, JAN 20, 1971
DISTRIBUTED BY MICHIGAN SOCIETY OF REGISTERED LAND SURVEYORS

166

ONONDAGA TWSP. T 1 N, R 2 W

K-5 1 p 1 of 1
cor. code attach.

SOURCE: Preliminary Corner Field Inspection

TRANSCRIBED from ORIGINAL on file at Remonumentation Office

PRELIMINARY CORNER FIELD INSPECTION

Date Nov. 9, 1977

CORNER
CODE K-5

Team Mark Y.

TWP Onondaga

Dave K

Corner: RECORDED

Road Name Covert & Edgar

Road Surface: CONCRETE ASPHALT GRAVEL OTHER: _____

FILL CUT Section

VISIBLE MONUMENT EVIDENCE: ☒ Monument Box

PARTIALLY COVERED WITH TAR

☐ Pipe


☐ Iron Bar

☐ Nail

☐ Other: _____

☐ No Evidence Visible

MONUMENT LOCATION (Relative to centerline of road)

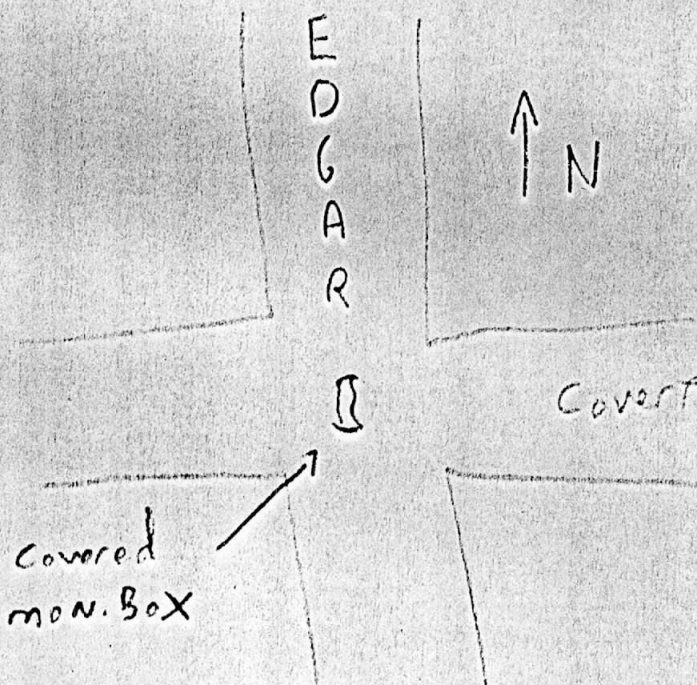

Remarks:

Covered
mon. Box

Onondaga TWSP. T1 N, R2W

K5
cor. code

2
attach.

p 1 of 1

LAND CORNER RECORDATION CERTIFICATE

FILING REQUIREMENT OF ACT 74, MICH. P.A. 1970

FOR CORNERS OF -	LOCATED IN -	CORNER CODE NUMBER
1. PUBLIC LAND SURVEY..... T. 1 N. R. 2 W. 4		L-5
2. PROPERTY CONTROLLING IN SECTION..... T. N. R. E. W.		
3. MISCELLANEOUS PROPERTY IN SECTION..... T. N. R. E. W.		
4. LOT NO., RECORDED PLAT		
5. PRIVATE CLAIMS		

24 P329

REGISTER OF DEEDS STAMP AND FILING NUMBER

I, Ronnie M. Lester, do hereby certify that under requirements of P.A. 74, Michigan P.A. of 1970, the corner points mentioned in lines 1 and 2 above were, in a field survey on June 6, 1978, established, re-established, monumented, re-monumented, recovered or restored as expressed below and in conformance with regulations and rules therefore as required in the current manual of survey instructions of the United States Department of the Interior, Bureau of Land Management or by a decree of a court of law. Furthermore, that the corner points mentioned in lines 3, 4 and 5 above were, in a field survey on _____, 19____, found, recovered, restored, established or re-established as expressed below and in conformance with the rules of the Michigan State Board of Registration for Land Surveyors or, by a Decree of a Court of law:

A. Description of original monument and accessories and/or subsequent restoration:

L-5
Post set by Harvey Parke in original government survey between October, 1825 and January, 1826.
Corner identified as stone by A.P. Drake, County Surveyor, in survey dated April 23, 1877 (v.3, p.129).

B. Description of corner evidence found and/or method applied in restoring or re-establishing corner:

L-5
Excavated a 7.5' x 7.5' hole to an average depth of 1.5' in the centerline of Covert Road and on a fence line to the south. Found an axe head, surrounded by red brick, with blunt end facing up + 1.5' west of fence line to south, + 3.0' north of centerline of Covert Road, 1.4' below surface. Found pointed stone surrounded by red brick + 1.0' west of fence line to south, + 3.0' north of centerline of Covert Road and 1.2' below surface. Accepted pointed stone for corner as described by Drake. Measured + 2625' west to K-5 and + 2625' east to M-5.
Excavation conducted by Ingham County Survey and Remonumentation Project crew.

C. Description of monument for corner and accessories established to perpetuate locating the position of the corner.

L-5
North $\frac{1}{4}$ Corner, Section 13, T1N-R2W
Set 4" x 36" concrete monument with $\frac{1}{2}$ " x 38" rerod with cap #18998, with concrete collar and cover in location of pointed stone described above:
Nail & tag, #18998, east side Power Pole, NE, 27.82'
Nail & tag, #18998, east side Power Pole, South, 53.04'
SW corner stone foundation of house #3750, Covert Road, NW, 106.49'
Centerline of bolt, west side, + 1.0' from top of angle iron Anchor Post, WNW, 86.86'

SIGNED BY

Ronnie M. Lester


DATE

8/31/78

SURVEYOR'S MICHIGAN REGISTRATION NO. 18998

XXXXXXXXXXXXXXXXXXXXXXXXXXXX


SIGNED BY

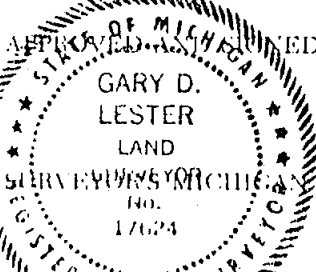

CHIEF OF SURVEY PARTY
[Signature]
MICHIGAN REGISTERED LAND SURVEYOR
Director, Ingham County Survey and Remonumentation Project

DATE

8-31-78

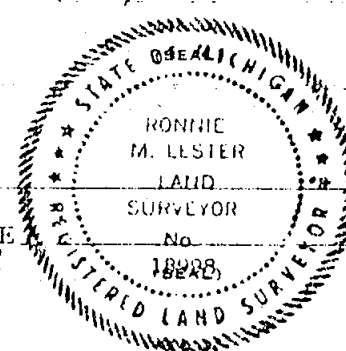


TOWNSHIP _____
 COMPANY _____ CORNER CODE 1.5
 FIELD SQUAD 7-1 RECORDED CORNER NO
 DATE 6/6/78 ROAD NAME COUERT

Sketch, witness, and describe monuments found, and location relative to traverse point and centerline of road.

- N
- SET CONCRETE MONUMENT 1.0' WEST OF FENCE LINE SOUTH 1/2 POSS. LINE NORTH, 3.2' NORTH OF E. AT PT "B" OF EXCAVATIONS 6/6/78
 - WITNESSED AS FOLLOWS:
- D G 27.82 1) SET N/T (PLS "18998") E/S POWER POLE, N 30° E, 27.83 J.S.
- 63.06 2) SET N/T (PLS "18998") E/S POWER POLE, S 05° E, 63.05 side of angle
- 86.83 3) BOLT ON SUPPORT BRACE TO WEST, 1' ± FROM TOP OF ANGLE IRON ANCHOR POST, N 70° W, 86.90
- 106.42 4) S.W. CORNER STONE FOUNDATION HOUSE #3750 COUERT RD N. 30° W. 106.55

SET FORTH WITNESS, CHECKED THE
 REST OF THE WITNESSES
 8/3/78 C. EVERITT Sq. #11

O.K.

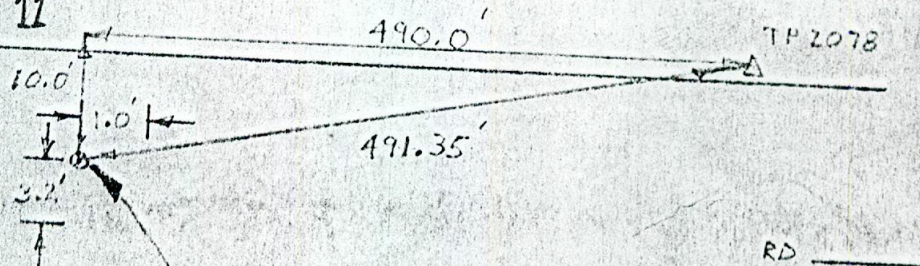

SET CONCRETE MONUMENT
 36" x 4" DIA. W/ 1/2" REBAR IN
 CENTER PROTRUDING 3" ABOVE
 CONCR. MON. W/ CAP (PLS "18998")
 8/2/78 Sq 11 SET MON. BOX

TECH. SUP'R. L. BRYAN TOWNSHIP DNDNDAGA
 COMPANY POLARIS CORNER CODE L-5
 FIELD SQUAD #4 MARTIN RECORDED CORNER NO
 DATE 6.6.78 ROAD NAME COVERT


Sketch, witness, and describe monuments found, and location relative to traverse point and centerline of road.

N
 • SET CONCRETE MONUMENT 1.0' WEST OF FENCE LINE SOUTH & POSS. LINE NORTH, & 3.2' NORTH OF E. AT PT "B" OF EXCAVATION 6/6/78

• WITNESSED AS FOLLOWS:

- 1) SET N/T (RLS #18998) E/S POWER POLE, N 30° E, 27.82'
- 2) SET N/T (RLS #18998) E/S POWER POLE, S 05° E, 63.04'
- 3) SW EDGE OF ANGLE IRON ANCHOR POST, N 70° W, 86.86'

CHRIS,
 NEED FOURTH
 WITNESS!
 R.M.

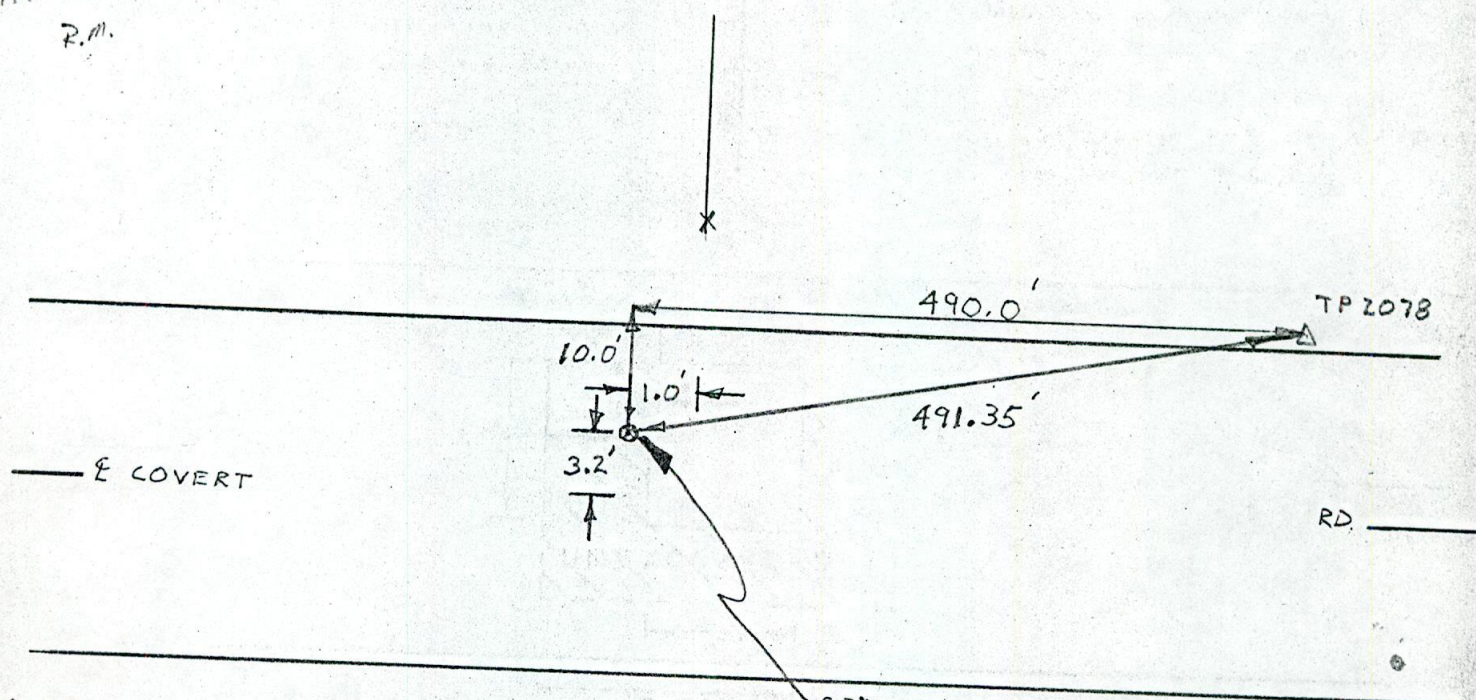

EXCELLENT CORNER
 GOOD EVIDENCE

L. BRYAN

SET CONCRETE MONUMENT
 36" X 4" DIA. W/ 1/2" REBAR IN
 CENTER PROTRUDING 3" ABOVE
 CONCR. MON. W/ CAP (RLS #18998)
 8/2/78 Sq. II SET MON. BOX

50-60 YR. FENCE

TECH. SUP'R. L. BRYAN TOWNSHIP ONONDAGA
 COMPANY POLARIS CORNER CODE 1.5
 FIELD SQUAD #1 MARTIN PAGE 1 OF 1 DATE 6.6.78

EXCAVATED AREA: 43.75 SQ. FT.; AVG. DEPTH 1.5' SURFACE ASPHALT

Sketch and describe roads, monuments found or set, and witnesses established:

- N

PT. "A"

 - 1) FD. 60 PENNY NAIL E/S ANCH. POST NORTH 23.64'
 - 2) SET PK NAIL IN ASPHALT N 70° W 3.53'
 - 3) SET PK NAIL IN ASPHALT N 70° E 7.36'

PT. "B"

 - 1) FD. 60 PENNY NAIL E/S ANCH. POST NORTH 23.74'
 - 2) SET PK NAIL IN ASPHALT N 70° W 3.78'
 - 3) SET PK NAIL IN ASPHALT N 70° E 7.13'

PT. "A"


FD. AXE HEAD W/ BLUNT END
 FACING UP 1.6' WEST OF
 FENCE LINE & POSS. LINE
 3.2' NORTH OF E & 1.4' BELOW
 ROAD SURFACE.
 .60' WEST OF PT. "B"

POSS. LINE

↓

PT. "B"

FD. POINTED STONE 1.0' WEST
 OF FENCE LINE & POSS. LINE
 3.2' NORTH OF E & 1.2' BELOW
 ROAD SURFACE. .60' EAST OF
 PT. "A". AS CALLED FOR BY A.D. DRAKE,
 SEE ATTACHMENT ~~4~~ #3

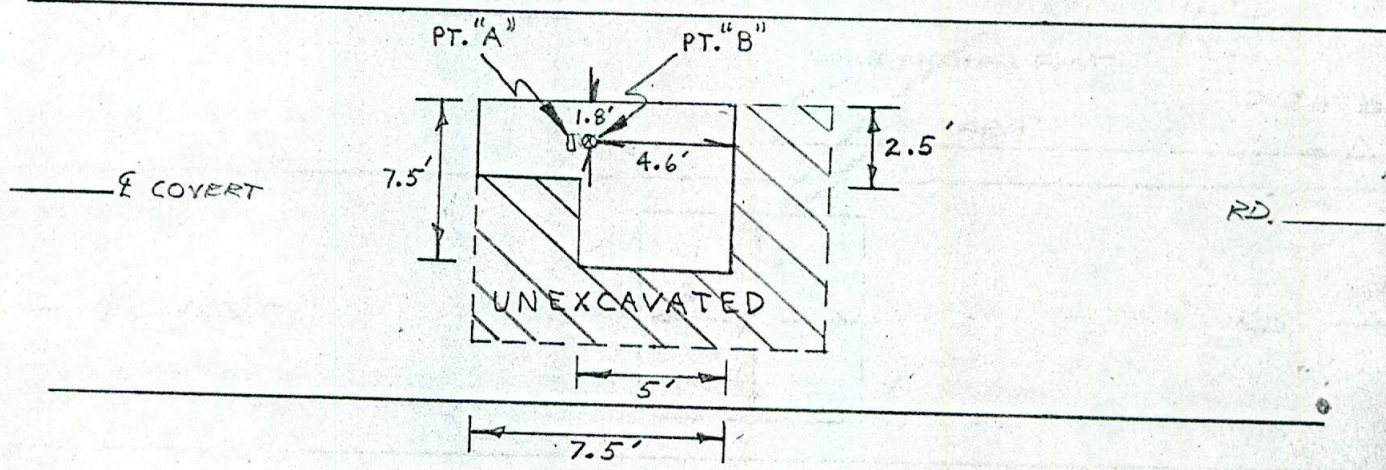

NOTE: BOTH PT.'S WERE FOUND IN
 APPROX. 3" OF CLAY LOCATED
 BENEATH RD. GRAVEL WHICH
 WAS UNDER ASPHALT. BOTH
 PT.'S WERE SURROUNDED BY
 RED BRICK.

TEGH. SUP'R. L. BRYAN TOWNSHIP ONODAGA

COMPANY POLARIS CORNER CODE L. 5

FIELD SQUAD #9 MINSHALL ROAD NAME COVERT RD. / ASPHALT

Sketch, witness, and describe monuments found and proposed excavation site relative to traverse point and centerline of road.



BEGIN EXCAVATION AT A POINT 489' WEST OF TP 2078 (ON FENCE LINE TO SOUTH) & IN 1/2 OF ROAD. 26.8 S. OF ANCHOR GD 5' ALL DIRECTIONS. N. SIDE OF RD.



4-26-78


4" Blacktop

RES.
3750
COVERT RD.

excavate
here *ML*

LONG ANCHOR POST TP 2078
489'

1/2 COVERT

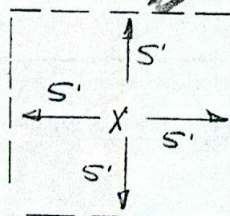

RD.

OK
4/28/78
NB



LOOK FOR STONE

OK *M*

TRAVERSE POINT WITNESS REPORT

Traverse Point No. 2078

Tech. Sup'r. Larry B

Township Oneida

Company Polaris

Recorded
Corner
Code

Field Squad #7 David Kost

Date 12-28-77


Sketch and describe roads, monuments found or set, and witness established:

1 N. 20.23 To OAK TREE 20 in Dim

2 NE 23.34 To Fence Post

3 SSE 77.69 To Power Pole

4

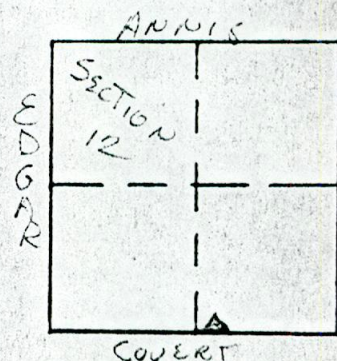

CORN

SET 1/2" BAR Y CAP

COVERT RD

HOUSE #
3705 COVERT

INGHAM COUNTY SURVEY and REMONUMENTATION PROJECT

Township ONONDAGA, T 1 N, R 2 W
 Corner Code L-5

Research Record:	attachment number(s)	no. of sheets	researched by	reviewed by
Corner Recordation Certificate Liber <u>4</u> Page <u>329</u>	<u>ND</u>	<u>1</u>	<u>CEM</u>	<u>J.M.</u>
Recorded Land Survey Liber _____ Page _____	<u>ND</u>		<u>CEM</u>	<u>"</u>
Recorded Subdivision Plat Liber _____ Page _____	<u>ND</u>		<u>CEM</u>	<u>"</u>
MDSHT Right-of-Way Maps Sheet No. _____	<u>ND</u>		<u>CEM</u>	<u>"</u>
Ingham County Road Comm. Maps Sheet No. _____	<u>ND</u>			<u>"</u>
Record of the Ingham County Surveyor Vol. <u>3</u> Page <u>129</u> Year <u>1877</u>	<u>3</u>	<u>1</u>	<u>CEM</u>	<u>J.M.</u>
General Land Office Maps Sheet No. _____	<u>ND</u>		<u>CEM</u>	<u>"</u>
Form 280, Gov't. Monument Witness Record	<u>ND</u>		<u>CEM</u>	<u>"</u>
Ingham County Drain Comm. File No. <u>293</u>	<u>4</u>	<u>1</u>	<u>CEM</u>	<u>"</u>
East Lansing City Engineer	<u>ND</u>		<u>CEM</u>	<u>"</u>
Lansing Public Service Office Cade's 1921 Survey p.	<u>ND</u>		<u>CEM</u>	<u>"</u>
Lansing Public Service Office J.B. Davis' Field Notes p.	<u>ND</u>		<u>CEM</u>	<u>"</u>
G.L.O. Field Notes <u>p.32</u>	<u>2</u>	<u>1</u>	<u>CEM</u>	<u>J.M.</u>
Misc. I.C. S. Notes	<u>ND</u>		<u>CEM</u>	<u>"</u>
Field Recon. Form	<u>1</u>	<u>1</u>	<u>CEM</u>	<u>J.M.</u>
RESEARCH COMPLETED	Total	Total		
Consumers Power Company Sheet No. _____ Index No. _____	<u>ND</u>		<u>CEM</u>	<u>J.M.</u>
Chesepeak & Ohio Railroad Co. Val. _____ Sec. _____ Drawer Sheet _____	<u>ND</u>		<u>CEM</u>	<u>"</u>
RESEARCH COMPLETED	Total	Total		
REMARKS				
<u>NOTHSTONE NOTES</u>	<u>N.D.</u>		<u>LALONDE</u>	
<u>FOLDER #1 P. 17, 19</u>	<u>5/6</u>	<u>1/1</u>		
<u>FOLDER #2</u>	<u>N.D.</u>			
<u>To Laura Type</u>				

SOURCE: PRELIM. CORNER FIELD INSPECTION

TRANSCRIBED from ORIGINAL on file at REMON. OFFICE
DUPLICATE

PRELIMINARY CORNER FIELD INSPECTION

Date Nov. 9, 1977

CORNER
CODE L-5

Team Mark Y.

TWP Onondaga

Dave K.

Corner: ~~RECORDED~~
UNRECORDED

Road Name Covert west of Ridley

Road Surface: CONCRETE ASPHALT GRAVEL OTHER: _____

FILL CUT Section

VISIBLE MONUMENT EVIDENCE: _____ Monument Box

_____ Pipe

_____ Iron Bar

_____ Nail

_____ Other: CPCO # 73

V No Evidence Visible ON ROAD

MONUMENT LOCATION (Relative to centerline of road)

Remarks:

Metal plug on phone pole NORTH OF Road

ONONDAGA
township

T 1 N, R 2 SW

L-5
corner code attachment no.

p. 1 of 1

SOURCE: REC. CO. SURVEYOR Vol. 3 p. 129TRANSCRIBED from ORIGINAL on file at REMUN. OFFICE
DUPLICATESURVEYOR'S NAME A.P. DRAKE SURVEYOR NO. _____DATE OF SURVEY APR. 23, 1877 SECTION NO. 13MAGNETIC VARIATION 1° 52' E


Corners described

Corners	Timber	Dia	Bearing	Links	Corners	Timber	Dia	Bearing	Links
A. a Stone	Cherry	4	S 40° 14' W	47	Ch. a Post	Beech	12	N 34° 40' W	16
" "	"	4	S 49° 14' W	72 1/4	" "	Soul "	20	S 79° 1' E	39
B. a Post	Buckthorn	10	S 63° E	112 1/2	" "	Maple	10	S 23° E	28
C. a Stone in centre of Highway	Apple tree	8	N 47° 40' E	91	" "	"	10	N 17° 1/2' W	21 1/2
D. a Post	Maple	20	S 20° 40' E	103	* This is the original corner made by Jackson, Jan. 1st 1839				

Note: The corner C. was lost, but the corresponding corner in T. 1 N. - R. 1 W. established by Mr. Jackson, was readily found, and this corner was located at its proper distance south of its being nine links therefore.

T. 1 N. - R. 1 W.


Section 13

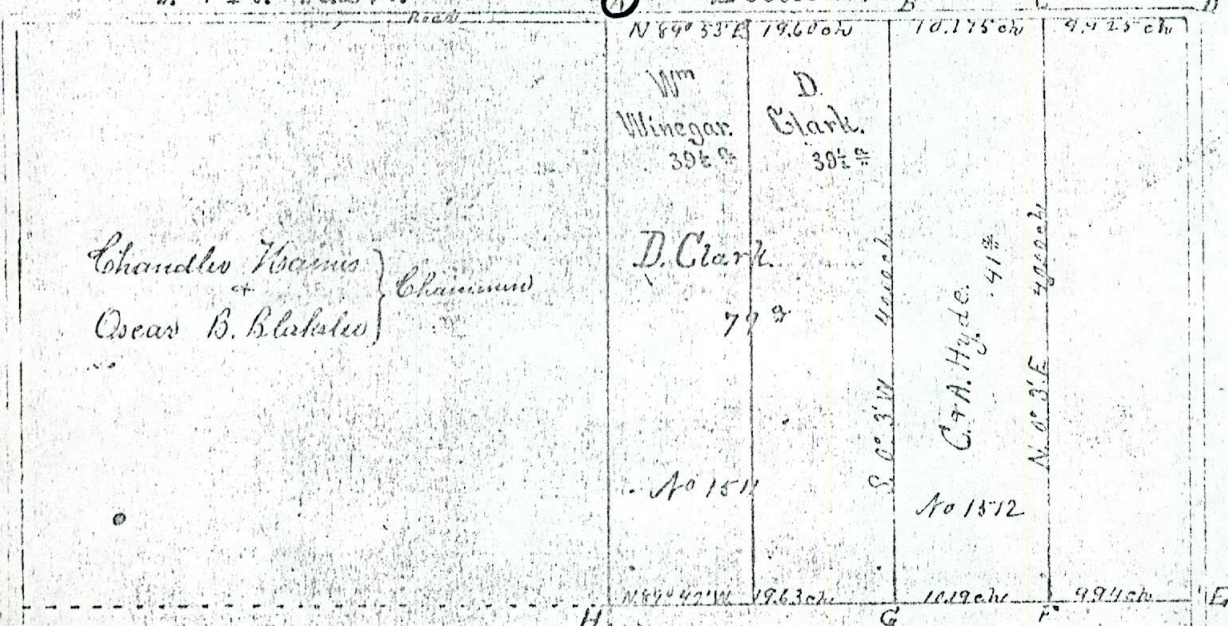

NOTE: No 1511 was subsequently divided equally by D. Clark, and Wm Winegar and the corner P. witnessed by a Red Oak, 18 inches diam. S. 86 1/2° W. 15 l.

Done Oct. 16th 1882A.P. Drake
Co. Surveyor

Run by the true meridian, Mag. var. 1° 52' E
Surveyed April 23, 1877 and recorded
May 28, 1877 By A.P. Drake
Co. Surveyor

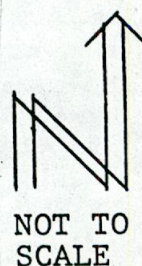NOT TO
SCALEONONDAGA
TOWNSHIP

T 1 N, R 2 W

L-5
CORNER CODE3
ATTACHMENT NO.

P. 1 of 1

SOURCE: DRAIN FILE #293

TRANSCRIBED from ORIGINAL on file at INGHAM COUNTY DRAIN COMMISSION.
DUPLICATE

L-5
M-3

ALC. 1 & 12

293
ONONDAGA

SURVEY OF THE PERRY CREEK EXTENSION DRAIN.

Survey of the Perry Creek Extension Drain, located on section 1 and 12, Town 1 North Range 2 West, Meridian of Michigan, Onondaga Township, Ingham County, State of Michigan, the centerline thereof being described as follows:

Commencing at the lower terminus thereof at a point 30 feet N and 980 feet E of the S $\frac{1}{4}$ -post of said section 12, town and range aforesaid, thence over and across the S E $\frac{1}{4}$ of said section 12, Montell Byrum, owner, as follows: Commencing at the point above described, viz: 30 feet N and 980 feet E of the S $\frac{1}{4}$ -post of said section 12, thence N 29° 0' E 545 feet, thence N 19° 14' E 383 feet, then N 3° 22' E 472 feet, thence N 9° 29' W 400 feet, thence N 19° 9' E 900 feet, thence N 10° 3' E 56 feet to station 27 plus 56 in the N line of said lands at a point 31 feet E of the N $\frac{1}{8}$ post of the S E $\frac{1}{4}$ of said section 12, town and range aforesaid. The total length of said drain on said lands is 2756 feet.


L-5

ONONDAGA TWSP. T 1 N, R 2 W

L-5 4 cor. code attach. p 1 of 1

SOURCE: FOLDER #1

P. 17

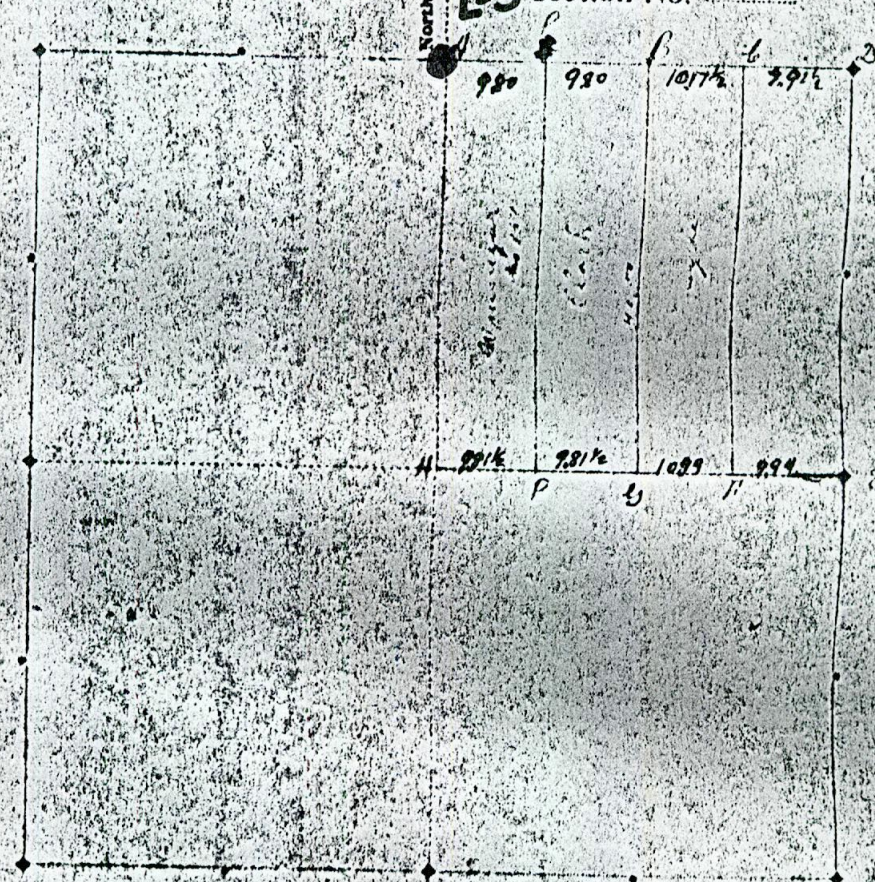TRANSCRIBED from RECORDS on file at REMON. OFFICETown 1 N. Range 2 W.Section No. 1

L-5

Section	Timber	Diam	Bearing	Links	Section	Timber	Diam	Bearing	Links
A	Stone cherry	4	S 4 W	47					
B	Butternut	10	S 63 E	112 1/2					
C	Stone	"	"	"					
D	Apple	8	N 103 E	91					
E	Apple	8	S 63 E	108					
F	Beech	12	N 38 E	16					
G	Apple	8	S 63 E	29					
H	Apple	10	S 63 E	28					
I	Apple	10	N 103 E	22 1/2					
J	Apple	10	N 103 E	22 1/2					

Reference to the first of the four corners of the section established by section

Run by the true meridian. Magnetic variation 1 degrees 19 minutes W.

Surveyed the 2 day of Apr 1887 by

J. P. Drake

The line of the County Surveyor of Ingham County, Michigan. Sec. B
8.36 W 151 made but to that day which point it is

ONONDAGA
township


T 1 N. R 2 W

L-5
corner code attachment no.

p. 1 of 1

SOURCE: FOLDER #1

P. 19

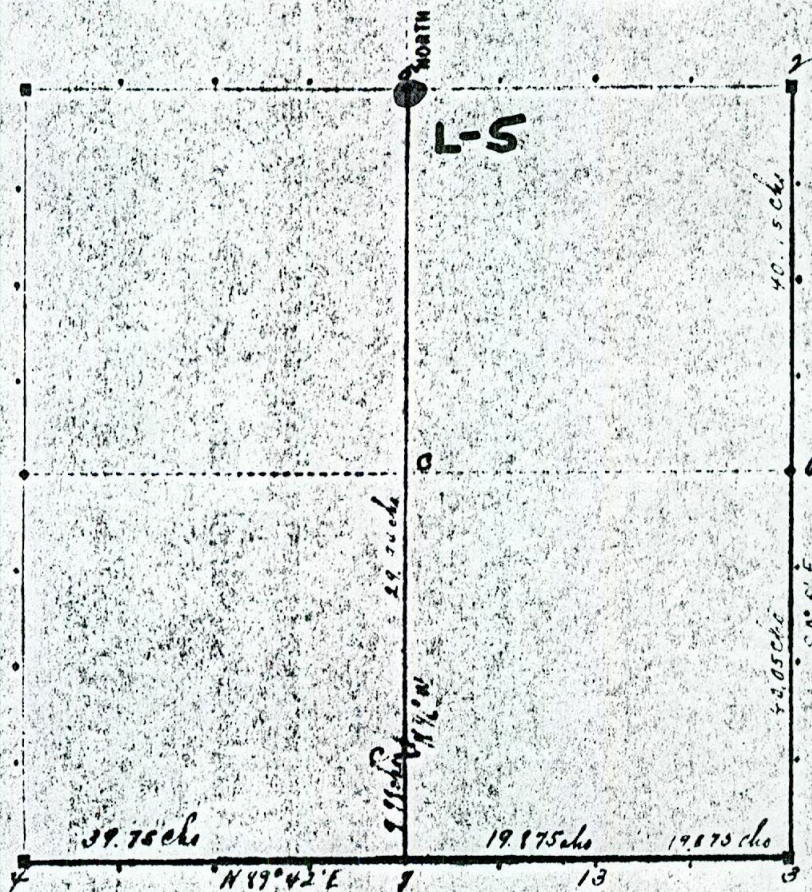TRANSCRIBED from DUPLICATE on file at REMON. OFFICETown. 1 N., Range. 24 W.Section No. 13

Sec.	Timber.	Diam.	Bearing.	Links.	Sec.	Timber.	Diam.	Bearing.	Links.
C	Post O.W.B.				13	Set stone with stone around			
2	Stone in the center of Section				C	Set stone	6	S 73° 4' W	19
3	Stone set with small stone					Whiteoak	12	S 10° 4' E	38
	Hick	10	N 16° W	108		Os. Oak	14	N 2° 1/2' E	68
	Apple	14	S 39° E	72					
4	Stone								
	W Oak	12	N 20° E	113					
	Set W Oak	12	N 37° W	89					
	Ark Cherry	6	S 25° 4' N	63					
6	Old post								
	Butternut	6	N 68° 32' E	37					
		8	N 26° 4' E	64					
7	Set stone								
	Sugar	10	N 66° W	55					
	W Oak	4	S 64° W	60					

Run by the true meridian. Magnetic variation, degrees 10 minutesSurveyed the 28 & 29 day of August, 1900, by

E. G. Collins
 Deputy County Surveyor of Ingham County, Mich.

Sec. 13

ONONDAGA
 township

T 1 N, R 24 W

L-5
 corner code attachment no.

p. 1 of 1

INGHAM COUNTY SURVEY and REMONUMENTATION PROJECT

Township ONONDAGA , T 1 N , R 2 W
 Corner Code L-4

Research Record:	attachment number(s)	no. of sheets	researched by	reviewed by
Corner Recordation Certificate Liber Page	ND		CEM	J.M.
Recorded Land Survey Liber Page	ND		CEM	"
Recorded Subdivision Plat Liber Page	ND		CEM	"
MDSHT Right-of-Way Maps Sheet No.	ND		CEM	"
Ingham County Road Comm. Maps Sheet No.	ND		CEM	"
Record of the Ingham County Surveyor Vol. <u>1</u> Page <u>26</u> Year <u>1844</u>	<u>1</u>	<u>2</u>	CEM	J.M.
General Land Office Maps Sheet No.	ND		CEM	"
Form 280, Gov't. Monument Witness Record	ND		CEM	"
Ingham County Drain Comm. File No.	ND		CEM	"
East Lansing City Engineer	ND		CEM	"
Lansing Public Service Office Cade's 1921 Survey p.	ND		CEM	"
Lansing Public Service Office J.B. Davis' Field Notes p.	ND		CEM	"
G.L.O. Field Notes	ND		CEM	"
Misc. I.C. S. Notes <u>COMB. VARIOUS FIELD NOTES p12</u>	<u>2</u>		CEM	J.M.
Field Recon. Form	ND		CEM	"
RESEARCH COMPLETED date	Total	Total		
Consumers Power Company Sheet No. Index No.	ND		CEM	J.M.
Chesepeak & Ohio Railroad Co. Val. Sec. Drawer Sheet	ND		CEM	"
RESEARCH COMPLETED date	Total	Total		
REMARKS <u>NOTHSTINE NOTES</u>	N.D.		LALONDE	
<u>FOLDER #1 P.15,16</u>	<u>3/4</u>	<u>1/1</u>	↓	
<u>FOLDER #2</u>	N.D.		↓	

SOURCE: REC. CO. SURVEYOR Vol. 1 p. 26

TRANSCRIBED from ORIGINAL on file at REMON. OFFICE
DUPLICATE


SURVEYOR'S NAME A. JACKSON SURVEYOR NO. _____

DATE OF SURVEY NOV. 27, 1844 SECTION NO. 12

MAGNETIC VARIATION 3 1/2 E

SEE P. 1 of 2 for MAP

WITNESSES ON P 2 of 2

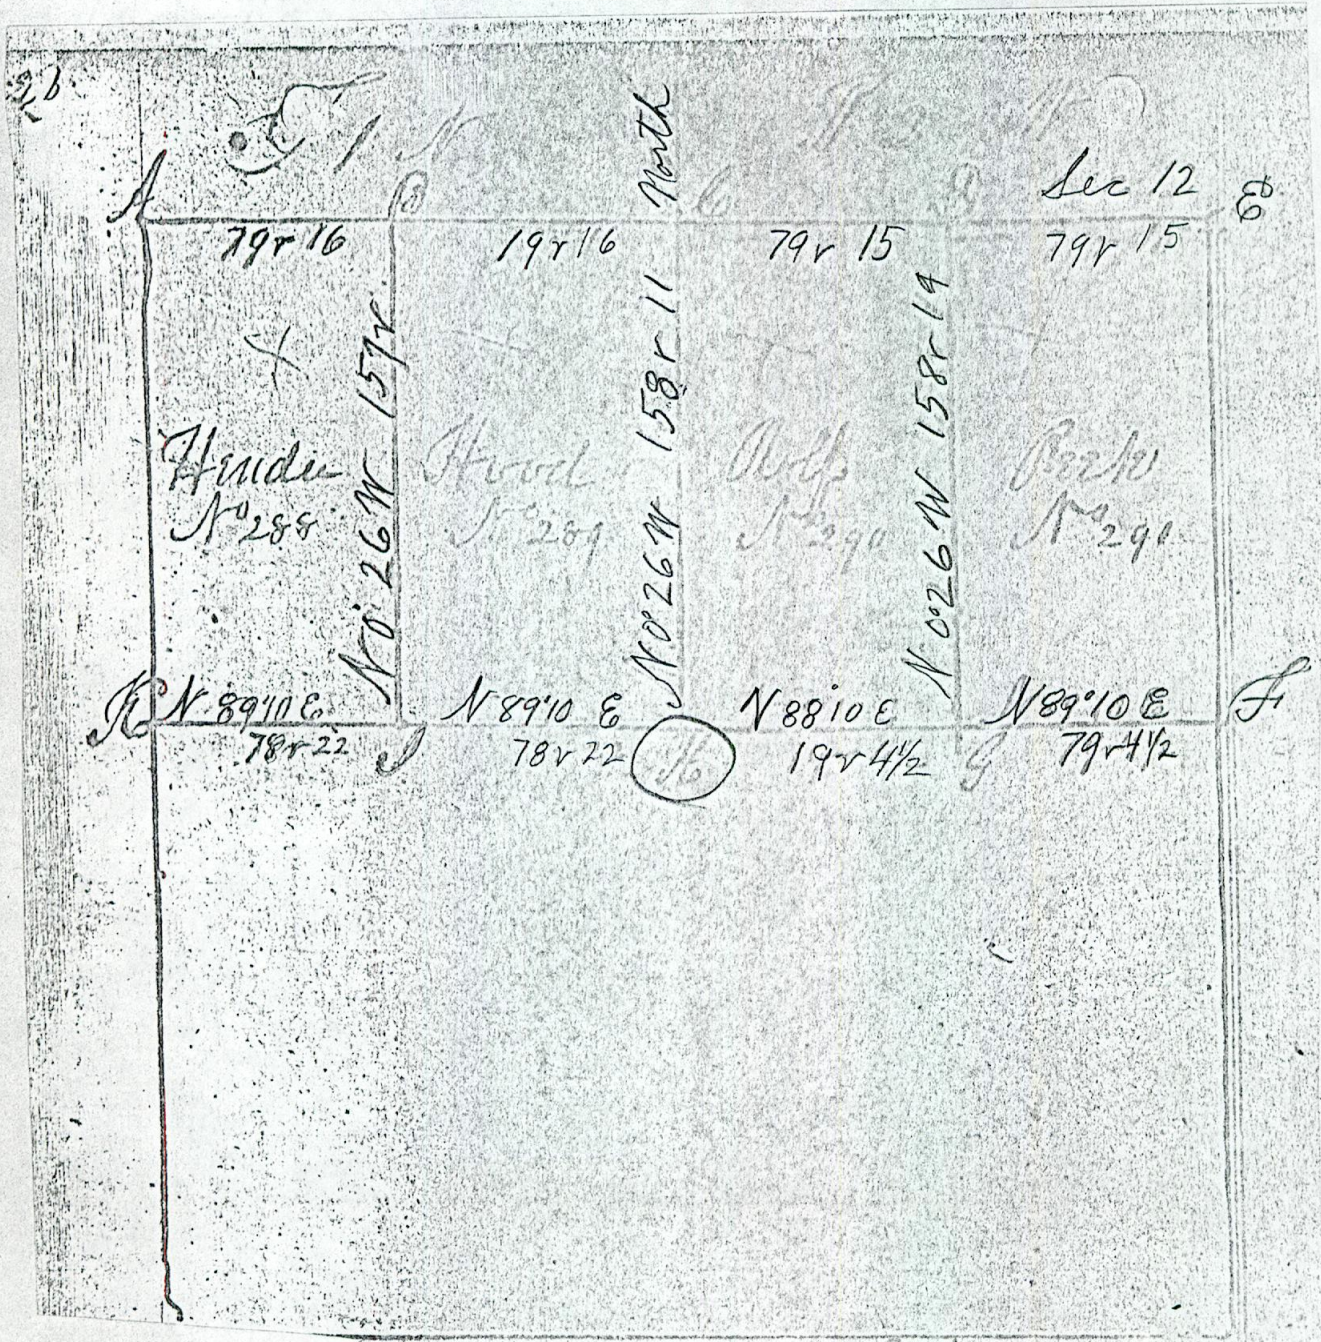

NOT TO SCALE

ONONDAGA
TOWNSHIP

T 1 N, R 2 W

1-4
CORNER CODE

1
ATTACHMENT NO.

P. 1 of 2


SOURCE: RECORD OF CO. SURVEYOR vol. 1 p. 26
 TRANSCRIBED from ORIGINAL on file at REMUN OFFICE
 DUPLICATE

SEE p. 1 of 2 for MAP

1	Tan	10	N 65 W	16	16	4	Sugar	12	S 50 E	16
2	B. Ash	10	N 81 E	13		5	Sym	20	S 82 1/2 W	26
3	Whitewoods	40	N 49 1/2 W	26		6	Molle	20	N 70 W	18
4	Whitewoods	32	N 83 3/4 E	58		7	B. Oak	18	N 65 1/2 E	40 1/2
5	B. Oak	20	S 64 E	30		8	Buck	11	N 24 1/2 E	21
6	Buck	10	N 72 W	33		9	W Oak	24	N 73 E	20 1/2
7	W Oak	36	S 81 2/3 W	61		10	S B. Ash	10	S 35 W	8
8	do	36	N 42 1/2 E	15		11	B. Ash	10	N 64 E	27
9	Buck	7	S 87 E	43						
10	Buck	9	S 50 1/4 W	63						
11	W ash	9	S 59 W	41						
12	Sugar	8	N 52 W	86						

Run by the town Municipal Vari 3/8 E
 Surveyed & recorded Nov 27 1844 by
 A Jackson Co Surveyor

TRANSCRIBED from ~~ORIGINAL~~ on file at REMON. OFFICE
DUPLICATE

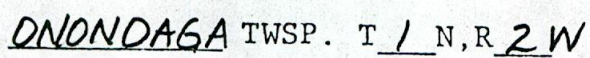

L-4 2 p 1 of 1
cor. code attach.


SOURCE: FOLDER #1

P. 15

TRANSCRIBED from ~~RECORD~~ on file at REMON. OFFICE

Town 1 N, Range 2 W

Section No. 12

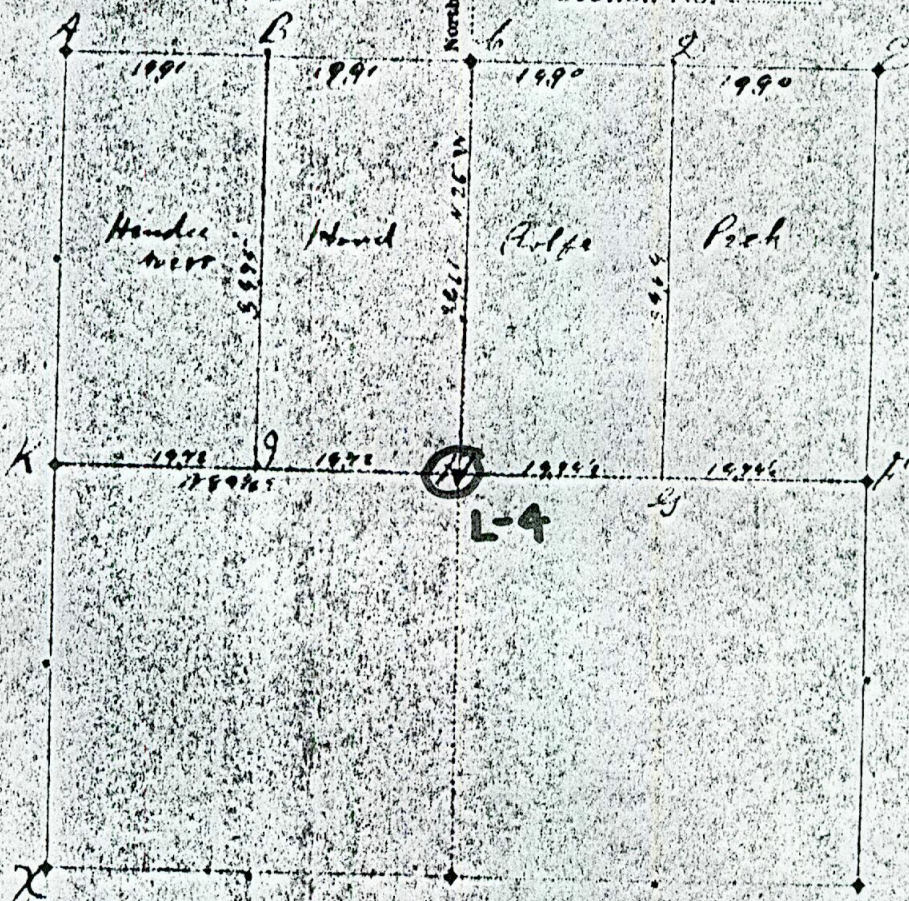

Section	Timber	Diam	Bearing	Links	Section	Timber	Diam	Bearing	Links
(new) X	Maple	3	S. 45° W.	60 6					
B	ash	40	N. 40° W.	26					
	a	32	N. 50° W.	55					
(new) G	H. Elm	5	S. 75° E.	55 5					
	Elm	5	N. 75° W.	75					
D	W Oak	36	S. 81° W.	61					
	a	36	N. 81° E.	15					
(new) E	Aspen	8	S. 87° E.	370					
	Aspen	6	S. 84° W.	212 4					
G	Aspen	12	S. 50° E.	16					
	Aspen	12	S. 81° W.	26					
H	Maple	10	N. 80° W.	14					
	H. Oak	18	N. 65° E.	40 2					
	Aspen	14	N. 24° E.	21					
	W Oak	24	N. 33° E.	20 6					

Run by the true meridian. Magnetic variation 3 degrees 12 minutes W

Surveyed the 27 day of Nov 1904 by

A. J. Oakes
County Surveyor of Ingham County, Michigan.

Sec. 12

15

ONONDAGA
township


T 1 N, R 2 W

L-4
corner code attachment no.

p. 1 of 1

SOURCE: FOLDER #1

P. 16

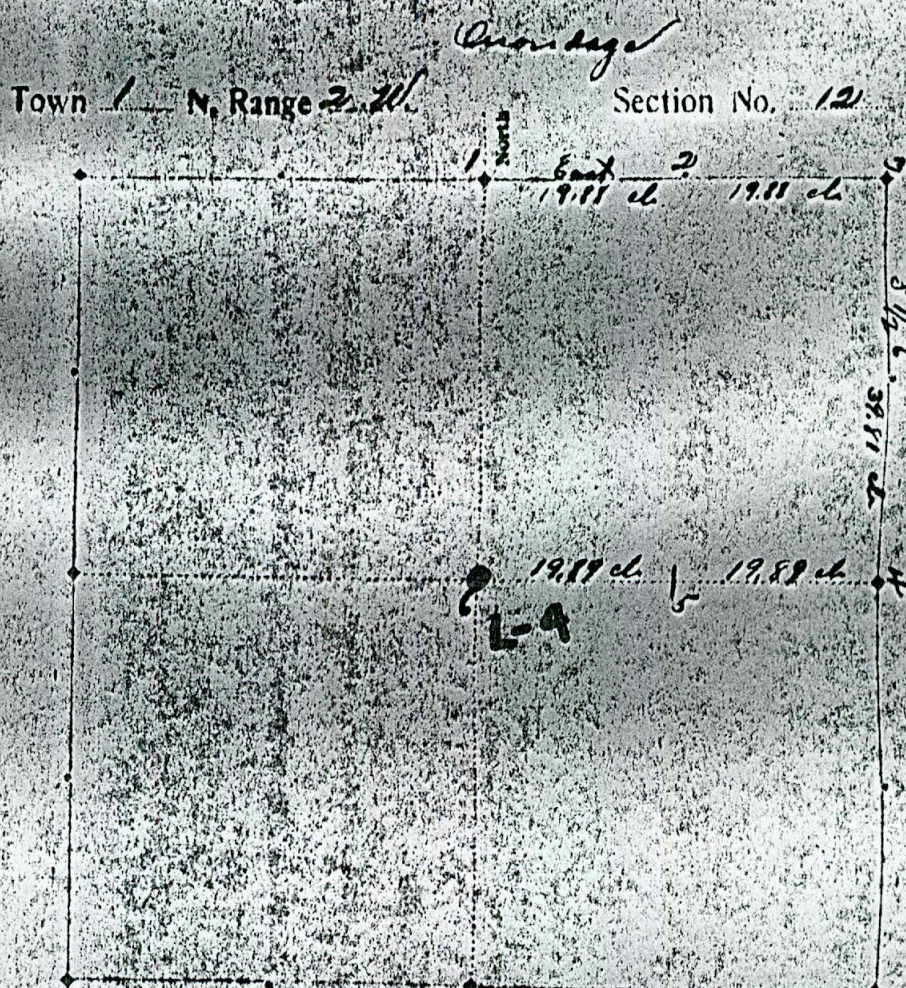TRANSCRIBED from ~~XXXXXXXX~~ on file at REMON. OFFICE

Section	Timber	Diam	Bearing	Links	Notes	Timber	Diam	Bearing	Links
1	Long white stone	14	S 10° E	57					
2	Long white stone	14	N 34° E	48					
3	Long white stone	12	N 44° E	106					
4	Long white stone	12	S 41° E	106					
5	Long white stone	12	S 63° E	100					
6	Long white stone	12	S 84° E	399					
7	Long white stone	12	S 84° E	399					
8	Long white stone	12	S 84° E	399					
9	Long white stone	12	S 84° E	399					
10	Long white stone	12	S 84° E	399					
11	Long white stone	12	S 84° E	399					
12	Long white stone	12	S 84° E	399					

L-4

Run by the true meridian. Magnetic variation degrees minutes

Surveyed the 25 day of April 1898 byW. A. Remon

County Surveyor of Ingham County, Michigan.

Sec. 12

ONONDAGA
townshipT 1 N. R 2 Wcorner code L-4 attachment no. 4p. 1 of 1

INGHAM COUNTY SURVEY and REMONUMENTATION PROJECT

Township ONONDAGA , T 1 N , R 2W
 Corner Code M-4

Research Record:	attachment number(s)	no. of sheets	researched by	reviewed by
Corner Recordation Certificate Liber Page	NO DATA	—	DKH	
Recorded Land Survey Liber Page	"	—	"	
Recorded Subdivision Plat Liber Page	"	—	"	
MDSHT Right-of-Way Maps Sheet No.	"	—	"	
Ingham County Road Comm. Maps Sheet No.	"	—	"	
Record of the Ingham County Surveyor Vol. 1 Page 26 Year 1844	1		DKH	
General Land Office Maps Sheet No. # 11	2	1	DKH	
Form 280, Gov't. Monument Witness Record				
Ingham County Drain Comm. File No.				
East Lansing City Engineer	N/A		DKH	
Lansing Public Service Office Cade's 1921 Survey p.			↓	
Lansing Public Service Office J.B. Davis' Field Notes p.	1			
G.L.O. Field Notes	3	1		
Misc. I.C. S. Notes	4/5	4		
Field Recon. Form				
NOTHSTONE NOTES	N.D.		LALONDE	
RESEARCH COMPLETED date	Total	Total		
Consumers Power Company Sheet No. Index No.				
Chesapeake & Ohio Railroad Co. Val. Sec. Drawer Sheet				
FOLDER # 1 P. 15, 16	6/7	1/1	LALONDE	
FOLDER # 2	N.D.		↓	
RESEARCH COMPLETED date	Total	Total		
REMARKS				

SOURCE: RECORD OF THE COUNTY SURVEYOR VOL. 1 p26

TRANSCRIBED from ORIGINAL on file at REMON. OFFICE
DUPLICATE


SURVEYOR'S NAME A. JACKSON

SURVEYOR NO. _____

DATE OF SURVEY NOV. 27, 1844

SECTION NO. 12

MAGNETIC VARIATION 3/5° E 3/5

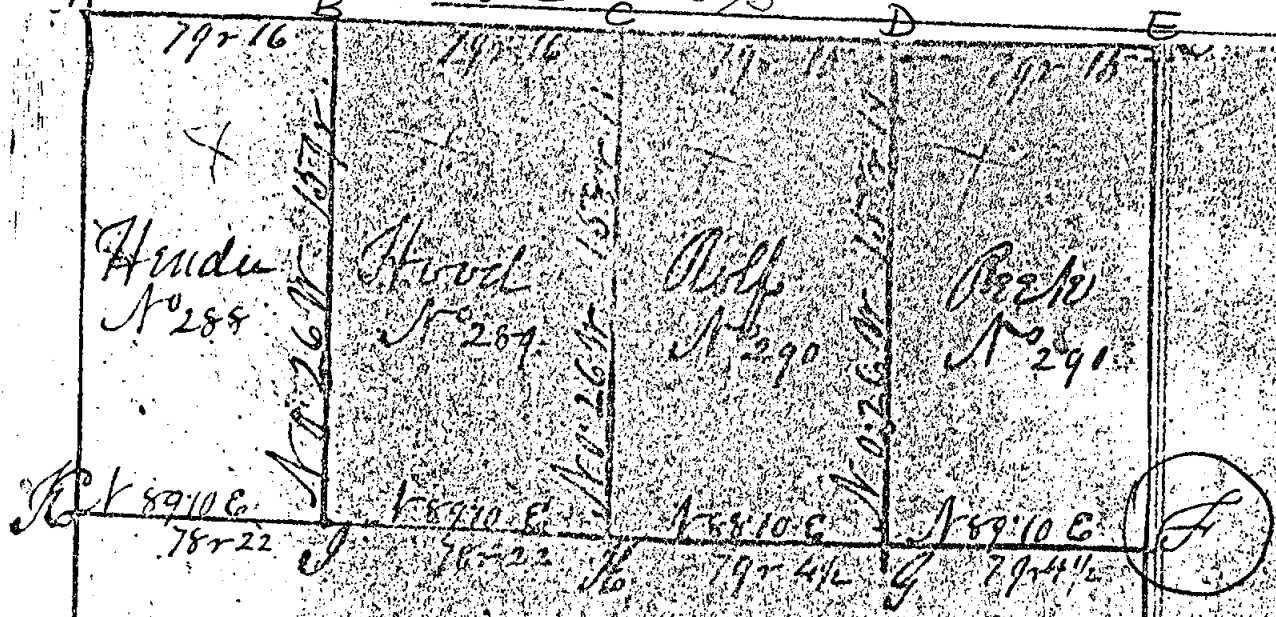

Tan	10	N 65 W	16	do	G Sugar	12	S 50 E	16
B Ash	10	N 81 E	13		Sym	20	S 82 1/2 W	26
Whitewoods	40	N 79 1/2 W	26		Maple	20	N 80 W	18
Whitewoods	32	N 83 3/4 E	56		Oak	18	N 65 1/2 E	40 1/2
B Oak	20	S 64 E	20		Bush	14	N 24 1/2 E	21
Bush	10	N 72 W	33		W Oak	24	N 73 E	20 1/2
W Oak	36	S 81 2/3 W	61		B Ash	10	S 35 W	8
do	36	N 42 1/2 E	15		O B Ash	10	N 64 E	27
Bush	7	S 57 E	43					
Bush	9	S 50 1/4 W	63					
W Oak	9	S 59 W	41					
Sugar	8	N 52 W	86					

ONONDAGA
TOWNSHIP

T 1 N, R 2 EW

M-4
CORNER CODE

ATTACHMENT NO.

P. 1 of 1

SOURCE: MISC. FIELD BOOK #15 p. 150

TRANSCRIBED from ORIGINAL on file at REMON. OFFICE
DUPLICATE

Sec. 12 Carroll

Survey of 1874 Sec 12

C. F. Brown & H. Dismuth, surveyors

Comm. at 4 1/4 post Sec 12 O.P.F.
a stone and stake set. Sec 14
S. 10° E. 58 1/2' L. & 26 1/4' S. 14 1/4' E. 45 1/2' L.

Thence east 1988 ch O.P.F. set
point stone 6 in square with cross
J.W. Hick 12 1/4 1/2 E. 106 1/4 L. & Hick
S. 41° E.

Thence east 1988 ch remains
of O.P.F. set long white stone and
brick post & crosskey for N.E. corner
of Sec. 12 J.W. Hick 13 1/2 1/2 W 100 L
and day. 112 1/2 S 88 1/2° E. 299 1/2 L.

Thence S 1/2° E 3981 ch O.P.F. &
Q.W. set brick post, long white stone
and brick for S.W. post Sec 12

Thence west 1989 ch O.P.F. &
Q.W. set stone & stake set. Thence
west in same line 1986 found
stone & small stone & remains
of old witnesses.

Set posts on line each 5.70 ch.
Surveyed Apr 25 1898 for C. F. Brown
and H. Dismuth.

I hereby certify that on the 25th
day of April (1898) surveyed
the line and established the
corners above described.


W. B. Brown, Sec. County
Clerk of Carroll County
I certify the location of

SEC. 12

M-4

TRANSCRIBED from ~~ORIGINAL~~
DUPLICATE on file at REMON. OFFICE

M-4 COLLECTION OF VARIOUS FIELD NOTES

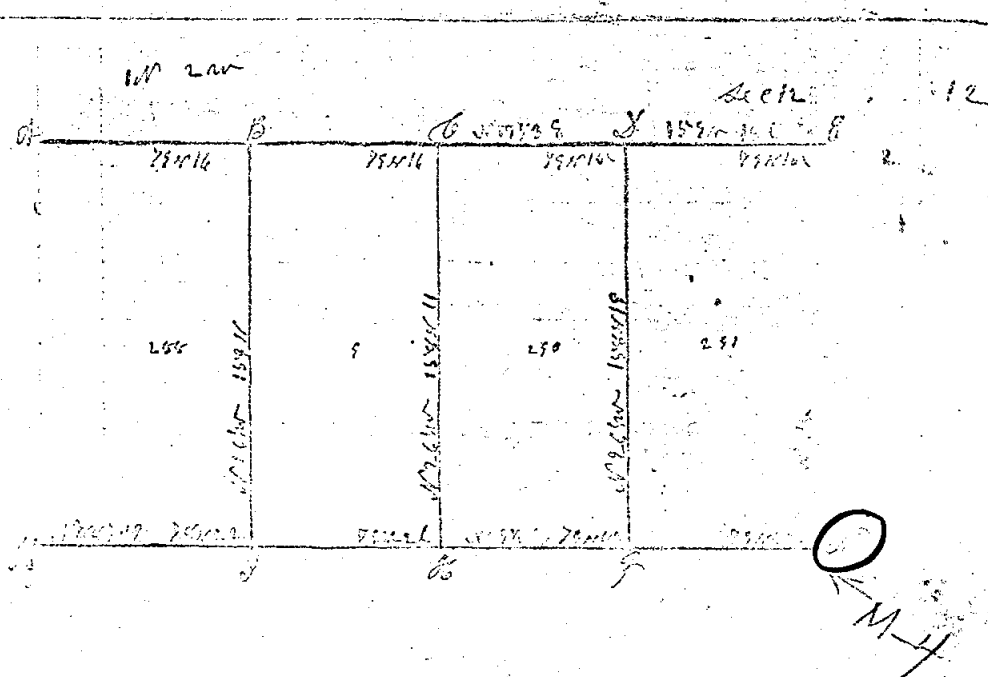
[illegible]

P. 15

TRANSCRIBED from ~~REDACTED~~ DUPLICATE on file at REMON. OFFICE

Town 7 N, Range 2 W.

Section No. 48

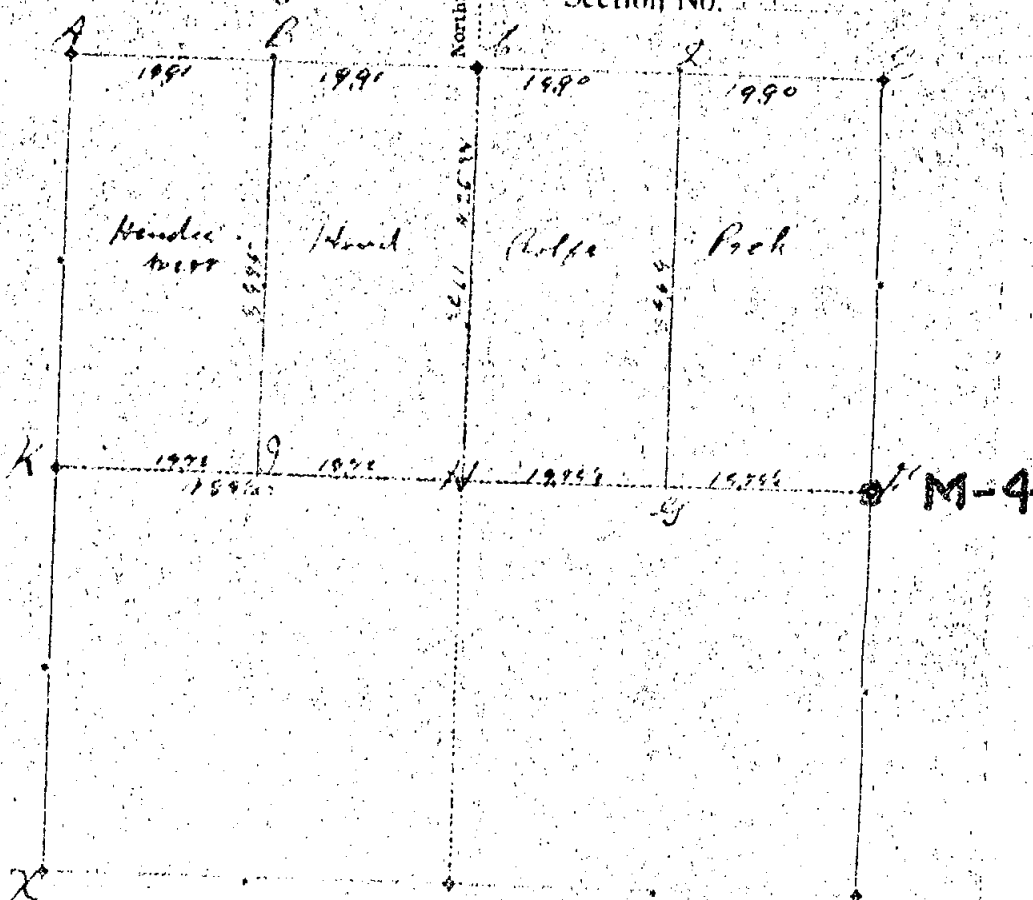[illegible]

Run by the true meridian. Magnetic variation 52 degrees 10 minutes W
 Surveyed the 27th day of Sept 1869 by

~~County Recorder of Ingham County, Michigan.~~

5cc. 12

15.

ONONDAGA
township

T 1 N, R 2 SW


M-4 6
corner code attachment no.

p. 1 of 1

SOURCE: FOLDER #1

P. 16

TRANSCRIBED from ~~RECORDS~~ on file at REMON. OFFICE

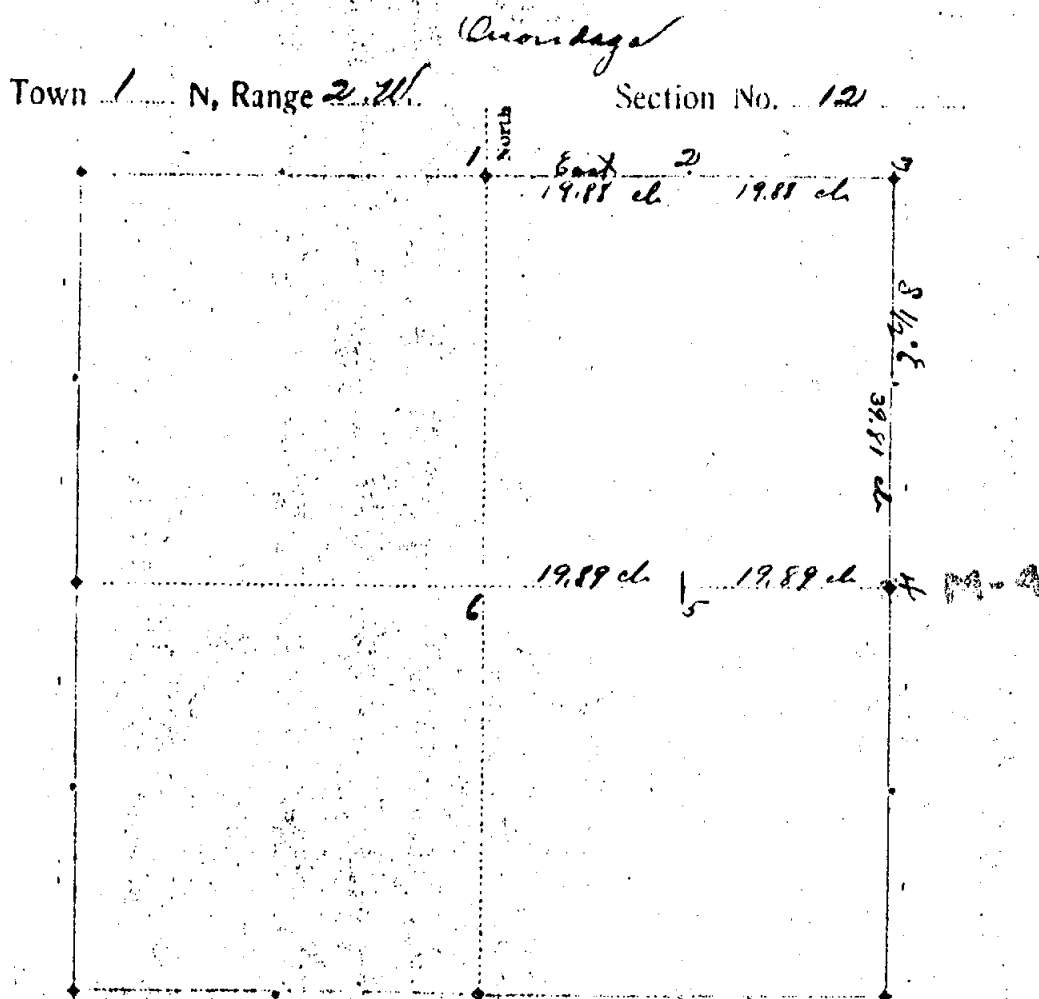

Section	Timber	Diam	Bearing	Links	Section	Timber	Diam	Bearing	Links
1	Long white Pine	14	S 10° E	57					
2	Long white Pine	14	N 34° E	48					
3	Long white Pine	12	N 42° E	106					
4	Long white Pine	12	S 41° E	—					
5	Long white Pine	12	S 62° E	100					
6	Long white Pine	12	S 83° E	299					
7	Long white Pine	12	S 83° E	299					
8	Long white Pine	12	S 83° E	299					
	O.P.T. & A.B. & C.								
	Stone and stake								
	Stone and small stone								

Run by the true meridian. Magnetic variation ... degrees ... minutes

Surveyed the 25 day of April 1898 by

W. A. Ross

County Surveyor of Ingham County, Michigan.

Sec. 12

ONONDAGA
township

T 1 N, R 2 W

M-4
corner code attachment no.


p. 1 of 1

SECTION 6A
T1N-R2W

M-5

41


	A	B	C	D	E	F	G	H	I	J	K	L	M
1	6	5	4	3	2	1							
2													
3	7	8	9	10	11	12							
4													
5	18	17	16	15	14	13							
6													
7													
8	19	20	21	22	23	24							
9													
10	30	29	28	27	26	25							
11													
12	31	32	33	34	35	36							
13													

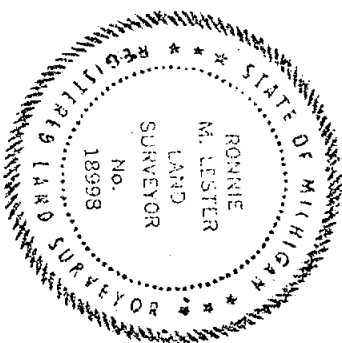

TECH. SUP'R. L.B. TOWNSHIP ONONDAGA
 COMPANY Polaris CORNER CODE M-5
 FIELD SQUAD L. Faust #6 RECORDED CORNER _____
 DATE 6-6-78 ROAD NAME Covert Rd.

Sketch, witness, and describe monuments found, and location relative to traverse point and centerline of road.

- FINAL WITNESSES:
- 1) set N.+T. on S.E. side Power Pole N. 45° E. 69.72'
 - 2) set N.+T. on S. side 16" Dia Pine N. 60° E. 80.02'
 - 3) set N.+T. on N.E. side Power Pole S. 80° E. 51.51'
 - 4) set N.+T. on E. side CORNER Post S. 65° W. 41.36'
 - 5) Monument w/cap (R.L.S. # 18998) Due N. 9.23'
 - 6) set N.+T. on E. side 36" Dia OAK S. 10° W. COULDN'T FIND

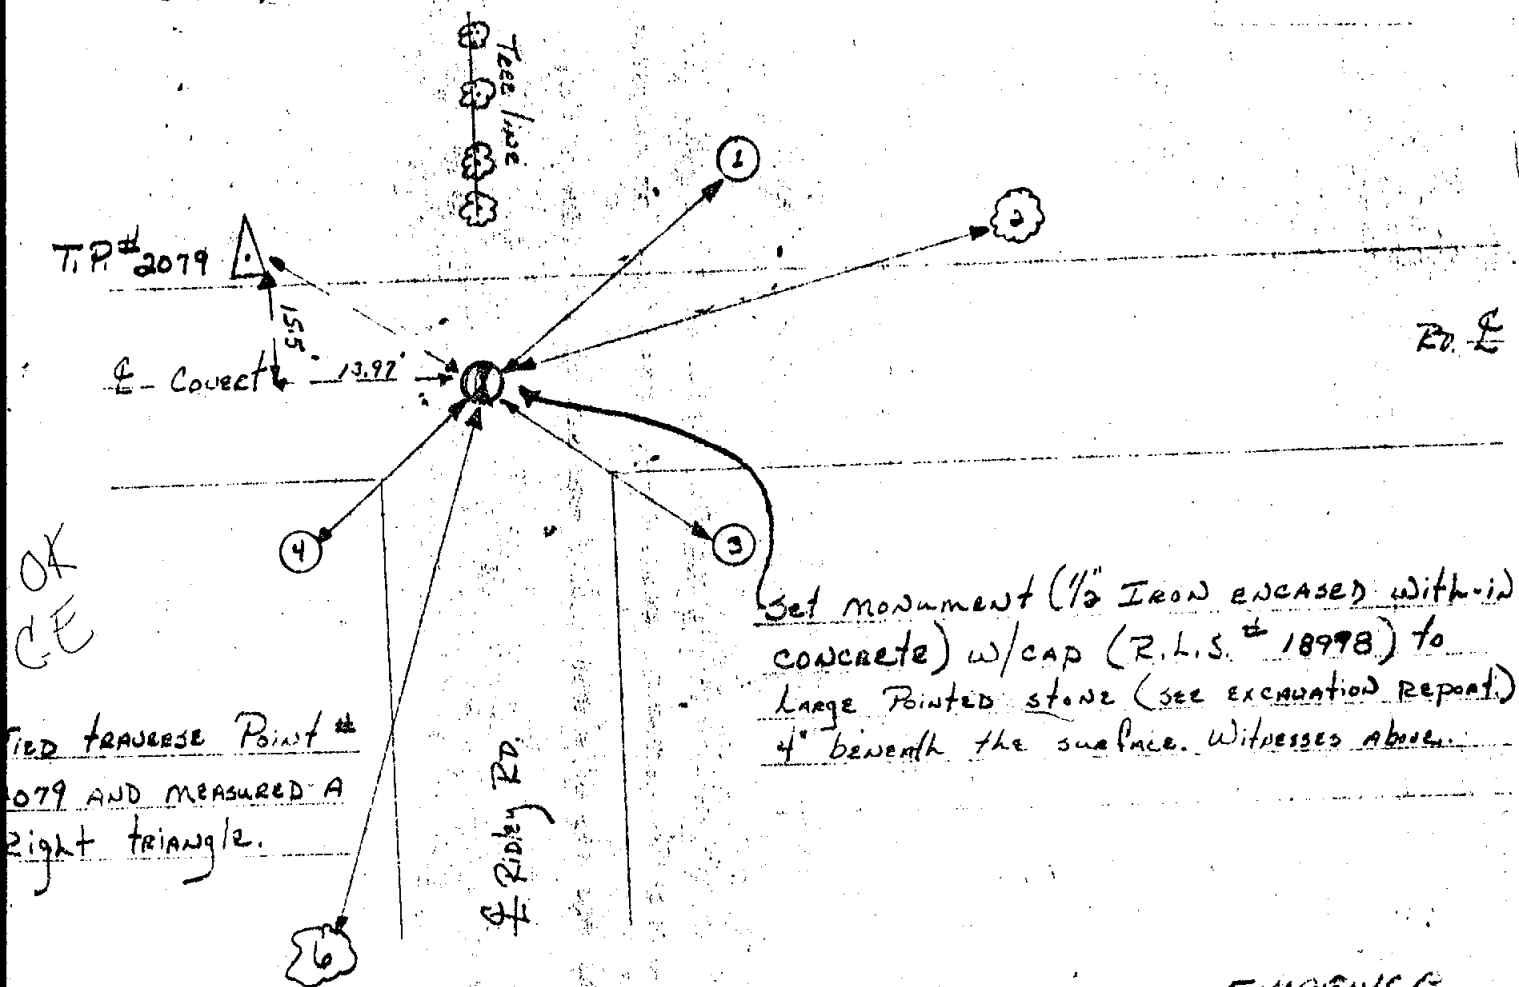

OK
CE
TIED TRAVERSE Point #
2079 AND MEASURED A
Right Triangle.

EXCELLENT CORNER ALSO FOUND SIMILAR EVIDENCE
 AT A-S LESLIE TWP.

L. BRYAN

3-26-78, Fld. Form No. 6

TECH. SUP'R. L. B. TOWNSHIP ONONDAGA
 COMPANY Polaris CORNER CODE M-5
 FIELD SQUAD L. Faust #6 PAGE 1 OF 1 DATE 6-6-78

EXCAVATED AREA: 4.7' by 4.8' SQ. FT.; AVG. DEPTH 3.4' SURFACE Asphalt

Sketch and describe roads, monuments found or set, and witnesses established:





FOUND

Lame pointed stone 1.9' below surface. Pt. "A" stone was surrounded by Red Brick. There were also 10, 11, 12, 13) which were AND REMOVED. (see sketch of monument present)

E-535,
S-332
S-334 E.
S-337 N.

Note: N. Edge of excavation is 10.73'
 S. of N. Edge Covert 20.

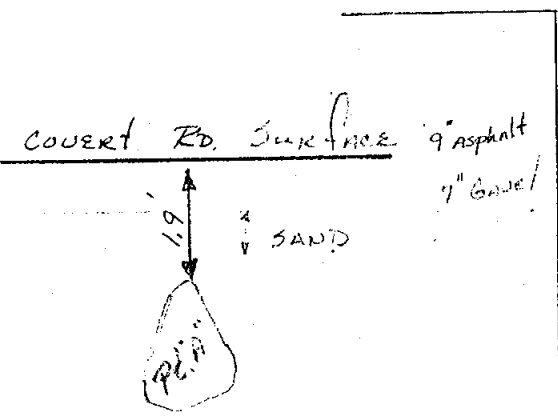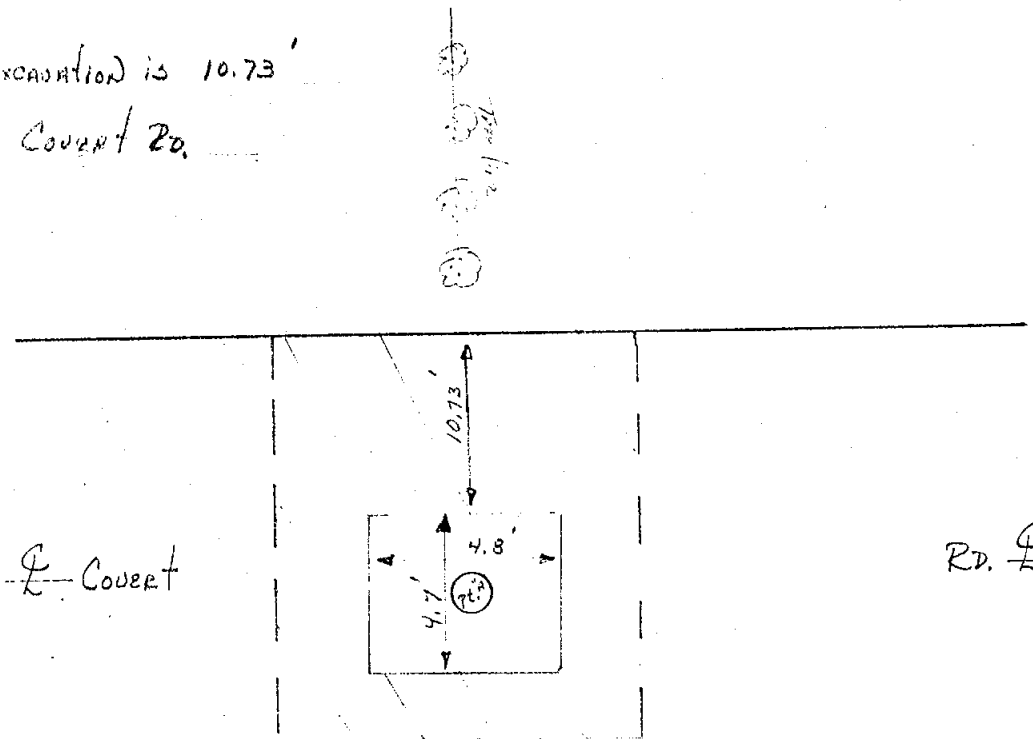

Ridley Rd.

Township ONONDAGA, T 1 N, R 2W
 Corner Code M-5

Research Record:	attachment number(s)	no. of sheets	researched by	reviewed by
Corner Recordation Certificate Liber <u>4</u> Page <u>275</u>	NO DATA	1	DKH	J.M.
Recorded Land Survey Liber _____ Page _____	"	-	"	"
Recorded Subdivision Plat Liber _____ Page _____	"	-	"	"
MDSHT Right-of-Way Maps Sheet No. _____	"	-	"	"
Ingham County Road Comm. Maps Sheet No. _____	"	-	"	"
Record of the Ingham County Surveyor Vol. <u>3</u> Page <u>129</u> Year <u>1877</u> <u>5</u> <u>13</u> <u>1900</u>	1 2	1 1	DKH	J.M.
General Land Office Maps # <u>11</u> Sheet No. _____	3	-	DKH	J.M.
Form 280, Gov't. Monument Witness Record	NO DATA	-	DKH	"
Ingham County Drain Comm. File No. <u>293</u>	4	1	DKH	J.M.
East Lansing City Engineer	N/A	-	DKH	"
Lansing Public Service Office Cade's 1921 Survey p. _____	↓	-	↓	"
Lansing Public Service Office J.B. Davis' Field Notes p. _____	↓	-	↓	"
G.L.O. Field Notes P. <u>10</u>	5	1	DKH	J.M.
Misc. I.C. S. Notes <u>see remarks</u>	6/7/8	1/1/1	DKH	J.M.
Field Recon. Form	9	1	DKH	J.M.
NOTHSTINE NOTES	N.D.			
RESEARCH COMPLETED date _____	Total	Total	LALDNDE	
Consumers Power Company Sheet No. _____ Index No. _____	NO DATA	-	DKH	J.M.
Chesapeake & Ohio Railroad Co. Val. _____ Sec. _____ Drawer Sheet _____	"	-	"	"
FOLDER #1 P. <u>17, 18, 19, 20</u>	<u>10/11/12/13</u>	<u>1/1/1</u>	LALDNDE	
FOLDER #2				
RESEARCH COMPLETED date _____	Total	Total	↓	
REMARKS				
Misc. Field Notes				
① Book #15 p. <u>80</u>				
② Book #15 p. <u>150</u>				
③ Book #16 p. <u>17</u>				

SOURCE: RECORD OF THE COUNTY SURVEYOR vol. 3 p. 129

TRANSCRIBED from ORIGINAL on file at REGISTER OF DEEDS
DUPLICATE

SURVEYOR'S NAME A. P. DRAKE

SURVEYOR NO. _____

DATE OF SURVEY APRIL 23, 1877

SECTION NO. 13

MAGNETIC VARIATION 1°52' E

A - STONE

CHERRY 4 S 40° W 47 LKS

" 4 S 49 3/4° W 72 1/2 LKS

B - POST

BUTTERNUT 10 S 63° E 112 1/2 LKS

C - STONE IN CENTER OF HIGHWAY

D - STONE

APPLE TREE 8 N 47 3/4° E 91 LKS.

E - POST

MAPLE 20 S 20 3/4° E 103 LKS

F - POST

BEECH 12 N 34 3/4° W 16 LKS

G - DOUB " 20 S 79° E 39 LKS

POST


* H - POST -

MAPLE 10 S 23° E 28 LKS


" 10 N 17 1/4° W 21 1/2 LKS

* This is the original corner made by A. Jackson. Jan 21st. 1839

Note: The corner E was lost, but the corresponding corner in T1N-R1W, established by Mr. Jackson was readily found, and this corner was located at its proper distance south of it, being nine links therefrom.

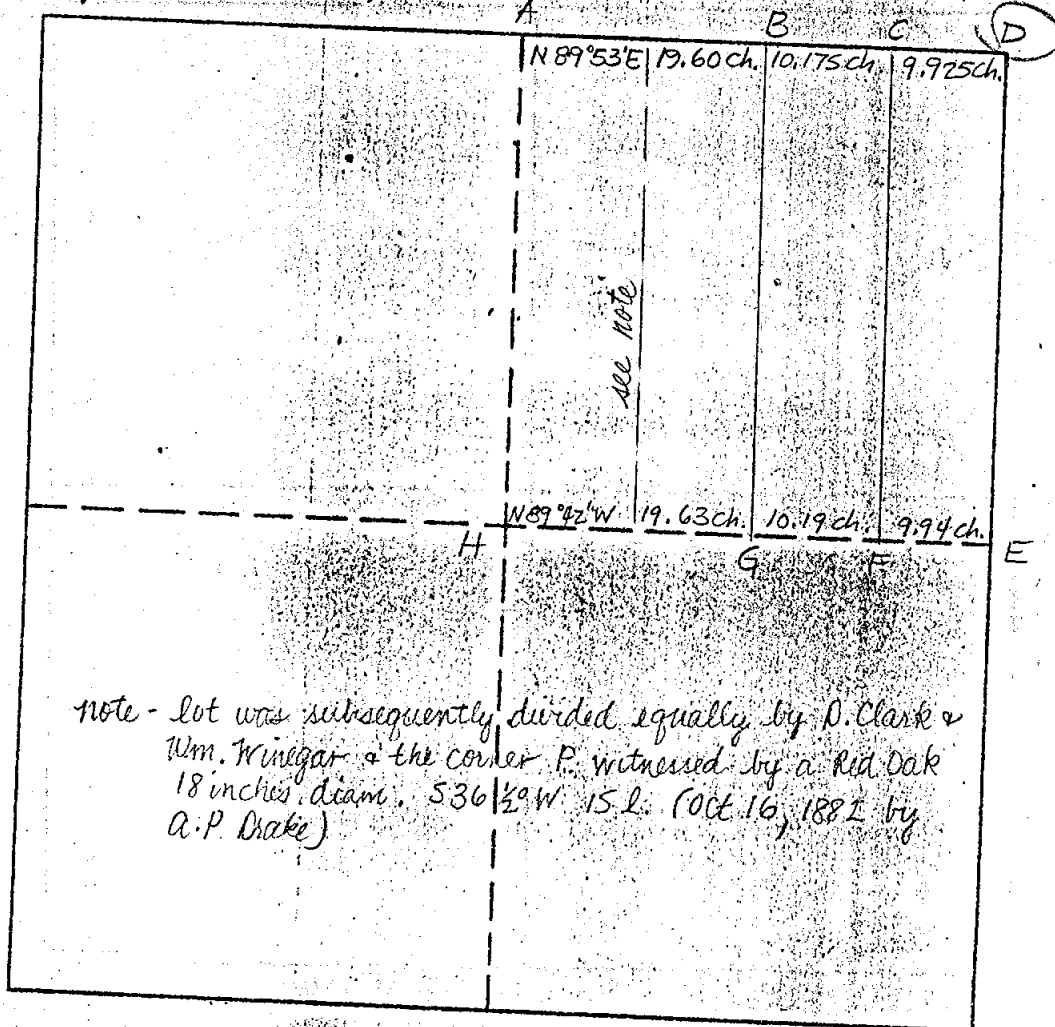

Sec. 13.

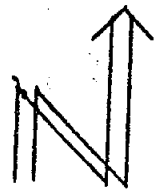

NOT TO SCALE

ONONDAGA
TOWNSHIP

T 2 N, R 1 EW

M-5
CORNER CODE

ATTACHMENT NO. 1

P. 1 of 1

SOURCE: Record of the County Surveyor Vol. 5 p. 13

TRANSCRIBED from ORIGINAL on file at Register of Deeds
~~DUPLICATE~~

SURVEYOR'S NAME E. A. Calkins Deputy

SURVEYOR NO. _____

DATE OF SURVEY Aug 28, 1900

SECTION NO. 13

MAGNETIC VARIATION 10'

C Post - O.W.G.

2. stone 14 links South of Leslie stone

3. set stone with small stone fur bears

Nick 10 N 16° W 138 1/2 links

Apple 14 S 39° E 72 links

4. stone fur bears

W. Oak N 20° E 113 links

Swp. Oak 12 N 27° W 89 lks

Blk Cherry 6 S 25 1/4° W 63 1/2 lks.

6. Old post fur bears

Butternut 6 N 68 1/4° E 39 links

Butternut 8 N 26 1/4° E 64 3/4 links

7. set stone fur bears

Sugar 10 N 66° W 55 links

W. Oak 4 S 54° W 60 links

13. set stone with
stone around fur bears

Walnut 6 S 73 1/4° W

19 links



C. set stone fur bears

Whitewood 12 S 10 1/4°

38 links

B. Ash 14 N 2 1/2°

68 links

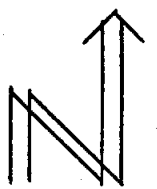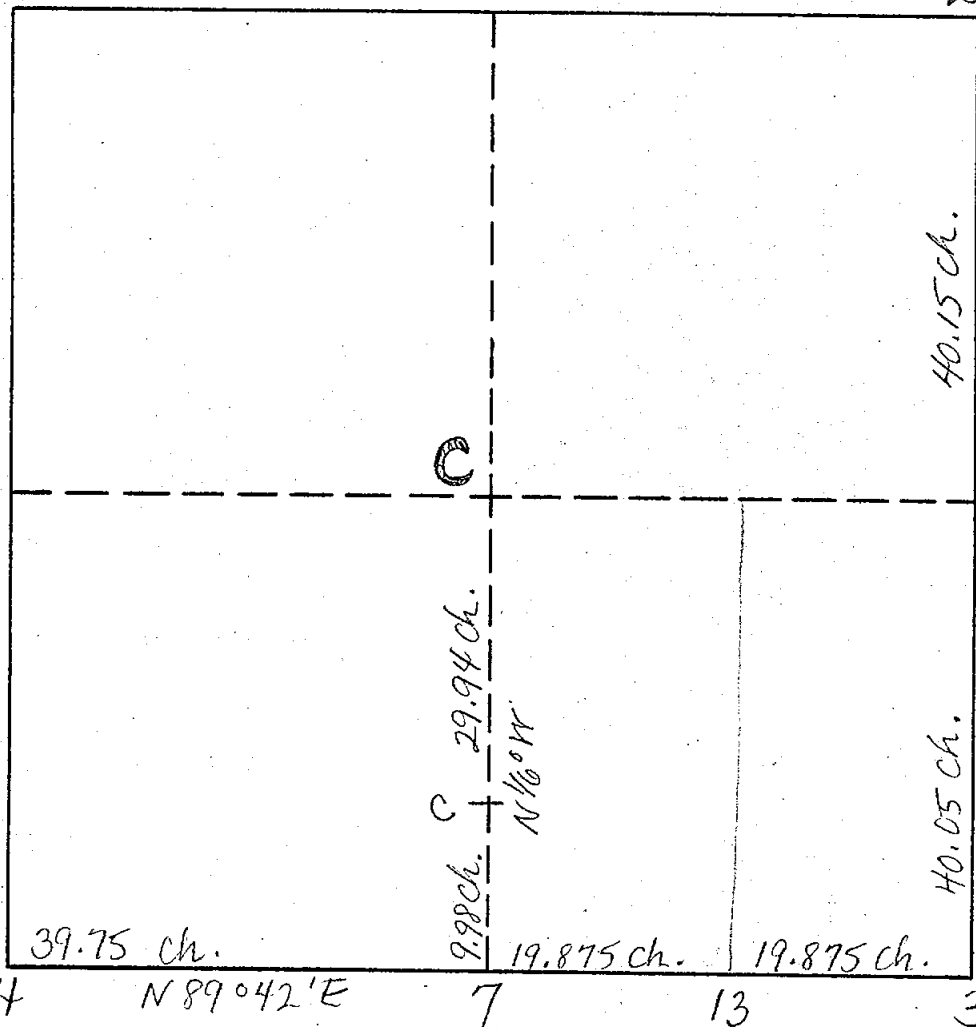

NOT TO
SCALE

Onondaga
TOWNSHIP

T 1 N, R 2 W

• M-5
CORNER CODE

2
ATTACHMENT NO.

P. 1 of 1

TRANSCRIBED from ORIGINAL on file at INGHAM COUNTY DRAIN COMMISSION
~~DUPLICATE~~

Survey of Perry Creek Tile Drain

Survey of the Perry Creek Tile 28 1/2 deg. E 570 feet to station 6 plus include the construction of one (1) Drain, located on sections 12 and 13, 00 feet, the upper terminus of said concrete bulkhead

Town 1 North, Range 2 West, Merri drain at a point 15 feet N. of

The total fall of said drain is 1.98 feet.

Michigan, the centerline thereof being on said lands is 591 feet. Total length of said drain The maximum depth is 5.18 feet.

The total length of said Perry average depth is 3.63 feet. The minimum depth is 4.39 feet.

Said drain shall be constructed with the following depths in feet and

of the W 79 acres of NE $\frac{1}{4}$ of section 13, town and range specified above, and the 2 $\frac{1}{2}$ hundredths of feet, measured from a level with the tops of the adjacent

over and across the following description set every 100 feet distant throughout the large area, thence station stakes and grade hubs are staked and the tops of the aforementioned grade hubs.

the E $\frac{1}{2}$ of W $\frac{1}{2}$ of NE the course of said drain, and 3 feet $\frac{1}{4}$ of section 13, George A. Jones to the right of the centerline containing (600 feet or 2020' SECTION ONE.

and wife, Clara A., owners, as follows: Commencing at station 0 plus 100 feet, or 36.36 rods (tile.)

	Feet	Feet
0 feet of said drain, thence N 15° a closed drain of 24-inch drain tile	0	3
eg. E 9 feet to station 0 plus 0 feet throughout	5.01	3.62

[illegible]

Station	Distance from station 0	Remarks	Elevation
1	2	Commencing at station 0,	4.36
2	4.25	total length of said drain on said grade elevation, 92.02, thence a grade	4.31

Thence over and across the following lands is 9 feet.

ing description: the SE $\frac{1}{4}$ of section
2, town and range of record Montell shall include
The right of way for construction
w. end S. Header Wall, Elev.
100.08.

Survey completed October 1, 1919.

one of said lands at a point 445 feet
from station 0 plus 9 feet in the S. scribed.
All work of construction shall be in
accordance with the plans and specifications
of the Engineer.

By A. F. Zickgraf
By order of George Graham Cannon

ence N 15 deg. E 21 feet, thence N ty drain commissioner, said work to of Ingham State of Wis.

---O---, State of Michigan.

SOURCE: MISC. FIELD BOOK #15 p.150

TRANSCRIBED from ORIGINAL on file at REMON. OFFICE
DUPLICATE

Section 13, Onondaga
Survey of lines upon Sec 13,
T. 1 N., R. 2 W. upon application
of Ervin Johnson and Will Fox.
Aug. 28th and 29th - 1900.
Mag. & true variation 10' West
Chas. W.
E. Johnson & Severn
W. Fox

Corn at SW corner of said Sec 13
Stone: 8' W. Oak N 20° E - 113 l.
Scop N. Oak 13 - N 27° W - 89 l.
Cherry 6 - S 25° 42' W - 63 l.

Set off 5 l. South Run N 89° 42' E on
Sandoz's, at 40.00 3/4 mile post, at
79.50 a point 11 1/2 l. South of the corner.

Aug 29th - 1900.

Corn at NE corner of Sec 13. Stone
Set 21 1/4 l. East, near center on random
at 40.15 a point 7 l. East of 1/4 post, at
80.20. Set Stone by measurements upon
Sec 18. Rule 1, for the corner f.w.:
Hick 10 - N 16° W 138 1/2 l.
Apple 14 - S 39° E - 72 l.

Corrected the line to meet from
this corner. at 19.575 l. Stone for
sub-div. corner f.w.:

Walrus 6 - S 7° 4' W - 19 l. at
39.75 re-established 1/4 post at ar
dist. on true line, Stone, f.w.
Sugar 10 - N 66° W - 55 l.
Hick 10 - N 16° W - 138 1/2 l.

Sec 13, Onondaga
Run from this 1/4 post N 2° W, at
9.98 l. Set stone f.w.
Whitewood 12 - S 10° 48' E - 58 l.
R. Ash 14 - N 2° E - 68 l. at
39.92 center 1/4 post of Sec 13. All Stone
good.

By
E. J. Patterson
Dy Co. Surveyor

K-7

L-7

M-7

M-5

M-6

M-7

M-7

Aug 29
 Commenced at W E cor of Sec 13
a stone 14 lks S of Leslie stone
Set off 13 last to
Ran S Southon Random
at 40.15 point 7 lks E of 40.15
at 80.15 intersected line
from Sec 18
at intersection 40.15
line from 3rd post Sec 18
Leslie, being at 40.15 from
6th post of Sec 13, Brown Top
from this point
bearing S - 16° E 149' 4"
angle 16 S 13° E 1336
at intersection
from this point
bearing S - 16° E 149' 4"
angle 16 S 13° E 1336
at intersection
from this point
bearing S - 16° E 149' 4"
angle 16 S 13° E 1336

M-5 TIN-R2W
 M-5 TIN-RIW

M-6 TIN-R2W

M-7 TIN-RIW

M-7 TIN-RIW


M-6 TIN-R2W

M-7 TIN-R2W

TRANSCRIBED from ~~RECORD~~ on file at REMON. OFFICE

Town / N. Range 2 W.

Section No. 1

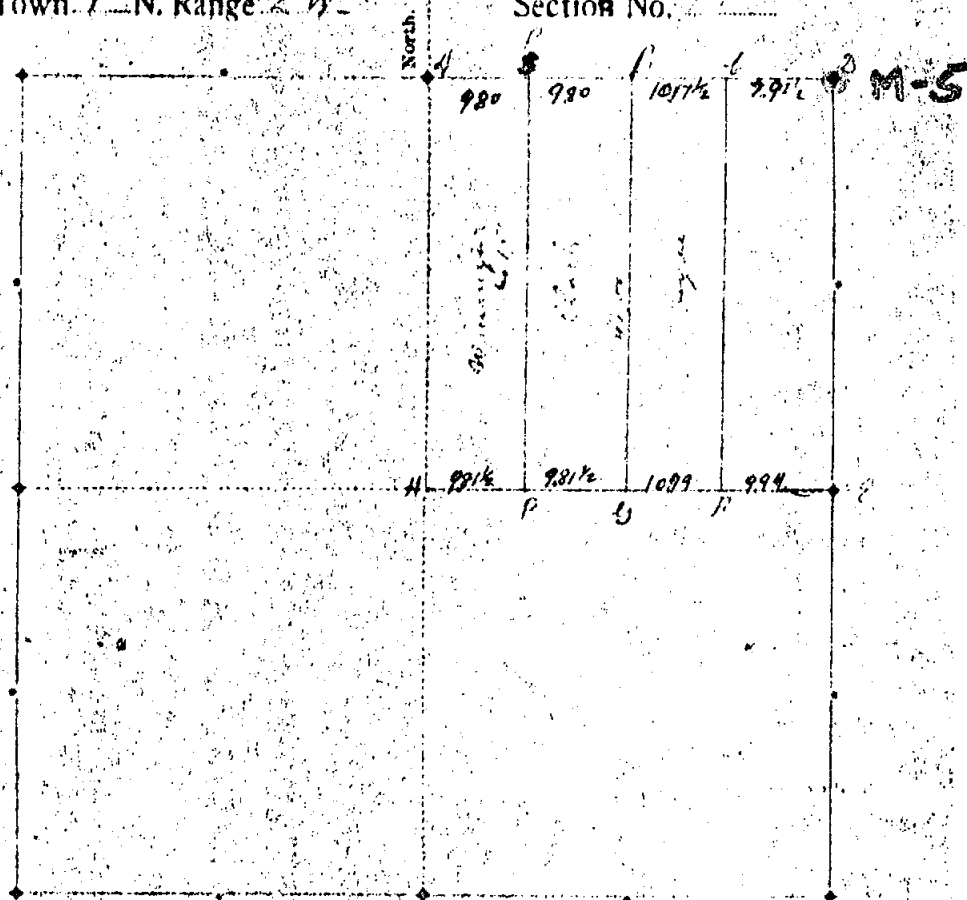

Section	Timber	Diam	Bearing	Links	Section	Timber	Diam	Bearing	Links
A	Stone cherry	7	S 44 W	47					
B	" "	4	S 44 W	21 1/2					
C	Butternut	10	S 63 E	117 1/2					
D	Stems in center of highway								
E	Maple	8	N 107 1/2 E	91					
F	Maple	20	S 107 1/2 E	105					
G	Beech	17	N 34 1/2 W	116					
H	Maple	20	S 77 1/2 E	89					
I	Maple	10	S 88 E	89					
J	" "	10	N 117 1/2 W	22 1/2					
K	Established by Johnson, 1899			1699					

The corner of Section 10, T. 2 N., R. 2 W., is located by the corner of the highway.

Run by the true meridian. Magnetic variation ... degrees ... minutes W.

Surveyed the ... day of ... 1899 by ...

The line of P. 17 runs from the corner of Section 10, T. 2 N., R. 2 W., to the corner of Section 10, T. 2 N., R. 2 W., and is a line of 150 feet.

ONONDAGA township


T 1 N, R 2 W

M-5 corner code attachment no.

p. 1 of 1

P. 18

Town 1 N, Range 22

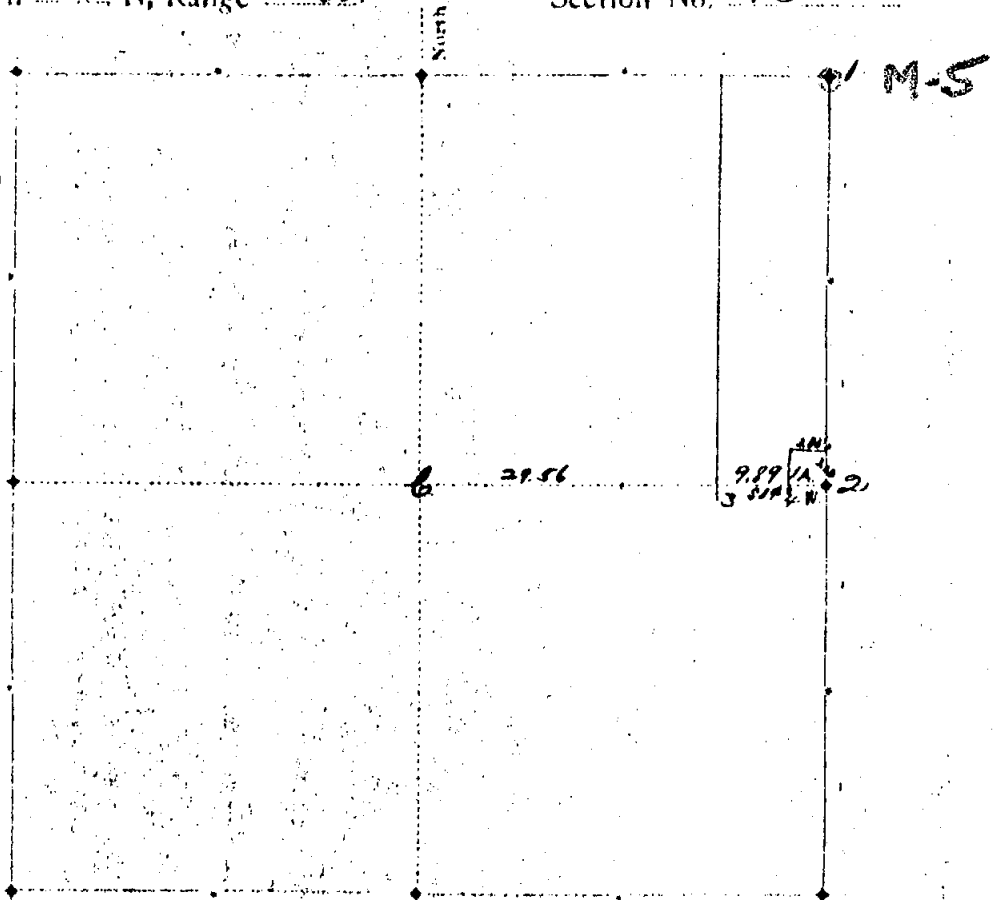Section No. 13

Section	Timber	Diam	Bearing	Links	Section	Timber	Diam	Bearing	Links
M-5	1	Stone 14 ft. South of bridge.							
	2	"	6 1/2 126 1/2	37					
	3	Out Road no trees.							
	6	O.P.T.O.B.							

Surveyed the 8th day of February 1898 by

W. A. Rowe
County Surveyor of Ingham County, Michigan.

Sec. 13

ONONDAGA
township

T 1 N, R 2 W

M-5 11
corner code attachment no.

p. 1 of 1


SOURCE: FOLDER #1

P. 19

TRANSCRIBED from DUPLICATE on file at REMON. OFFICE

Town. / ... N., Range. 2 N.

Section No. 13

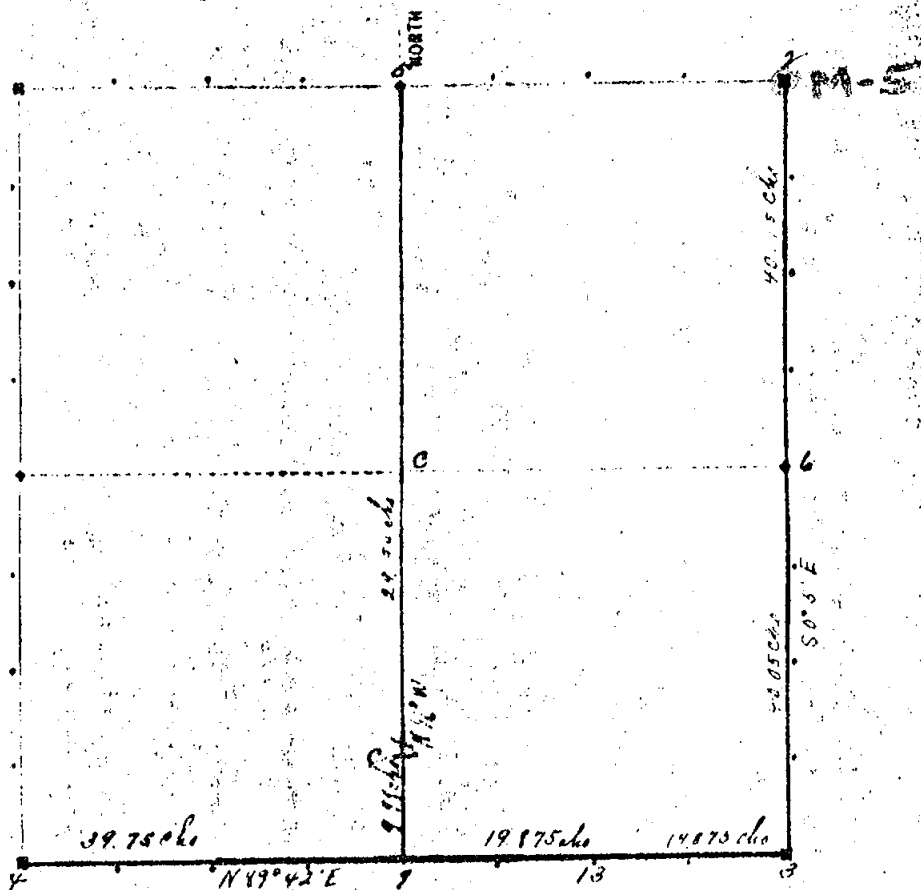

Sec.	Timber.	Diam.	Bearing.	Links.	Sec.	Timber.	Diam.	Bearing.	Links.
C	Post O.W.H.				13	Set stone with stone around	6	S 77° 4' W	14
M-5 2	Stone 14 lbs each of Red Oak				C.	Set stone	12	S 10° 4' E	38
3	Stone set with small stone					White oak	14	N 2° 2' E	68
	Hick	10	N 16° W	138					
	Apple	14	S 39° E	22					
4	Stone								
	W Oak	12	N 20° E	113					
	Sup. W Oak	6	N 27° W	89					
	Red Cherry	6	S 20° 4' N	63					
6	Old post								
	Quail	6	N 68° 4' E	38					
	"	8	N 26° 8' E	64					
7	Set stone								
	Sugar	10	N 66° W	55					
	W Oak	4	S 64° N	60					

Run by the true meridian. Magnetic variation. degrees 10 minutesSurveyed the 28 & 29 day of August 1900 by

E. A. Callins
 Deputy County Surveyor of Ingham County, Mich.

Sec. 13

ONONDAGA
 township

T 1 N, R 2 W

M-5
 corner code attachment no.

p. 1 of 1


SOURCE: FOLDER #1

T. 60

TRANSCRIBED from RECORD on file at REMON. OFFICE

Town / N, Range 2.W.

Section No. 13

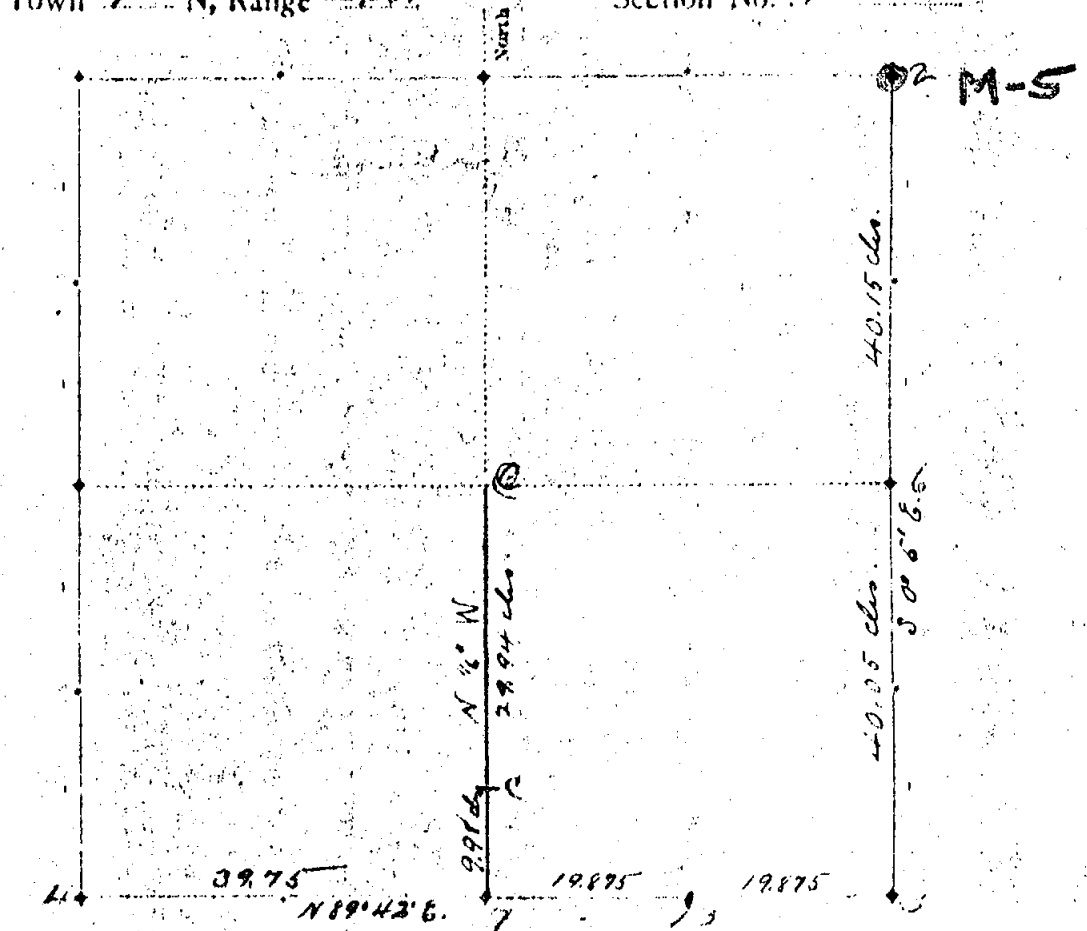

Section	Timber	Dist	Bearing	Links	Section	Timber	Dist	Bearing	Links
M-5 [2]	Post Oak				13	Blair surrounded with bluffs			
3	Spice 14 l. South of bluffs stone					Walnut	6	S 74° W	19
"	Spice with on ball stone	10	N 16° W	138		Stone			
"	Apple	14	S 39° E	72		Whiteland	12	S 104° E	38
4	Stone					B. Oak	14	N 28° E	68
"	W. Oak		N 20° E	113					
"	Sup Oak	12	N 27° W	84					
"	Bk Cherry	6	S 25° W	63					
"	Walnut	6	N 68° E	39					
6	Do	8	N 26° E	64					
7	Stone	10	N 66° W	85					
"	W. Oak	14	S 54° W	60					

Run by the true meridian. Magnetic variation 0 degrees 10 minutes 6

Surveyed the 28th day of August 1900 by

E. A. B. B. B.
County Surveyor of Ingham County, Michigan.

Sec. 13

ONONDAGA
township

T 1 N, R 2 W

M-5
corner code attachment no.


13
p. 1 of 1

UNCDAG 4
TIN-R2W

M-5

41


1	A	B	C	D	E	F	G	H	I	J	K	L	M
2	6	5	4	3	2								
3													
4	7	8	9	10	11	12							
5													
6	18	17	16	15	14	13							
7													
8	19	20	21	22	23	24							
9													
10	30	29	28	27	26	25							
11													
12	31	32	33	34	35	36							
13													

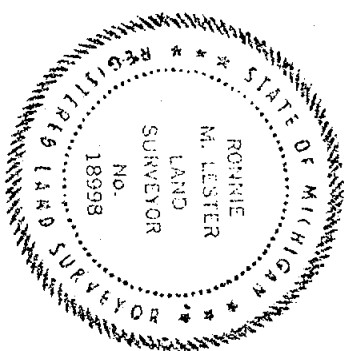

TECH. SUP'R. L.B. TOWNSHIP ONONDAGA
COMPANY Polaris CORNER CODE M-5
FIELD SQUAD L. Faust #6 RECORDED CORNER
DATE 6-6-78 ROAD NAME Covert Rd.

Sketch, witness, and describe monuments found, and location relative to traverse point and centerline of road.

- N Final Witnesses:
- 1) set N.T. on S.E. side Power Pole N. 45° E. 69.72'
 - 2) set N.T. on S. side 16" Dia Pine Tree N. 60° E. 80.02'
 - 3) set N.T. on N.E. side Power Pole S. 80° E. 51.51'
 - 4) set N.T. on E. side CORNER Post S. 65° W. 41.36'
 - 5) Monument w/cap (R.L.S. # 18998) Due N. 9.23'
 - 6) set N.T. on E. side 36" Dia OAK S. 10° W. COULDN'T FIND
- 69.72
R.L.S. # 18998
80.02
51.51
41.36
9.23
187.08

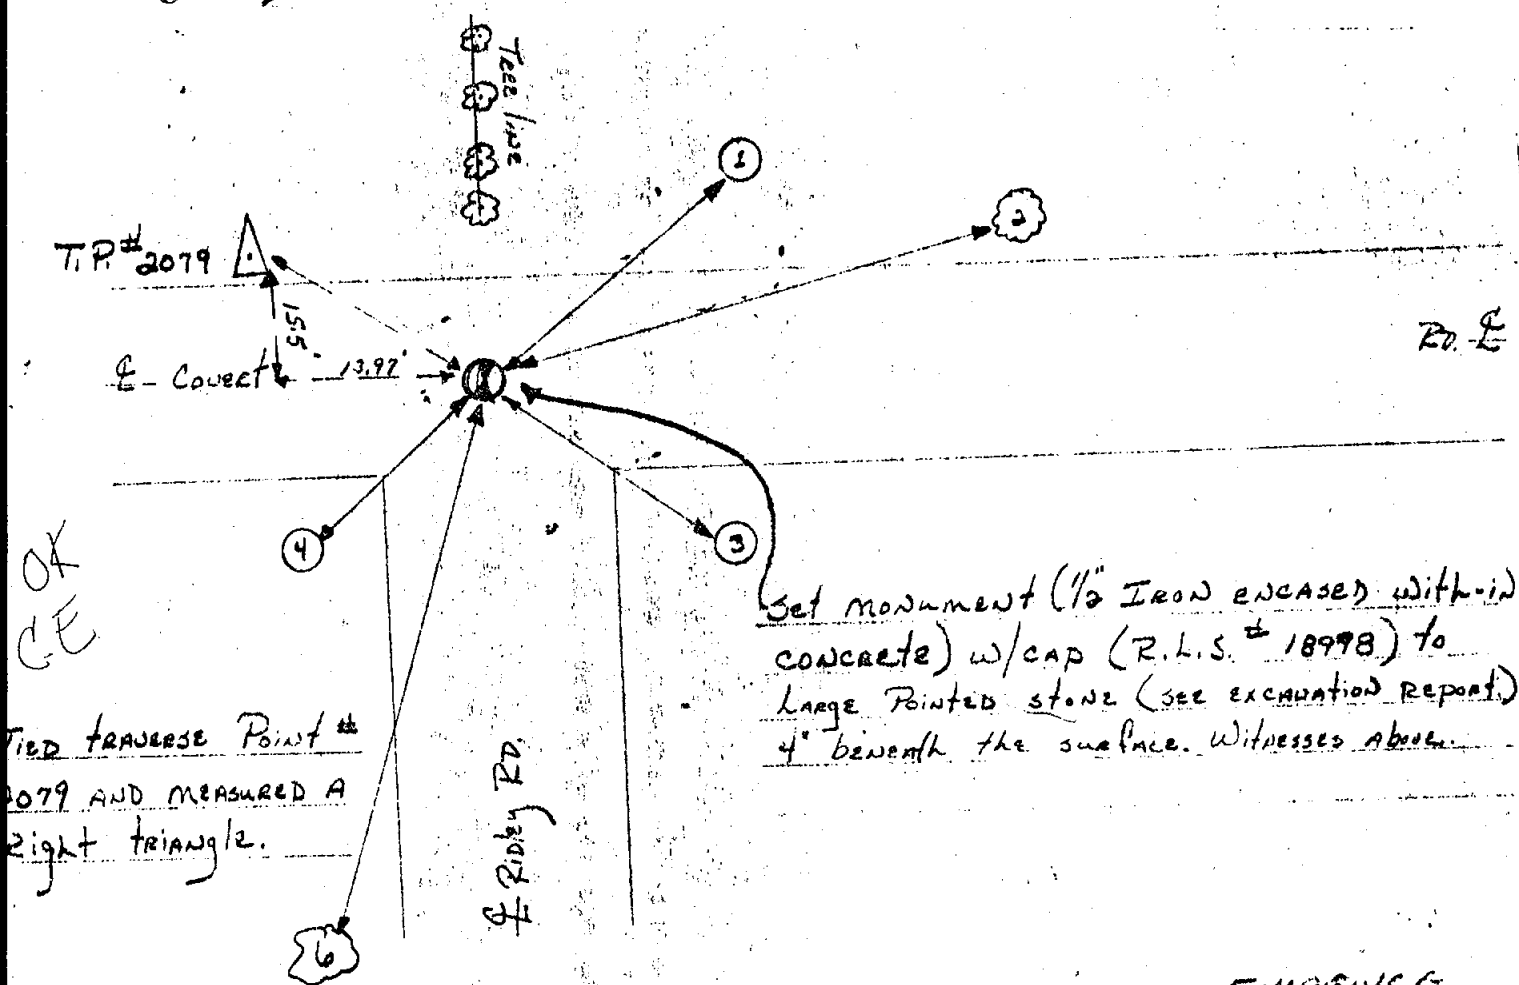

OK
CE
Tied traverse Point #
2079 AND MEASURED A
Right triangle.

EXCELLENT CORNER ALSO FOUND SIMILAR EVIDENCE
AT A-S LESLIE TWP.

L. BRYAN

3-26-78; Fld. Form No. 6

TECH. SUP'R. L. B. TOWNSHIP ONONDAGA
 COMPANY Polaris CORNER CODE M-5
 FIELD SQUAD L. Faust #6 PAGE 1 OF 1 DATE 6-6-78



EXCAVATED AREA: 4.7' by 4.8' SQ. FT.; AVG. DEPTH 3.4' SURFACE Asphalt

Sketch and describe roads, monuments found or set, and witnesses established:

N FOUND

Large pointed stone 1.9' below surface. Pt. "A" stone was surrounded by Red Brick. (This stone is the same as the one found at 10, 11, 12, 13) and removed for further investigation.

Note: N. Edge of excavation is 10.73'
 S. of N. Edge Covert Rd.

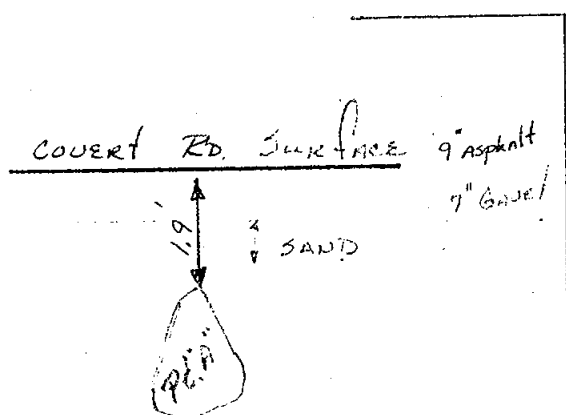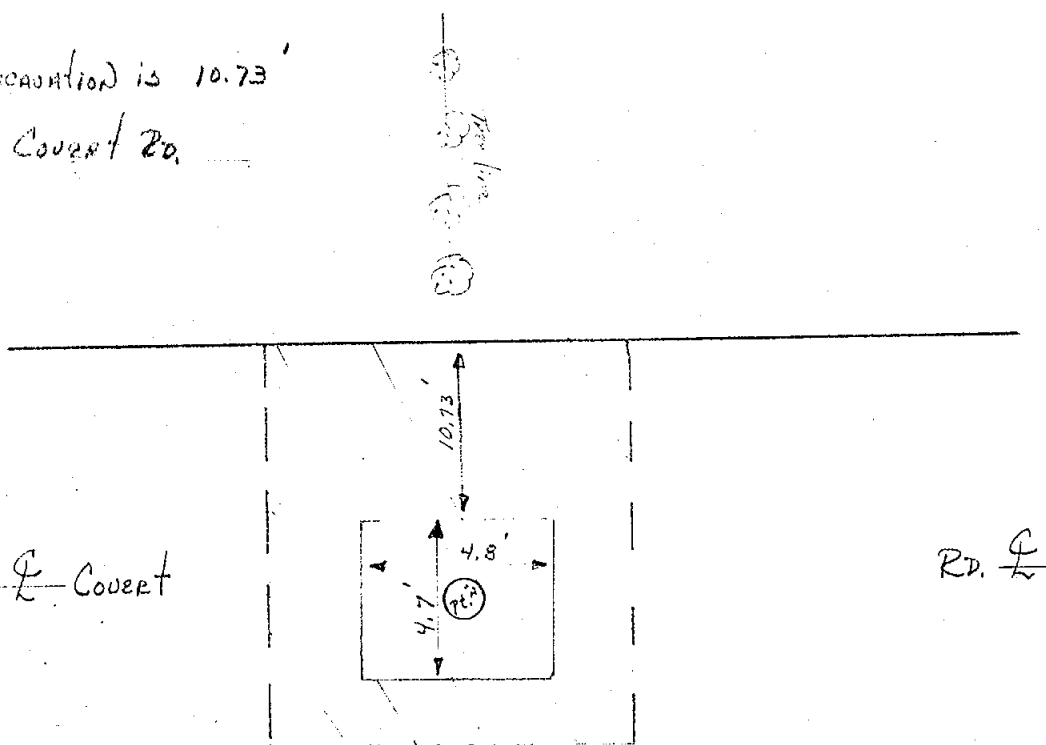

INGHAM COUNTY SURVEY and REMONUMENTATION PROJECT

Township ONONDAGA, T 1 N, R 2 W

Corner Code *M-5*

Research Record:	attachment number(s)	no. of sheets	researched by	reviewed by
Corner Recordation Certificate Liber 4 Page 275	0	1	DKH	
Recorded Land Survey Liber Page	"	-	"	
Recorded Subdivision Plat Liber Page	"	-	"	
MDSHT Right-of-Way Maps Sheet No.	"	-	"	
Ingham County Road Comm. Maps Sheet No.	"	-	"	
Record of the Ingham County Surveyor Vol. 3 Page 129 Year 1877 5 13 1900	1 2	1 1	DKH	
General Land Office Maps #111 Sheet No.	3			
Form 280, Gov't. Monument Witness Record				
Ingham County Drain Comm. File No.	4	1		
East Lansing City Engineer	N/A	-		
Lansing Public Service Office Cade's 1921 Survey p.				
Lansing Public Service Office J.B. Davis' Field Notes p.	✓		✓	
G.L.O. Field Notes	5	1		
Misc. I.C. S. Notes	6/7/8	14/15		
Field Recon. Form	4	1		
NOTHING MORE	N.B.			
RESEARCH COMPLETED date	Total	Total	LALONDE	
Consumers Power Company Sheet No. Index No.				
Chesapeake & Ohio Railroad Co. Val. Sec. Drawer Sheet				
FOLDER 11 1 12 13 14	10/11/12/13	11/12	LALONDE	
RESEARCH COMPLETED date	Total	Total	Y	
REMARKS				

SOURCE: RECORD OF THE COUNTY SURVEYOR VOL. 3 p. 129

TRANSCRIBED from ORIGINAL on file at REGISTER OF DEEDS
DUPLICATE

SURVEYOR'S NAME A. P. DRAKE

SURVEYOR NO. _____

DATE OF SURVEY APRIL 23, 1877

SECTION NO. 13

MAGNETIC VARIATION 1° 52' E

A - STONE
CHERRY 4 S 4° W 47 LKS
" 4 S 49 3/4° W 72 1/4 LKS.

B - POST
BUTTERNUT 10 S 63° E 112 1/2 LKS

C - STONE IN CENTER OF HIGHWAY

D - STONE
APPLE TREE 8 N 47 3/4° E 91 LKS.


E - POST
MAPLE 20 S 20 3/4° E 103 LKS.

F - POST
BEECH 12 N 34 3/4° W 16 LKS.

G - DOUB " 20 S 79° E 39 LKS
POST

* H - POST -
MAPLE 10 S 23° E 28 LKS.
" 10 N 17 1/4° W 21 1/2 LKS.

* This is the original corner made by A. Jackson. Jan 21st. 1839
Note: The corner E was lost, but the corresponding corner in T1N-R1W, established by Mr. Jackson was readily found, and this corner was located at its proper distance south of it, being nine links therefrom.

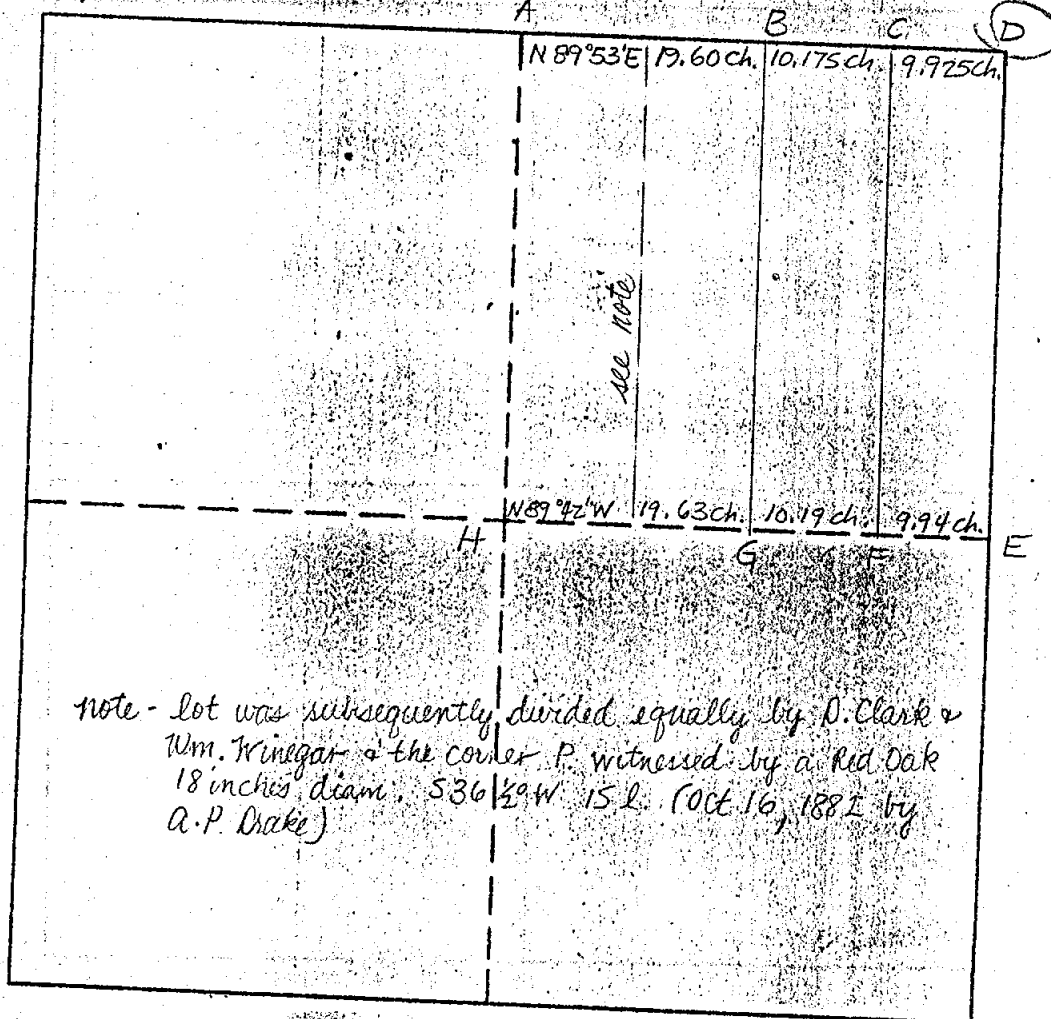

Sec. 13.



NOT TO
SCALE

ONONDAGA
TOWNSHIP

T 2 N, R 1 EW

M-5
CORNER CODE

ATTACHMENT NO.

P. 1 of 1

SOURCE: Record of the County Surveyor Vol. 5 p. 13

TRANSCRIBED from ORIGINAL on file at Register of Deeds

~~DUPLICATE~~

SURVEYOR'S NAME E. A. Calkins Deputy

SURVEYOR NO. _____

DATE OF SURVEY Aug 28, 1900

SECTION NO. 13

MAGNETIC VARIATION 10'

C Post - O.W.G.

2. stone 14 links South of Leslie stone

3. set stone with small stone fur bears

Nick 10 N 16° W 138 1/2 links

Apple 14 S 39° E 72 links

4. stone fur bears

W. Oak N 20° E 113 links

Swamp Oak 12 N 27° W 89 lks

Blk Cherry 6 S 25 1/4° W 63 1/2 lks.

6. Old post fur bears

Butternut 6 N 68 1/4° E 39 links

Butternut 8 N 26 1/4° E 64 3/4 links

7. set stone fur bears

Sugar 10 N 66° W 55 links

W. Oak 4 S 54° W 60 links


13. set stone with
stone around fur bears

Walnut 6 S 73 1/4° W
19 links

C. set stone fur bears

Whitewood 12 S 10 1/4°
38 links

B. Ash 14 N 2 1/2°
68 links

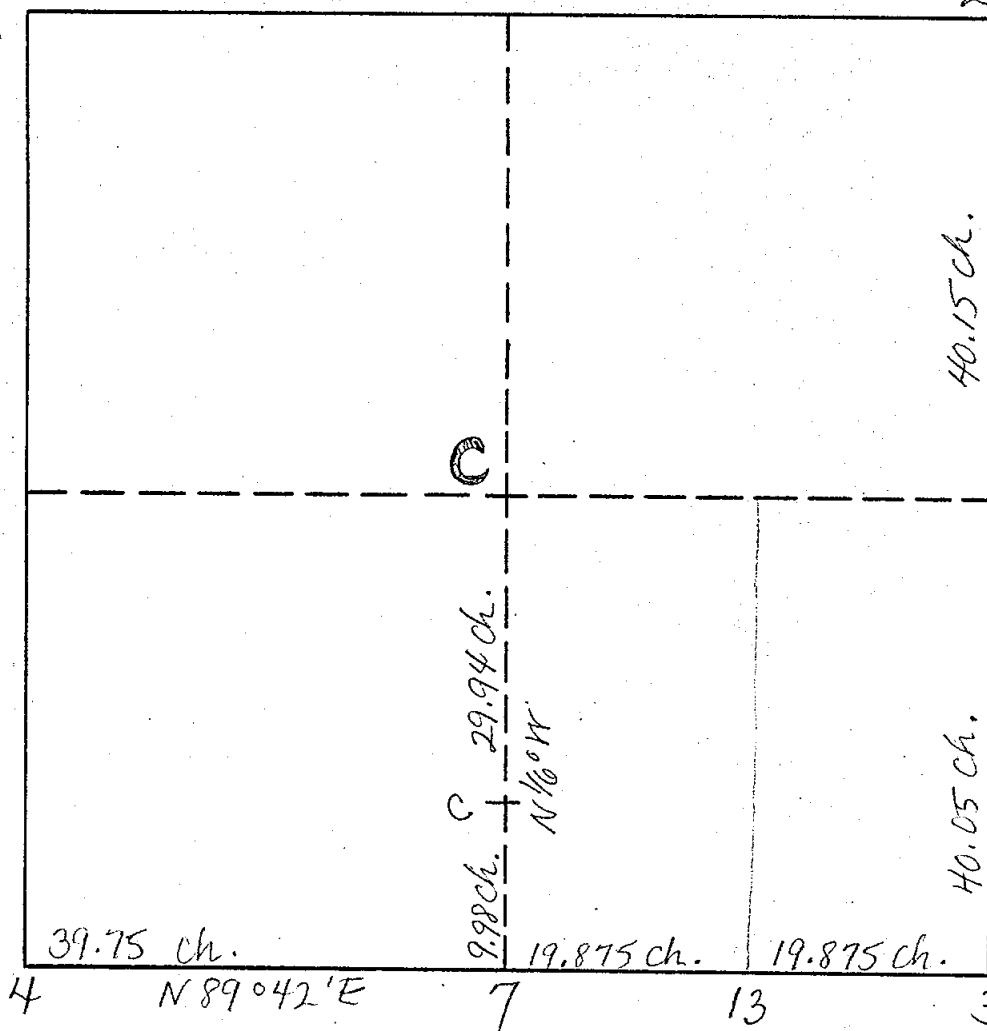

Mondaga
TOWNSHIP

T 1 N, R 2 W

M-5
CORNER CODE

2
ATTACHMENT NO.

P. 1 of 1

SOURCE: DRAIN FILE # 293

TRANSCRIBED from ORIGINAL
DUPLICATE on file at INGHAM COUNTY DRAIN COMMISSION

Onondaga Twp.
M-5
MC. 12 & 13

293

Survey of Perry Creek Tile Drain

Survey of the Perry Creek Tile Drain, located on sections 12 and 13, 00 feet, the upper terminus of said drain, at a point 515 feet N and 1352 feet W of the SE corner of said section 12. Total length of said drain on said lands is 591 feet.

The maximum depth is 5.18 feet. The minimum depth is 3.63 feet. The average depth is 4.39 feet. Said drain shall be constructed with the following depths in feet and hundredths of feet, measured from a level with the tops of the aforementioned grade hubs.

SECTION ONE.
(600 feet, or 36.36 rods tile.)

Sta.	Depth Feet	Sta.	Depth Feet
0	5.01	3	3.62
Com.	24-inch.	4	3.99
1	5.18	5	4.36
2	4.25	6	4.31

BENCH MARKS
W. end S. Header Wall, Elev. 100.08.
Survey completed October 1, 1919.

WOLVERINE ENGINEERING CO.,
Engineers.
By A. F. Zickgraf
County Drain Commissioner of the County
of Ingham, State of Michigan

By order of George Graham, County
Drain Commissioner of the County
of Ingham, State of Michigan

SOURCE: MISC. FIELD BOOK #15 p. 150

TRANSCRIBED from ORIGINAL on file at REMON. OFFICE
DUPLICATE

Section 13, Onondaga
Survey of lines upon Sec 13,
T. 1 N., R. 2 W., upon application
of E. Johnson and Will Fox.

Aug 25th and 29th - 1900.
Mag of the Variation 10' West

Chained
E. Johnson & Severn
W. Fox

Corn at SW corner of said Sec 13

Stone 1 of W. Oak N 20° E - 113 l.
Stone 11 Oak 12 - N 27° W - 89 l.
Cherry 6 - S 25° 44' W - 63 l.

St of 5 l South Run N 89° 40' E on
Said 11th at 40.00 set line post, at
79.50 a point 11 l South of the corner.

Aug 29th - 1900.

Corn at NE corner of Sec 13. Stone
Set 11 14 l, 6 a, run South on random
at 40.15 a point 7 l East of 14 post, at
80.20. Set Stone by means of the line
Sec 18. Run for the corner of W. 1:
Field 10 - N 16° W 138 l.
Apple 14 - S 39° E - 72 l.

Corrected Sec line to run from
this corner at 19.875 l. to stone for
subdiv. corner 10 l.
Valued 6 - S 73° 41' W - 19 l. at
39.75 re-established 14 post at or
dist on true line. Stone, W.
Sugar 10 - N 66° 11' W - 55 l.
To M. H. L. ...

Sec 13 Onondaga
Run from this 14 post N 2° 11' W
9.98 set stone. W.
Whitewood 12 - S 10° 48' E - 58 l.
R. Ash 14 - N 22° E - 68 l. at

39.92 Center 14 post of Sec 13. Old Survey
good.

By
E. T. Calkins
Dy Co. Surveyor

K-7

L-7

M-7

M-5

M-6

M-7

M-7

SOURCE: MISC. FIELD NOTES BOOK #16 P.17
TRANSCRIBED from ORIGINAL
DUPLICATE on file at REMCON. OFFICE

Aug 29

Commenced at W & cor of Sec. 13

~~a stone 14 lbs of Lualaba stone
set off 13 lbs to E~~

Dec 7th 13 lbs to E. J. Southon Random

at 40.15 point. 7 lbs E of 4.2

at 80.15 intersected line

See Sec. 18

Some with plain brown

at distribution house

1. Johnston, H. H.
 2. Johnston, H. H.

Blue print - 2nd part Sec 18

6'2" tall

6. 2. 1941

~~From this first branch~~

May 3 - R 16 E 149' 1/2

Aug 16 S 13.8 336

36

7/16/60 12:00

Apr 16 - 14 8 39 5 7

5 TIN-R2W

5 TIN-R/W

1-6 TIN-R2W

$$-7 \quad T/N = R/W$$


7-TIN-RTW

G-T-N-RZW

-7 TIN-RZV

P. 17

DUPLICATE

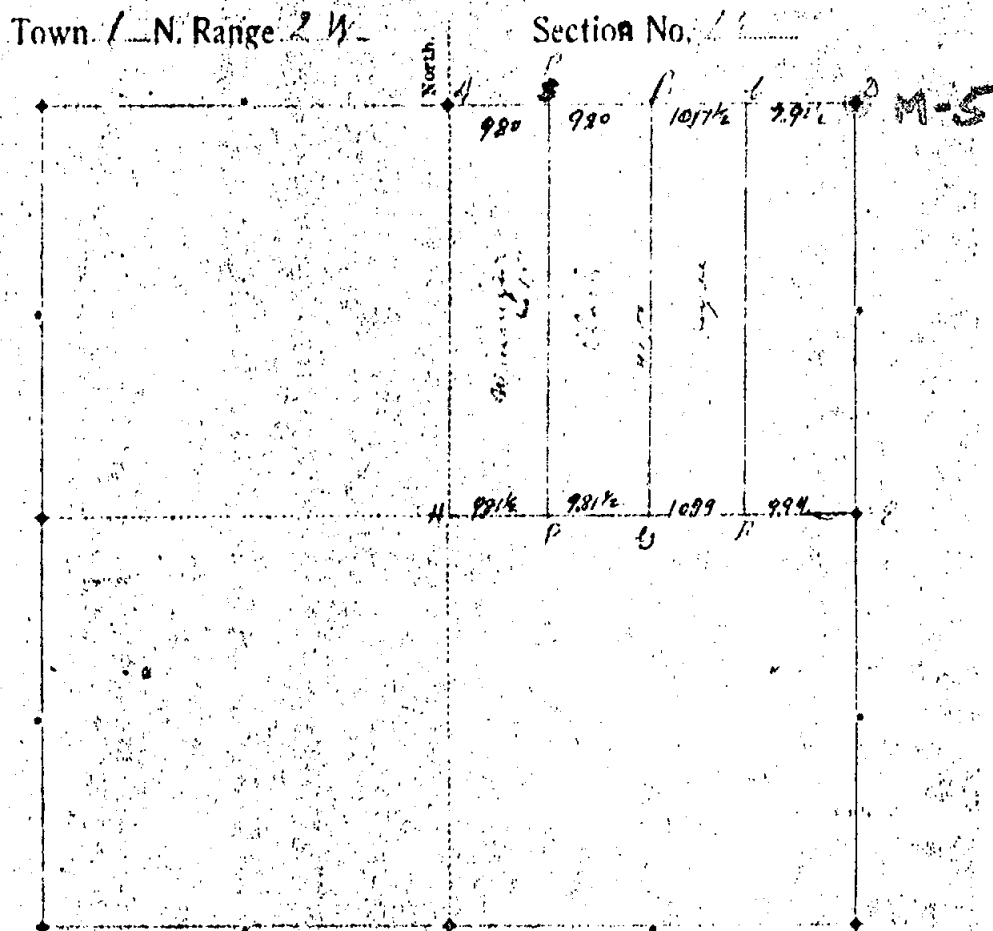

Section	Timber.	Diam	Bearing	Links.	Section	Timber.	Diam	Bearing.	Links.
A	Stone cherry	7 1/2	S 4 W	49					
	" "	7 1/2	S 4 1/2 W	21 1/2					
B	Bitternut	10	S 63 E	117 1/2					
C	Stone in center of highway								
D	Apple	8	N 47 1/2 E	91					
E	Apple	9.0	S 60 1/2 E	108					
F	Buck	12	N 34 1/2 W	16					
G	Double Buck	9.0	S 79 E	89					
H	Maple	11	S 83 E	89					
I	" "	10	N 17 1/2 W	21 1/2					
J	Stone in center of highway								


Run by the true meridian. Magnetic variation 11 degrees 12 minutes W.

Run by the true meridian. Magnetic variation degrees minutes W.
 Surveyed the 23 day of Aug 189 by

W. J. Burke
County Surveyor of Ingham County, Michigan. Sec. 13
The line of R.P. runs near later and a mile or so. R.P. & 15
S. 36° W 15 l. mile the last to next day which found it was the same

P. 18

Town 1 N, Range 24

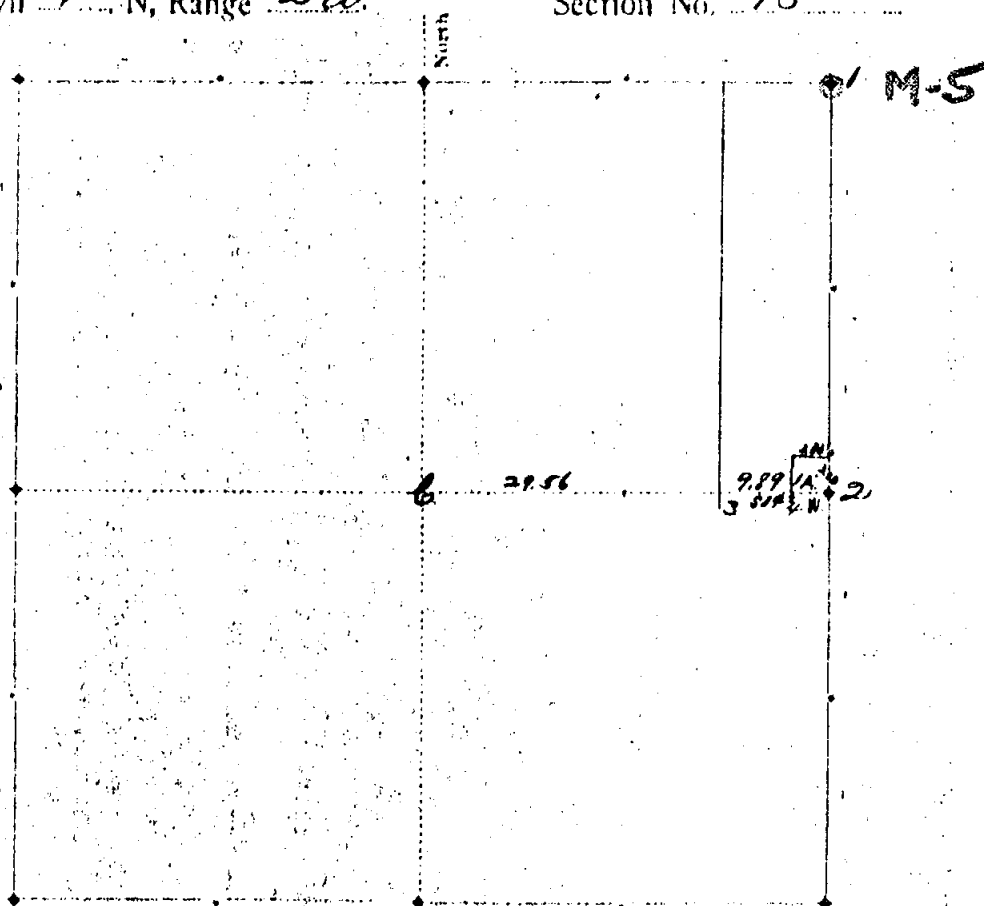Section No. 13

Section	Timber	Diam	Bearing	Links	Section	Timber	Diam	Bearing	Links
M-5	1	Stone 14 ft. South of bridge	6	1660	39				
	2	"	8	1360	64				
	3	Oak Post no trees							
	6	O.P.T.O.R.G.							

Surveyed the 8th day of February 1898 by

W. A. Rowe
County Surveyor of Ingham County, Michigan.

Sec. 13

ONONDAGA
township


T 1 N, R 2 W

M-5 11
corner code attachment no.

p. 1 of 1

SOURCE: FOLDER #1

P. 19

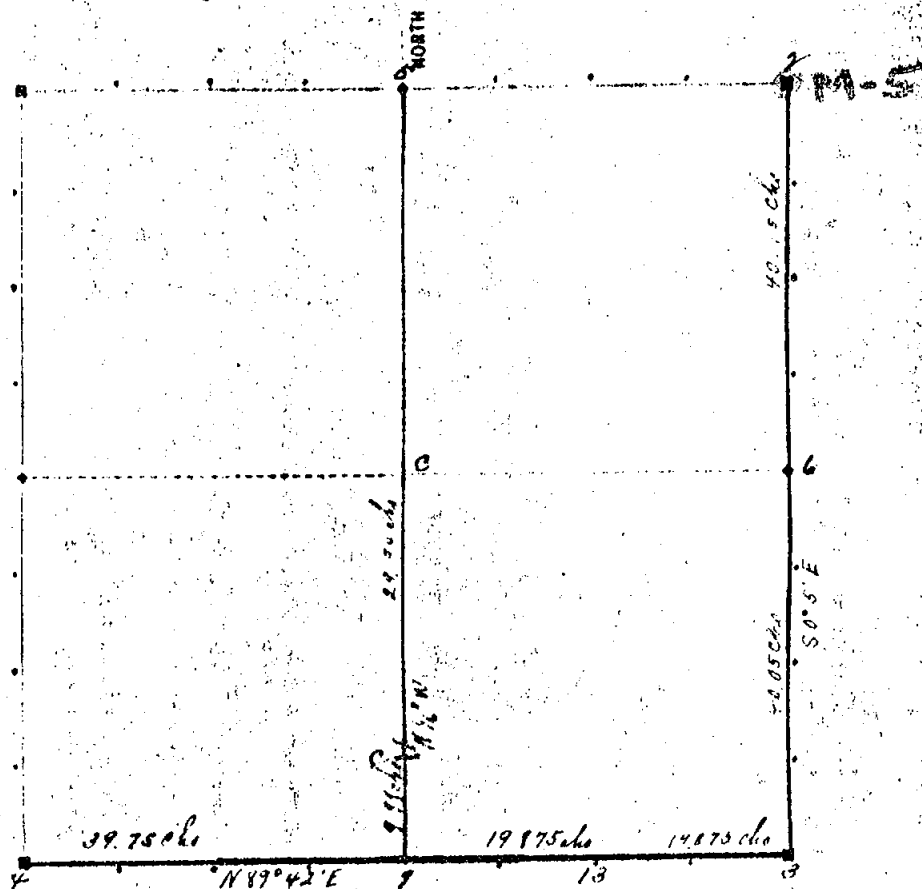TRANSCRIBED from RECORD on file at REMON. OFFICETown. 1 N., Range. 2 W.Section No. 13

Sec.	Timber.	Diam.	Bearing.	Links	Sec.	Timber.	Diam.	Bearing	Links
C	Post O.W.H.				13	Set stone with stone around			
M-5 2	Stone, 16 lbs south of Rockie stone				C	Set stone	6	S 77° 4' W	19
3	Stone set with small stone					Set stone	12	S 10° 4' E	38
	High	10	N 16° W	108		Whitewash	14	N 2° 2' E	68
	Apple	14	S 39° E	22					
4	Stone								
	W Oak	12	N 20° E	113					
	W Oak	12	N 21° W	89					
	Black Cherry	6	S 25° N	63					
6	Old post								
	Bullet	6	N 68° 2' E	37					
	"	8	N 26° 3' E	64					
7	Set stone								
	Sugar	10	N 66° W	55					
	W Oak	4	S 54° N	60					

Run by the true meridian. Magnetic variation degrees 10 minutesSurveyed the 28 & 29 day of August 1900 by

E. A. Collins
 Deputy County Surveyor of Ingham County, Mich.

Sec. 13

ONONDAGA
 township

T 1 N., R 2 W

M-5
 corner code attachment no.

12p. 1 of 1


SOURCE: FOLDER #1

T. 20

TRANSCRIBED from RECORDS on file at REMON. OFFICE

Town 1 N, Range 21W

Section No. 13

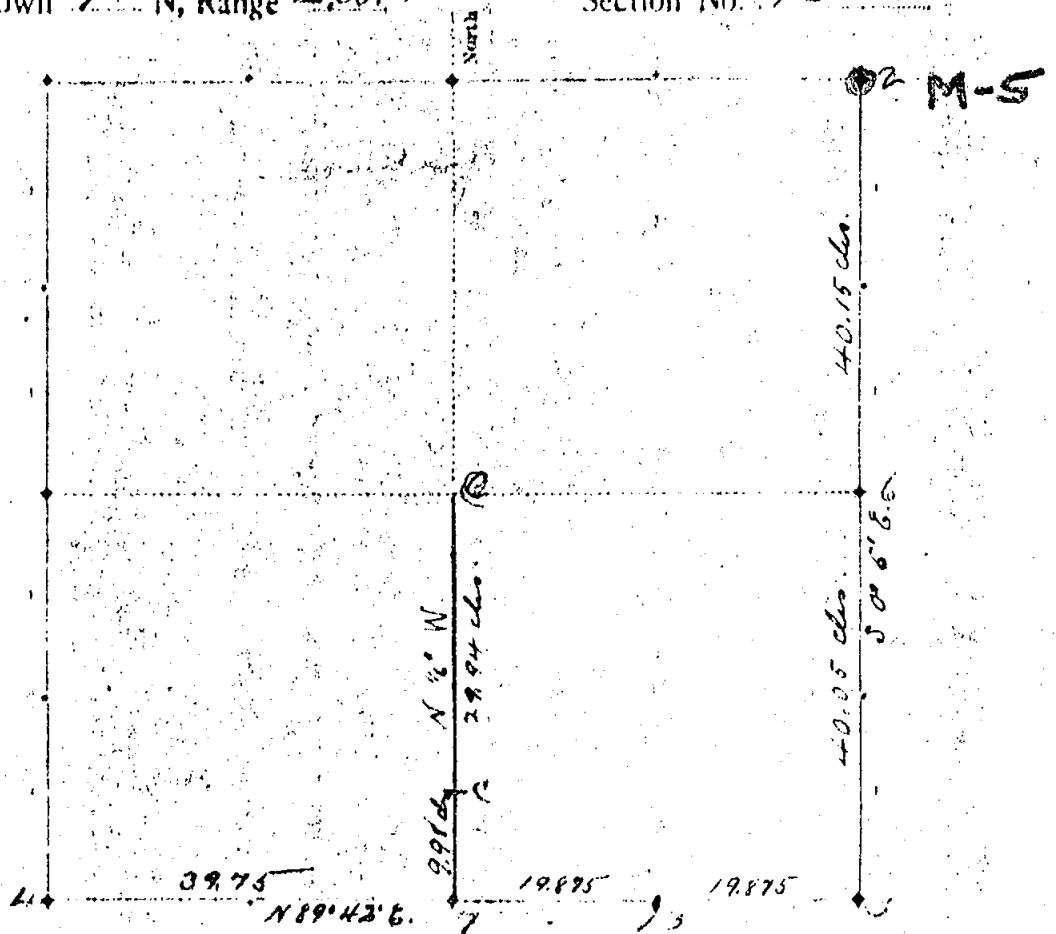

Section	Timber	Diagonals	Bearing	Links	Section	Timber	Diagonals	Bearing	Links
M-5 [2]	Post Oak				13	Stone surrounded with stones			
3	Spice 14 ft	South of Section 13				Walnut	6	S 74° W	19
"	Spice with oak	10	N 16° W	138	C	Stone			
"	Apple	14	S 39° E	72	"	White oak	12	S 104° E	38
4	Stone				"	B. Oak	14	N 25° E	68
"	W. Oak		N 20° E	113					
"	Sup. Oak	12	N 27° W	84					
"	B. Oak	6	S 25° W	63					
6	White oak	6	N 68° E	39					
"	Do	8	N 26° E	64					
7	Stone	10	N 66° W	85					
"	W. Oak	14	S 54° W	60					

Run by the true meridian. Magnetic variation 0 degrees 10 minutes 6

Surveyed the 28 & 29th days of August 1900 by

E. A. Palmer

County Surveyor of Ingham County, Michigan.

Sec. 13

ONONDAGA
township

T 1 N, R 21 W

M-5
corner code attachment no.

p. 1 of 1

1 5000.00000 5000.00000 100.00000 C7
2 2344.89500 5000.00000 100.00000 B7
3 2998.00731 4999.47588 81.21337 C7
4 5000.05140 2349.29511 73.06626 IRON
5 4996.53073 2349.67685 73.12150 MON
6 4998.26966 3678.11656 87.85262 OCC
7 6324.75208 5000.00642 71.39331 OCC
8 2325.76669 7646.16219 93.04909 FNC P
9 4991.53031 6322.12802 115.85688 FNC P
10 4990.57902 6140.52173 117.22512 FNC
11 4993.91729 5868.67782 118.64927 FNC
12 4995.59454 5706.70040 119.58584 FNC
13 4994.36355 5484.01161 118.40363 FNC
14 385.13474 4983.67659 80.94218 TP
15 4684.04067 7396.82564 109.50143 TP
16 2561.43428 7974.76611 104.13020 FNC
17 2738.66037 7977.55792 110.27613 FNC
18 3005.70311 7979.27729 110.38488 FNC
19 3326.82453 7979.10614 101.88994 FNC
20 3587.54971 7979.74701 99.14955 FNC
21 3866.15872 7977.07961 96.97146 FNC
22 4529.81968 7980.40666 100.60274 FNC
23 5442.54358 7983.29243 96.02997 FNC
24 5227.96088 7980.95974 96.94889 FNC
25 4896.51710 7981.03162 97.54904 FNC
26 4673.61263 7980.78120 99.16370 FNC
27 4972.54043 10298.03657 109.05393 C5
28 2791.23557 10303.43132 125.25293 TP
29 2317.33696 10293.60110 111.49544 SEC CNR B5
30 -334.51504 10280.13151 102.29698 M5
31 -334.02846 10289.33706 101.66557 A5
32 -321.05811 7641.66449 87.84424 A6
33 -320.96691 7635.80506 87.15958 M6 ONON
34 -307.48320 5001.39987 86.04161 A7
35 -307.39366 4998.10929 86.27411 M7 ONON
36 385.00680 4983.41252 81.25892 TP 14
37 2344.73119 4999.72139 99.71389 B7/02
38 4986.27022 7649.01828 104.52696 e1/4sec7
39 2331.12359 7645.33933 0.00000 center7
40 2561.43053 7976.72567 0.00000 BESTFIT
41 5442.54559 7982.24193 0.00000 BESTFIT