

Point Listing made Fri Dec 02 15:35:21 2005

Page 1 of 1

Drawing Name: 05-0401_gps_comps

Project Name: 05-0401

Project Path: S:\Projects\2005\05-0401\

Username: GeorgeneW

Number	Northing	Easting	Elevation	Raw Desc	Full Desc
21	9999.9800	9999.9800	100.00	A9	A9
22	9999.9800	9999.9800	100.00	A9	A9
23	10016.5700	11292.4100	99.03	C9	C9
24	12634.3340	10003.6560	89.78	A8	A8
25	4743.8780	11477.5080	100.09	C11	C11
26	4782.0950	14116.2040	106.14	D11	D11
27	4796.4480	16764.4380	91.06	E11	E11
28	-456.0620	16953.5670	75.88	E13	E13
29	13715.7500	10001.1880	87.62	M7	M7
30	11079.0800	10007.5330	100.19	M8	M8
31	8449.9710	10012.6380	94.53	M9	M9
32	7366.9880	10017.7620	109.24	A10	A10
33	5817.7030	10017.1740	91.72	M10	M10
34	4727.7820	10009.9800	89.87	A11	A11
35	3172.6930	10007.4210	99.17	M11	M11
36	-513.1410	11654.0030	94.27	C1	C1
37	-513.2420	11675.1940	94.74	C13	C13
38	-2113.5520	9985.8380	101.97	M13	M13
39	-504.7520	9996.5160	103.86	A13	A13
40	2126.1850	9978.3640	98.19	WF2-48-34	WF2-48-34
41	790.7250	9892.4510	110.79	WF2-48-35	WF2-48-35
42	-482.5910	14312.9860	88.06	D13	D13
45	1968.1890	16675.1130	74.41	WF2-49-40	WF2-49-40
46	1742.6400	14444.6500	94.16	WF2-49-39	WF2-49-39
47	2118.4620	11583.2630	96.26	C12	C12
48	7426.3970	10894.3560	97.96	WF2-50-43	WF2-50-43
49	7481.1400	10339.7560	117.69	WF2-50-44	WF2-50-44
50	12365.6570	11070.6110	89.48	WF2-47-32	WF2-47-32
51	12183.3570	10026.8220	93.28	WF2-47-31	WF2-47-31
56	10000.1038	10009.6281	100.00	A9_amended	A9_amended
58	4727.8168	10013.1552	89.09	A11_amended	A11_amended

TRAVERSE POINT WITNESS REPORT

Traverse Point No. 6112

Tech. Sup'r. L. BRYAN

Township WHEATFIELD

Company POLARIS


Recorded
Corner
Code

Field Squad #4 MINSHALL


Date 7-22-78

Sketch and describe roads, monuments found or set, and witness established:

1. N&T IN 20" ASH
N 15W 54.76
2. FOUND 1" IRON ROD IN ϕ OF
BOTH ROADS, EAST 16.03
3. SOUTH LEG OF DIRECTION SIGN
WEST 7.35

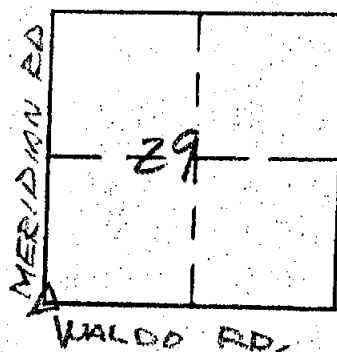


RES.
1007

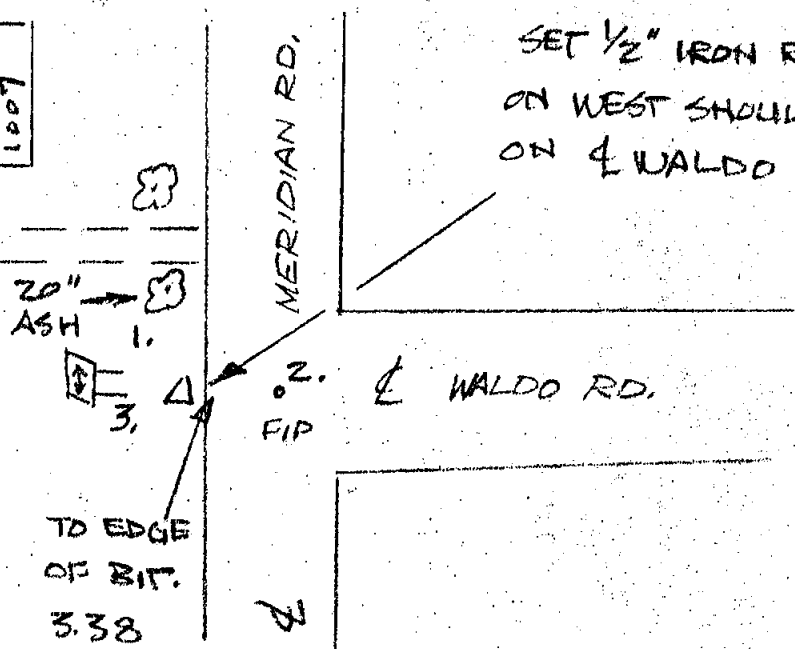

MONUMENTED CORNER REPORT

TECH. SUP'R. L. BRYAN TOWNSHIP WHEATFIELD
 COMPANY POLARIS CORNER CODE C. 11
 FIELD SQUAD #9 MINSHALL - MARTIN RECORDED CORNER YES
 DATE 5.11.78 ROAD NAME MERIDIAN @ WALDO

Sketch, witness, and describe monuments found, and location relative to traverse point and centerline of road.

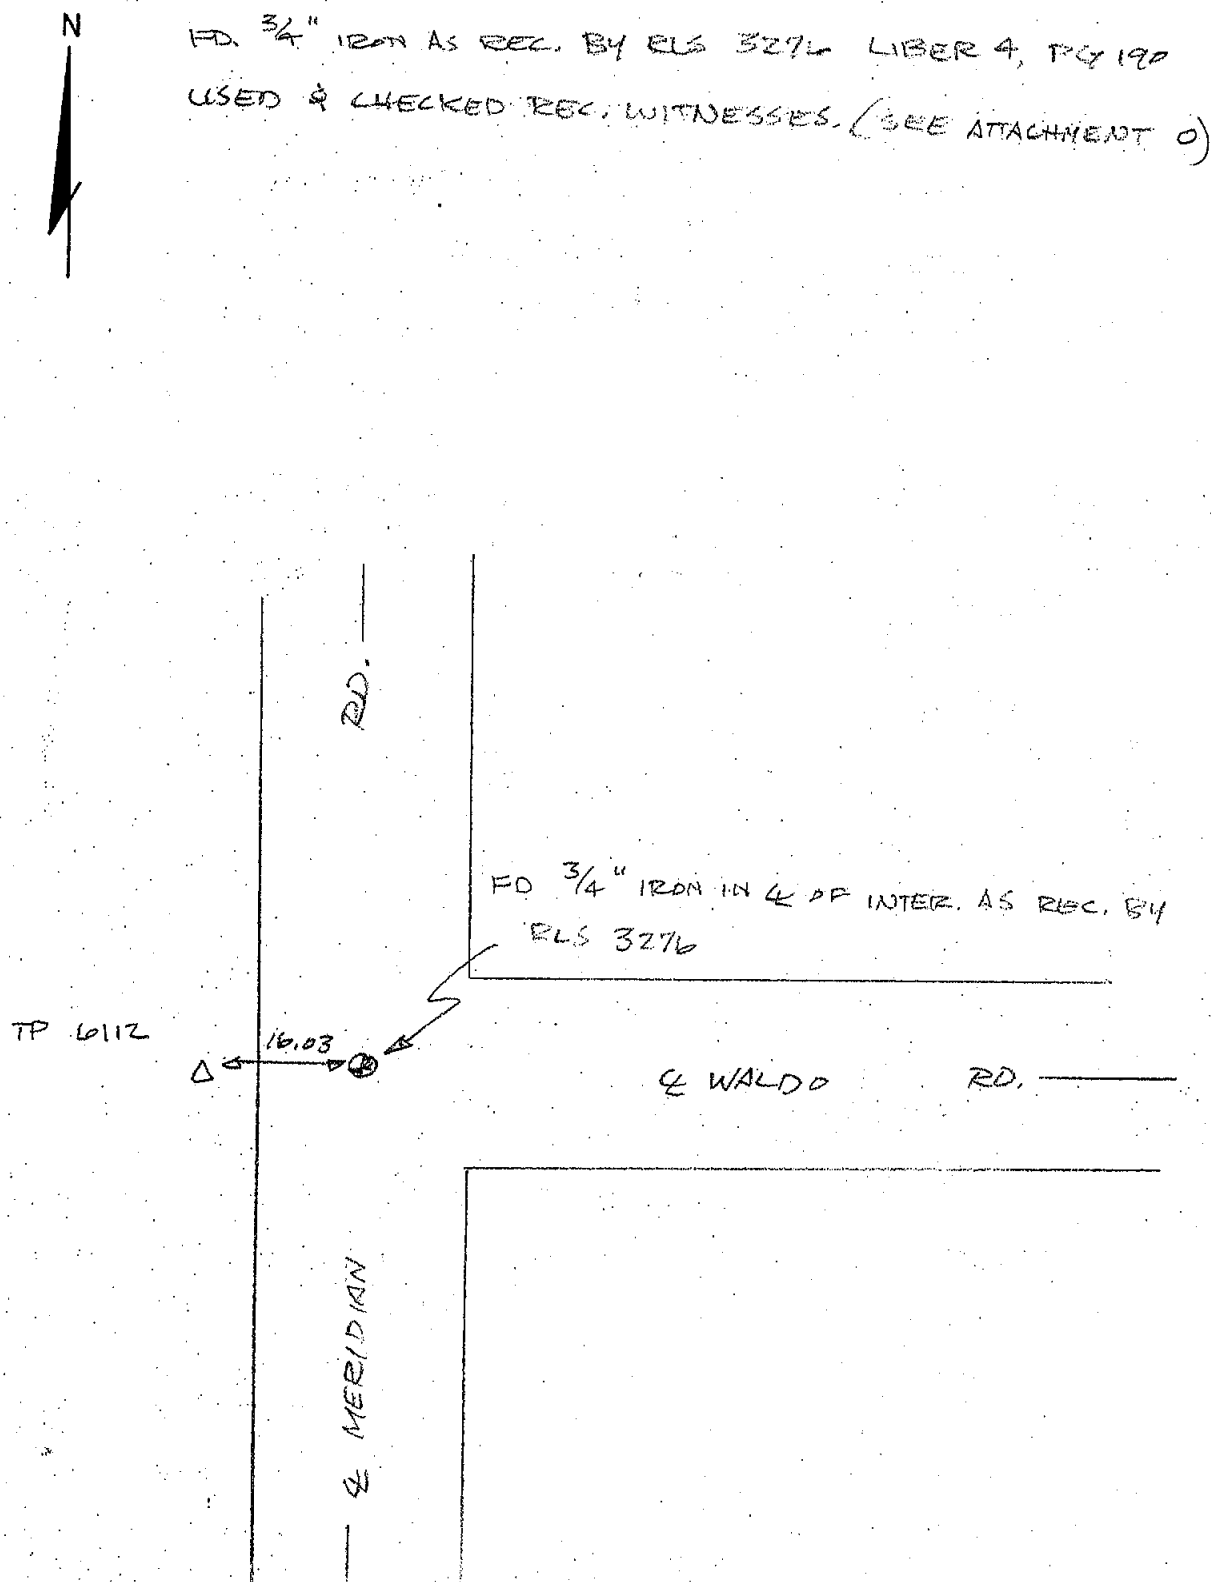

SOURCE: PRELIMINARY FIELD RECON.

TRANSCRIBED from ORIGINAL on file at REMON. OFFICE

PRELIMINARY CORNER FIELD INSPECTION

Date 11-2-77

CORNER
CODE C-11

Team Bob

TWP Wheatfield

Dick

Corner: UNRECORDED

Road Name Intersection of Meridian & Waldo Rd.

Road Surface: CONCRETE ASPHALT GRAVEL OTHER: _____

FILL CUT Section

VISIBLE MONUMENT EVIDENCE: _____ Monument Box

_____ Pipe

X Iron Bar

_____ Nail

_____ Other: _____

_____ No Evidence Visible

MONUMENT LOCATION (Relative to centerline of road)

N

Meridian

Iron Bar

Waldo Rd.

Remarks:

WHEATFIELD
township

T 3 N, R 1 EW

C-11
corner code attachment no.

p. 1 of 1

SOURCE: PRELIMINARY FIELD RECON.

TRANSCRIBED from ORIGINAL on file at REMONUMENTATION PROJECT
~~DUPLICATE~~

PRELIMINARY CORNER FIELD INSPECTION

Date 11-18-77

CORNER
CODE C-12

Team Mills

TWP Wheatfield

Corner: RECORDED

Road Name Meridian (1/2 N of Howell)

Road Surface: CONCRETE ASPHALT GRAVEL OTHER: _____

FILL CUT Section

VISIBLE MONUMENT EVIDENCE:

_____ Monument Box

3/8" X Pipe

_____ Iron Bar

_____ Nail

_____ Other: _____

_____ No Evidence Visible

MONUMENT LOCATION (Relative to centerline of road)

1' West of center
Line

1/2 mile North of
Howell Rd

0 - Wood stake under orange
cone 15' of East edge of
Black top

Remarks:

TRAVERSE POINT WITNESS REPORT

Traverse Point No. 057

Tech. Sup'r. L. BRYAN

Company TOLARIS

Field Squad #4 MISSHALL


Township WHEATFIELD

Recorded
Corner
Code C 12

Date 2-21-78

Sketch and describe roads, monuments found or set, and witness established:

1. N & T IN 6" ASH
N 45 W 50.61
2. N & T IN 6" WILD CHERRY
EAST 52.42
3. N & T IN 4" ASH
WEST 34.63

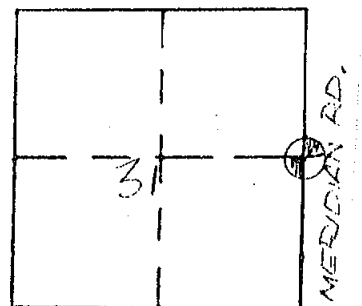

RES.
760

6" ASH 1.
4" ASH 3.

1.
2.
3.
MERIDIAN

FOUND 1/2" IRON
CORNER IN 4 OF RD.
IS DECORDED.
6" CHERRY

SOURCE: Preliminary Corner Field Inspection

TRANSCRIBED from ORIGINAL on file at Remon. Office

~~Duplicate~~

C 13

PRELIMINARY CORNER FIELD INSPECTION

SW 1/4 Sec. 32

Date 11-1-77

Team Bob Martin

Dick Tripp

CORNER
CODE

C-13

TWP

Wheatfield

Corner: RECORDED

Road Name Corner of Meridian Rd. & Howell

Road Surface: CONCRETE ASPHALT GRAVEL OTHER: _____

FILL CUT Section

VISIBLE MONUMENT EVIDENCE:

____ Monument Box (cover)

____ Pipe (inserted or not)


____ Iron Bar

☒ Nail

Other: Plastic Cover & Leader P.S. # 16998

____ No Evidence Visible

MONUMENT LOCATION (Relative to centerline of road)

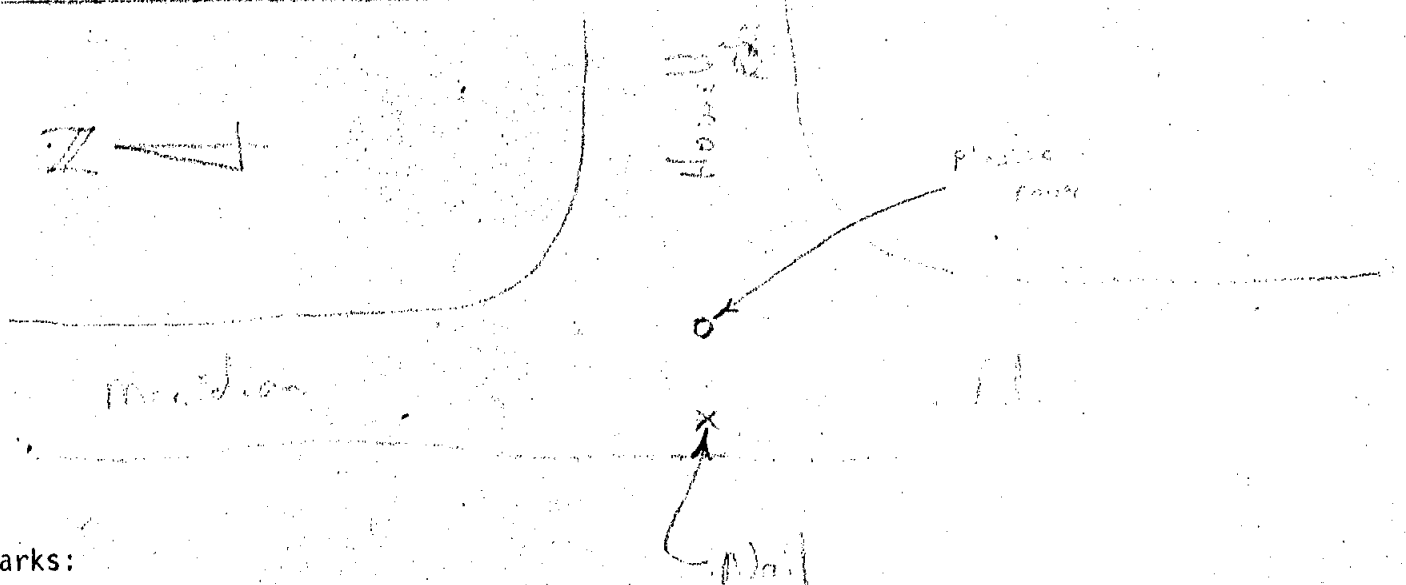

Remarks:

TRAVERSE POINT WITNESS REPORT

Traverse Point No. 6058

Tech. Sup'r. L. BEVAN

Township WHEATFIELD

Company POLARIS

Recorded

Corner

Code C-12


Field Squad #4 MINSHALL

Date 2-21-78

N

Sketch and describe roads, monuments found or set, and witness established:

1. N&T IN 16" OAK
N45E 49.14
2. N&T IN 4" ELM
N40W 82.15
3. N&T IN 36" OAK
N30E 139.65

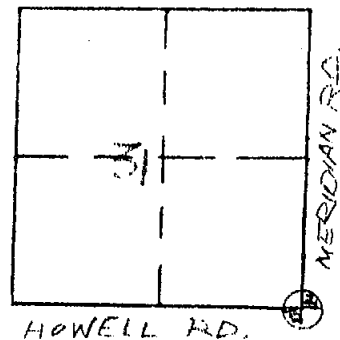

36" OAK

3.

FOUND 1/2" IRON W/ CAP
AS RECORDED BY ELS #
18993

16" OAK

1.

4"
ELM
2.

MERIDIAN RD.



HOWELL RD.

DEAD TREE

FIP

N