


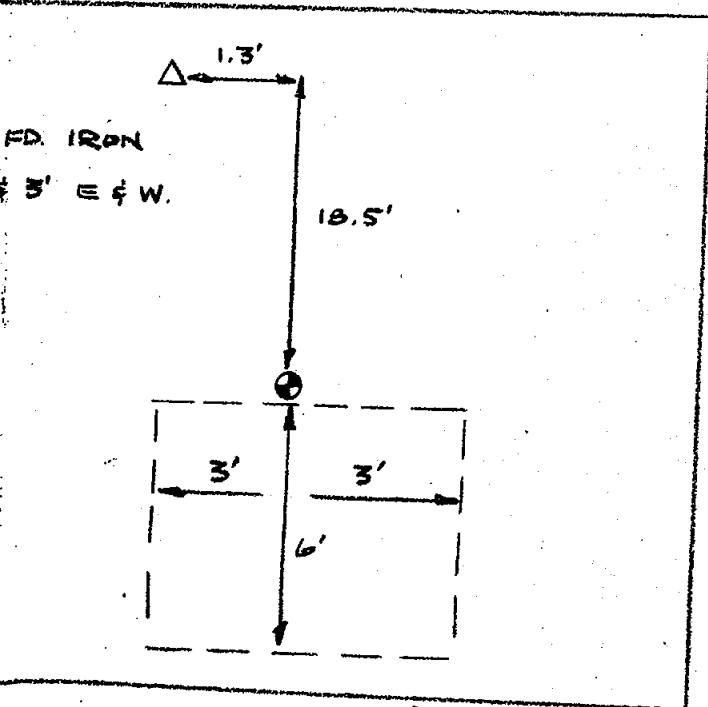


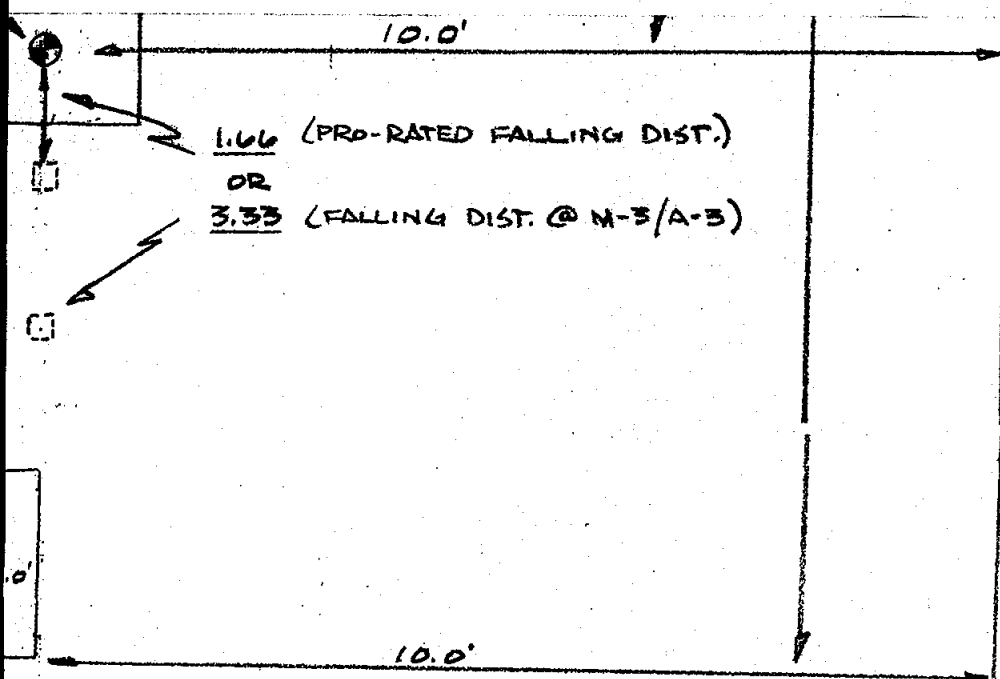

G.L.O.

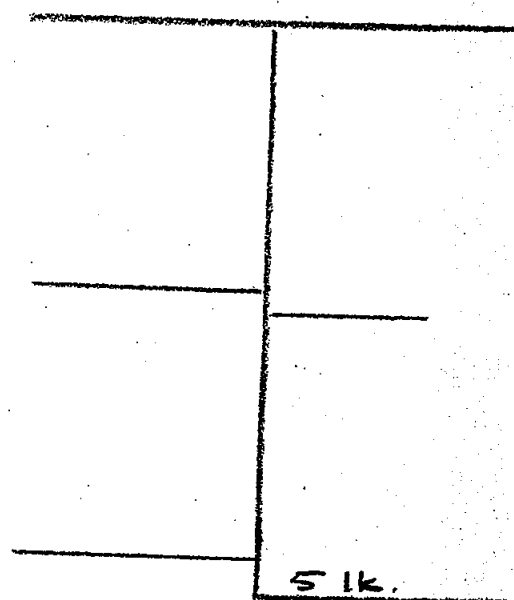

BEGIN EXL. @ FD. IR. 40 W SOUTH E 3' E

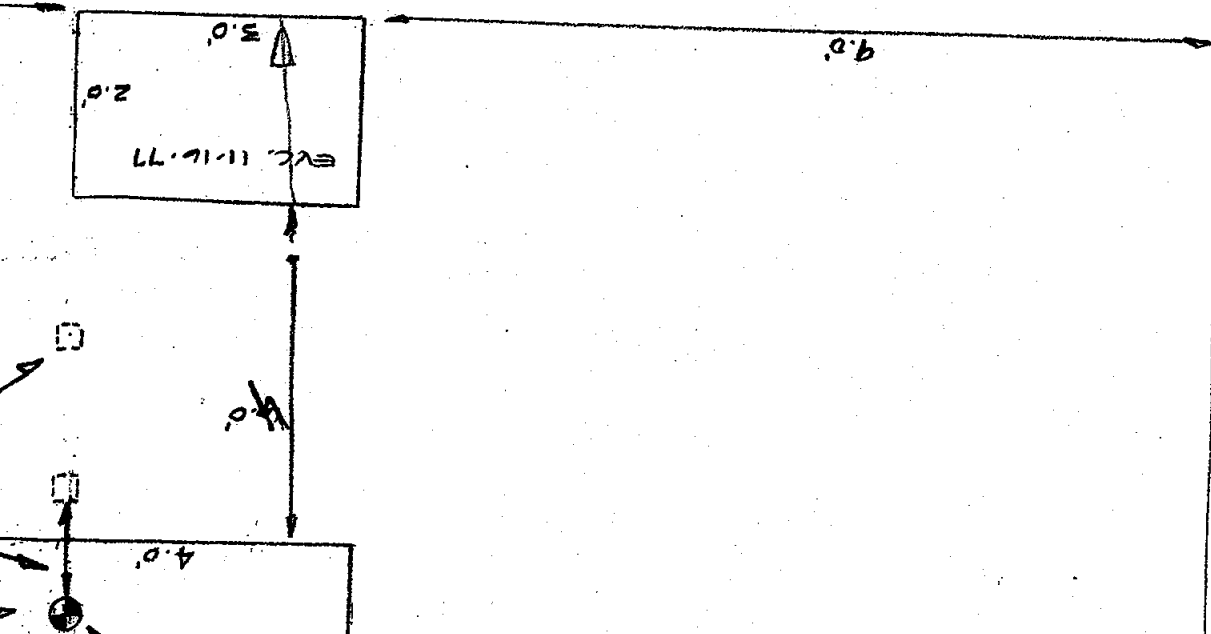

A-2 LOCKE TWP  
M-2 WILLIAMSTON

ALL DISTANCES USED WERE TAKEN FROM THE  
FENCELINE 10' (COMPUTED) NORTH OF EDGE OF RD.,  
SINCE IT IS MORE DEFINATE THAN EDGE OF RD &  
4 MEASUREMENTS. ALSO, ON THE ORIGINAL SKETCHES,  
THEY REMAINED MORE CONSISTANT.

EXC. 11.16.7

3.0'


EXC. 11.9.7

FD. ROCK PI

FWD.



FOOT LINE 16' NORTH OF EDGE OF RD.

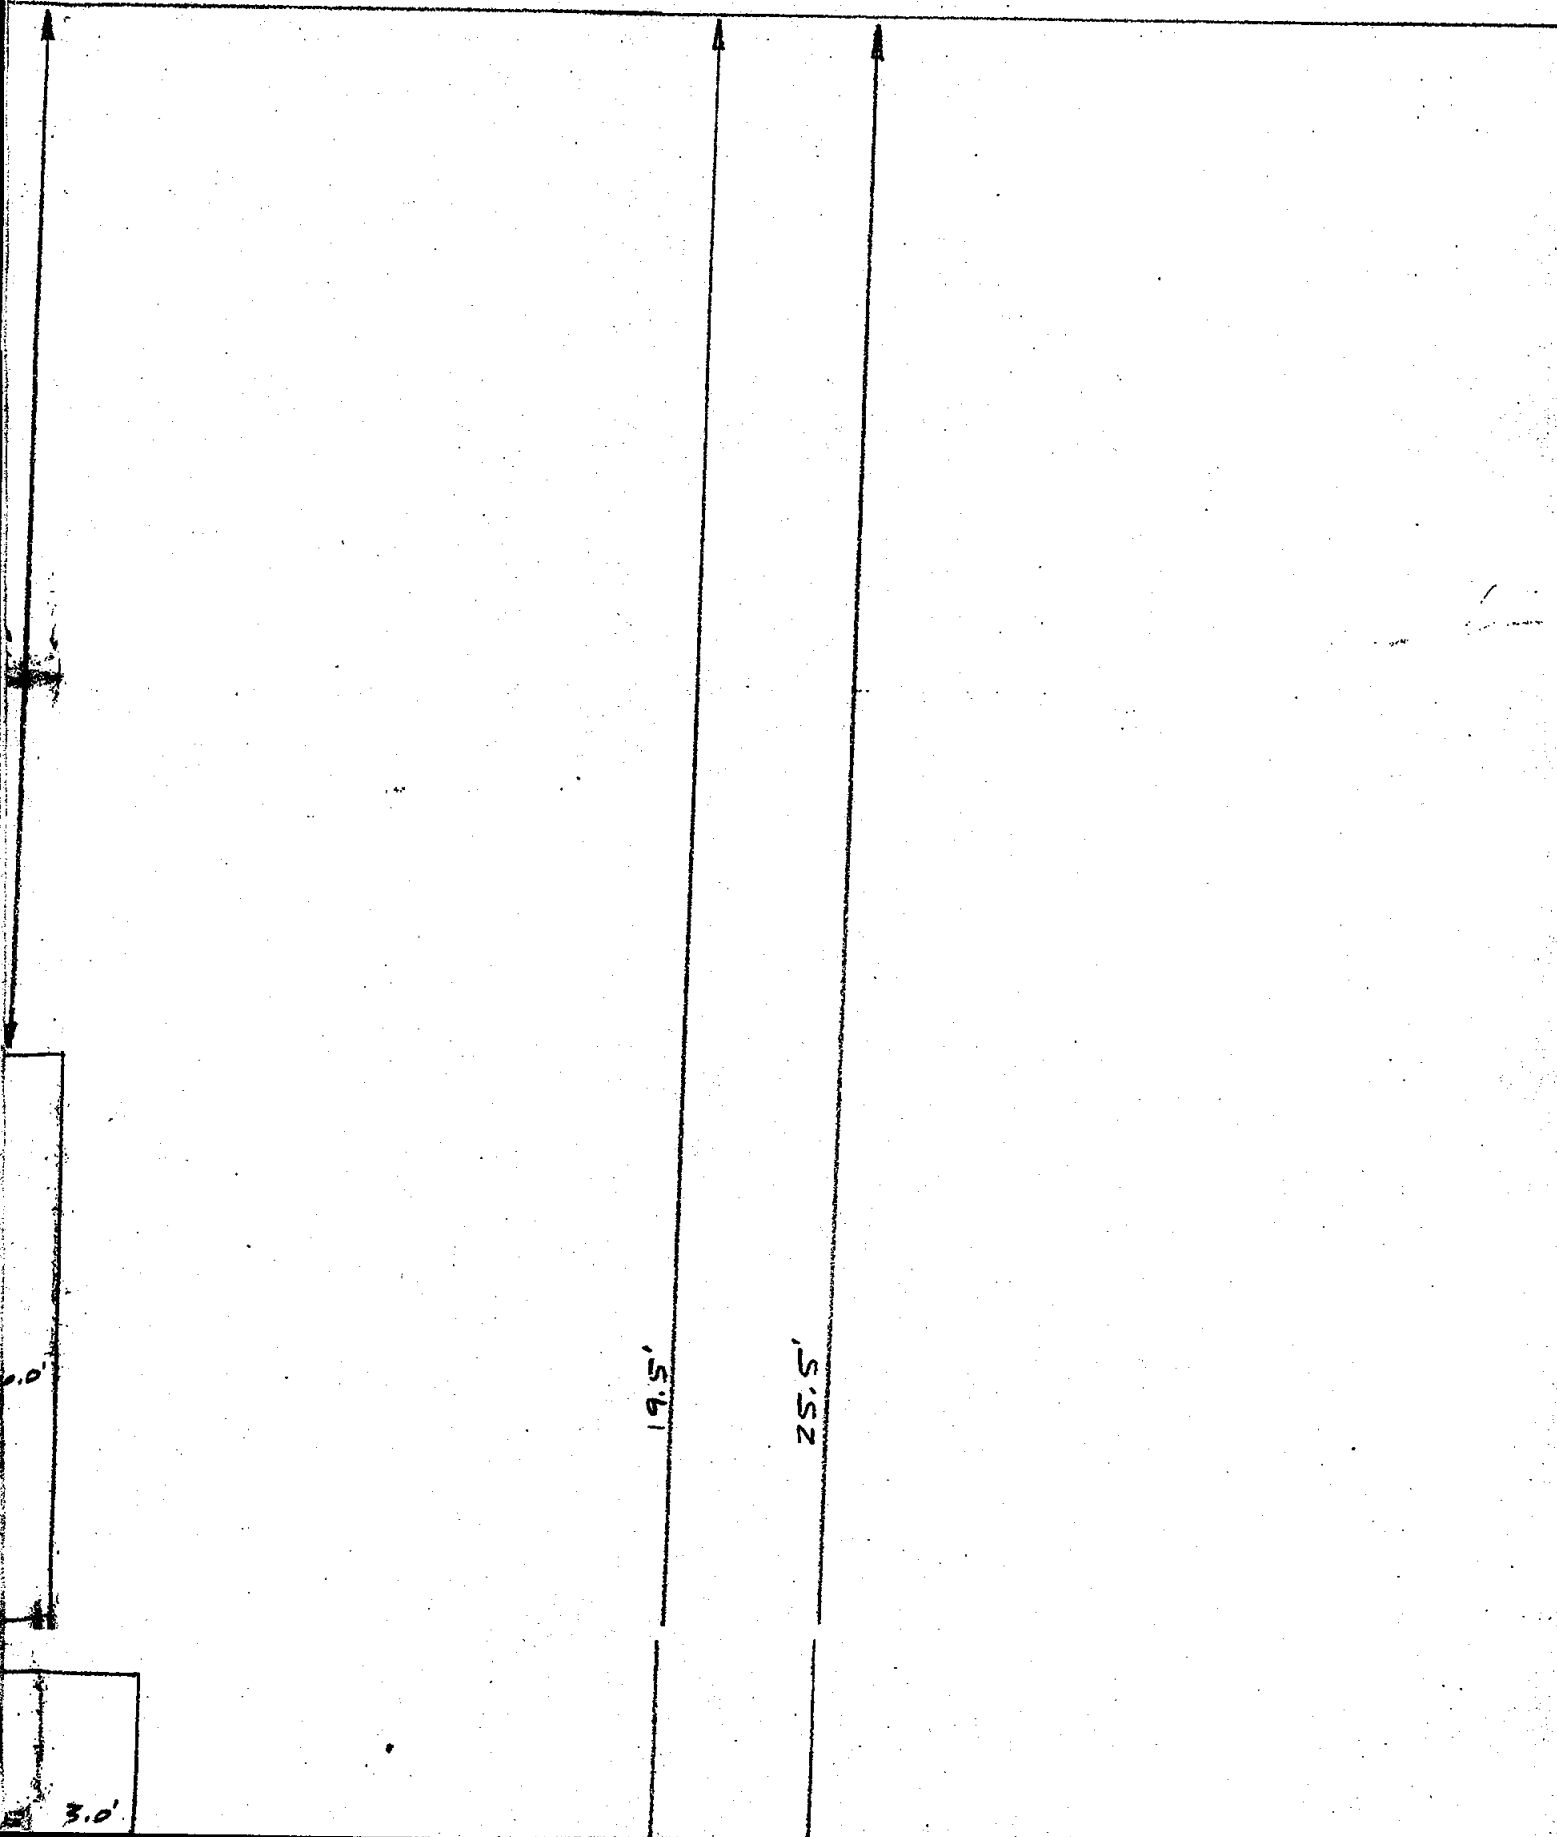

# INGHAM COUNTY SURVEY and REMONUMENTATION PROJECT

Township WILLIAMSTON , T 4 N , R 1E  
 Corner Code 1K-1

| Research Record:                                                                                                                             | attachment<br>number(s) | no. of<br>sheets | researched<br>by | reviewed<br>by |
|----------------------------------------------------------------------------------------------------------------------------------------------|-------------------------|------------------|------------------|----------------|
| Corner Recordation Certificate<br>Liber <u>6</u> Page <u>82</u>                                                                              |                         |                  | <u>Minke</u>     | <u>Jeh</u>     |
| Recorded Land Survey<br>Liber                      Page                                                                                      | <u>N.D.</u>             |                  |                  | <u>Jeh</u>     |
| Recorded Subdivision Plat<br>Liber                      Page                                                                                 | <u>N.D.</u>             |                  |                  | <u>Jeh</u>     |
| MDSHT Right-of-Way Maps<br>Sheet No.                                                                                                         | <u>N.D.</u>             |                  |                  | <u>Jeh</u>     |
| Ingham County Road Comm. Maps<br>Sheet No.                                                                                                   | <u>N.D.</u>             |                  |                  | <u>Jeh</u>     |
| Record of the Ingham County<br>Surveyor Vol. <u>2</u> Page <u>82</u> Year <u>1849</u><br><u>14</u> <u>14-15</u> <small>WRONG-SECTION</small> | <u>1</u><br><u>N.D.</u> | <u>1</u>         |                  | <u>Jeh</u>     |
| General Land Office Maps<br>Sheet No. <u>16</u>                                                                                              | <u>2</u>                | <u>1</u>         |                  | <u>Jeh</u>     |
| Form 280, Gov't. Monument<br>Witness Record                                                                                                  | <u>N.D.</u>             |                  |                  | <u>Jeh</u>     |
| Ingham County Drain Comm.<br>File No.                                                                                                        | <u>N.D.</u>             |                  |                  | <u>Jeh</u>     |
| East Lansing City Engineer                                                                                                                   | <u>N.D.</u>             |                  |                  | <u>Jeh</u>     |
| Lansing Public Service Office<br>Cade's 1921 Survey p.                                                                                       | <u>N.D.</u>             |                  |                  | <u>Jeh</u>     |
| Lansing Public Service Office<br>J.B. Davis' Field Notes p.                                                                                  | <u>N.D.</u>             |                  |                  | <u>Jeh</u>     |
| G.L.O. Field Notes <u>p. 28</u>                                                                                                              | <u>3</u>                | <u>1</u>         |                  | <u>Jeh</u>     |
| Misc. I.C. S. Notes                                                                                                                          | <u>N.D.</u>             |                  |                  | <u>Jeh</u>     |
| Field Recon. Form                                                                                                                            | <u>N.D.</u>             |                  | ✓                | <u>Jeh</u>     |
| RESEARCH COMPLETED<br>date                                                                                                                   | Total                   | Total            |                  |                |
| Consumers Power Company<br>Sheet No.                      Index No.                                                                          | <u>N.D.</u>             |                  | <u>Minke</u>     | <u>Jeh</u>     |
| Chesapeake & Ohio Railroad Co.<br>Val.                      Sec.                      Drawer                      Sheet                      | <u>N.D.</u>             |                  | <u>"</u>         | <u>Jeh</u>     |
| RESEARCH COMPLETED<br>date                                                                                                                   | Total                   | Total            |                  |                |
| REMARKS                                                                                                                                      |                         |                  |                  |                |
| <u>NOTHSTINE NOTES</u>                                                                                                                       | <u>N.D.</u>             |                  | <u>Minke</u>     | <u>Jeh</u>     |
| <u>FOLDER SET #1</u> <u>p. 4</u><br><u>p. 3</u>                                                                                              | <u>N.D.</u><br><u>4</u> | <u>1</u>         | <u>"</u>         | <u>Jeh</u>     |
| <u>FOLDER SET #2</u> <u>p. 2</u>                                                                                                             | <u>N.D.</u>             |                  | <u>"</u>         | <u>Jeh</u>     |

INGHAM COUNTY - WILLIAMSTON TWP.  
**LAND CORNER RECORDATION CERTIFICATE**  
FILING REQUIREMENT OF ACT 74, MICH. P.A. 1970

| FOR CORNERS OF:-                                                          | LOCATED IN:- | CORNER CODE NUMBER |
|---------------------------------------------------------------------------|--------------|--------------------|
| 1. PUBLIC LAND SURVEY_____ T. <u>4</u> N. S. R. <u>1</u> E. W.            |              | <u>K-1</u>         |
| 2. PROPERTY CONTROLLING IN SECTION_____ , T. _____ N. S. R. _____ E. W.   |              |                    |
| 3. MISCELLANEOUS PROPERTY IN SECTION_____ , T. _____ N. S. R. _____ E. W. |              |                    |
| 4. LOT NO. _____ , RECORDED PLAT _____                                    |              |                    |
| 5. PRIVATE CLAIMS _____                                                   |              |                    |

REGISTER OF DEEDS STAMP AND  
FILING NUMBER

I, Ronnie M. Lester, do hereby certify that under requirements of P.A. 74, Michigan P.A. of 1970, the corner points mentioned in lines 1 and 2 above were, in a field survey on June 19, 1980, established, re-established, monumented, re-monumented, recovered or restored as expressed below and in conformance with regulations and rules therefore as required in the current manual of survey instructions of the United States Department of the Interior, Bureau of Land Management or by a decree of a court of law. Furthermore, that the corner points mentioned in lines 3, 4 and 5 above were, in a field survey on \_\_\_\_\_, 19\_\_\_\_, found, recovered, restored, established or re-established as expressed below and in conformance with the rules of the Michigan State Board of Registration for Land Surveyors or, by a Decree of a Court of law:

-1 A. Description of original monument and accessories and/or subsequent restoration:

Post set in original government survey by Joseph Wampler, March 3-13, 1826.  
Corner referred to in a survey by L.D. Preston, County Surveyor, February 24, 1849 (v.2, p.82).

-1 B. Description of corner evidence found and/or method applied in restoring or re-establishing corner:

Excavated a 10.0' x 11.0' hole to an average depth of 2.0' at the intersection of the centerlines of Milton Road and Bently Road. Found no evidence to verify corner. Corner considered lost. Corner set on township line between K-13 and L-13 Woodhull Township at the GLO falling from K-13. Measured east + 2583' to L-1 and west + 2649' to J-1. Excavation conducted by Ingham County Survey and Remonumentation Project crew.

-1 C. Description of monument for corner and accessories established to perpetuate locating the position of the corner:

NW Corner, Section 1, T4N-R1E  
Set 4" x 36" concrete monument with 1/2" x 38" rerod and cap #18998, with concrete collar and cover  
Nail & tag, #18998, on copper iron, NW, 3.58'  
Nail & tag, #18998, northeast side 16" Hickory, WSW, 46.15'  
Nail & tag, #18998, northwest side power pole, NE, 103.19'  
Nail & tag, #18998, southwest side 36" Oak, ESE, 47.11'  
Nail & tag, #18998, north side 34" Oak, ESE, 87.68'  
K-13 Woodhull Township, T5N-R1E, Shiawassee County, West, 147.84'

SIGNED BY Ronnie M. Lester DATE Aug 19, 1980

SURVEYOR'S MICHIGAN REGISTRATION NO. 18998

(SEAL)

SIGNED BY GARY D. LESTER

CHIEF OF SURVEY PARTY

DATE

8-19-80

MICHIGAN REGISTERED LAND SURVEYOR

Director, Ingham County Survey  
and Remonumentation Project


(SEAL)

SURVEYOR'S MICHIGAN REGISTRATION NO. 17624

# MONUMENTED CORNER REPORT

TECH. SUP'R. RON LESTER TOWNSHIP WILLIAMSTON  
 COMPANY POLARIS CORNER CODE K-1  
 FIELD SQUAD DALE RECORDED CORNER \_\_\_\_\_  
 DATE 6-19-80 ROAD NAME MILTON AT BENTLEY


Sketch, witness, and describe monuments found, and location relative to traverse point and centerline of road.

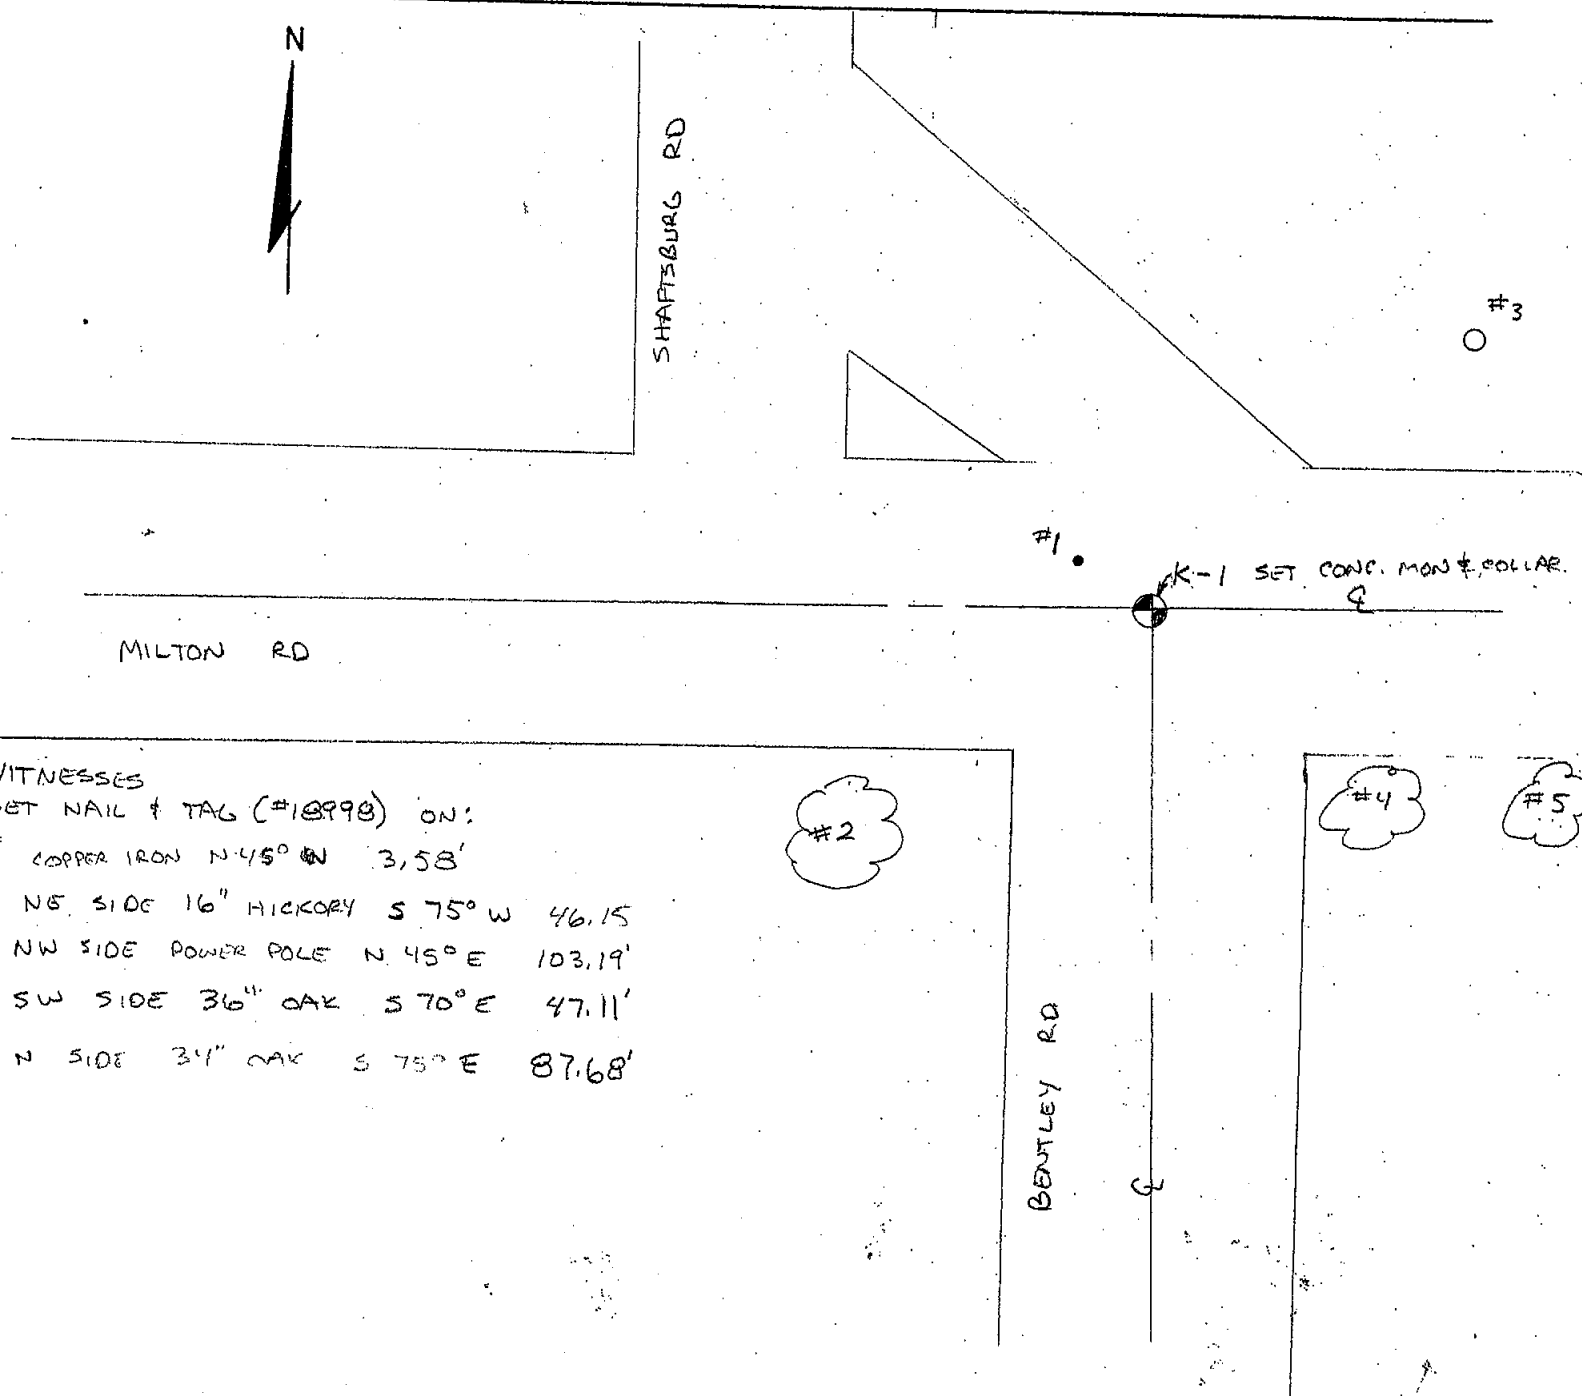

# MONUMENTED CORNER REPORT

TECH. SUP'R. \_\_\_\_\_ TOWNSHIP WILLIAMSTON  
 COMPANY \_\_\_\_\_ CORNER CODE K-1  
 FIELD SQUAD \_\_\_\_\_ RECORDED CORNER \_\_\_\_\_  
 DATE \_\_\_\_\_ ROAD NAME Milton at Bentley

Sketch, witness, and describe monuments found, and location relative to traverse point and centerline of road.

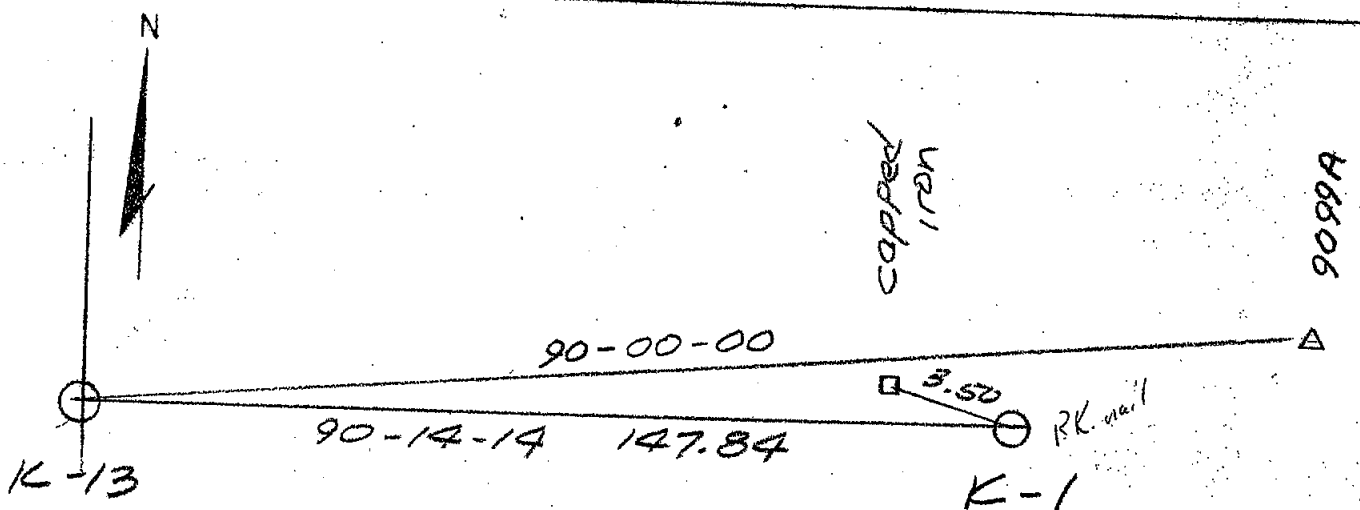

K-13 to capped iron 144.68'  
 K-13 to tag W. side 14" 55°E 21.68  
 " " W. side 16" 545°E 38.55'

K-1 - set PK nail

tag NW side 28" Hick 575W 47.63'  
 " N " 36" oak 575E 47.46  
 capped iron N 75 W 3.50'


K-13



# PRELIMINARY EXCAVATION REPORT

TECH. SUP'R. \_\_\_\_\_ TOWNSHIP WILLIAMSTON  
 COMPANY \_\_\_\_\_ CORNER CODE K-1  
 FIELD SQUAD \_\_\_\_\_ ROAD NAME MILTON / BENTLEY

Sketch, witness, and describe monuments found and proposed excavation site relative to traverse point and centerline of road.

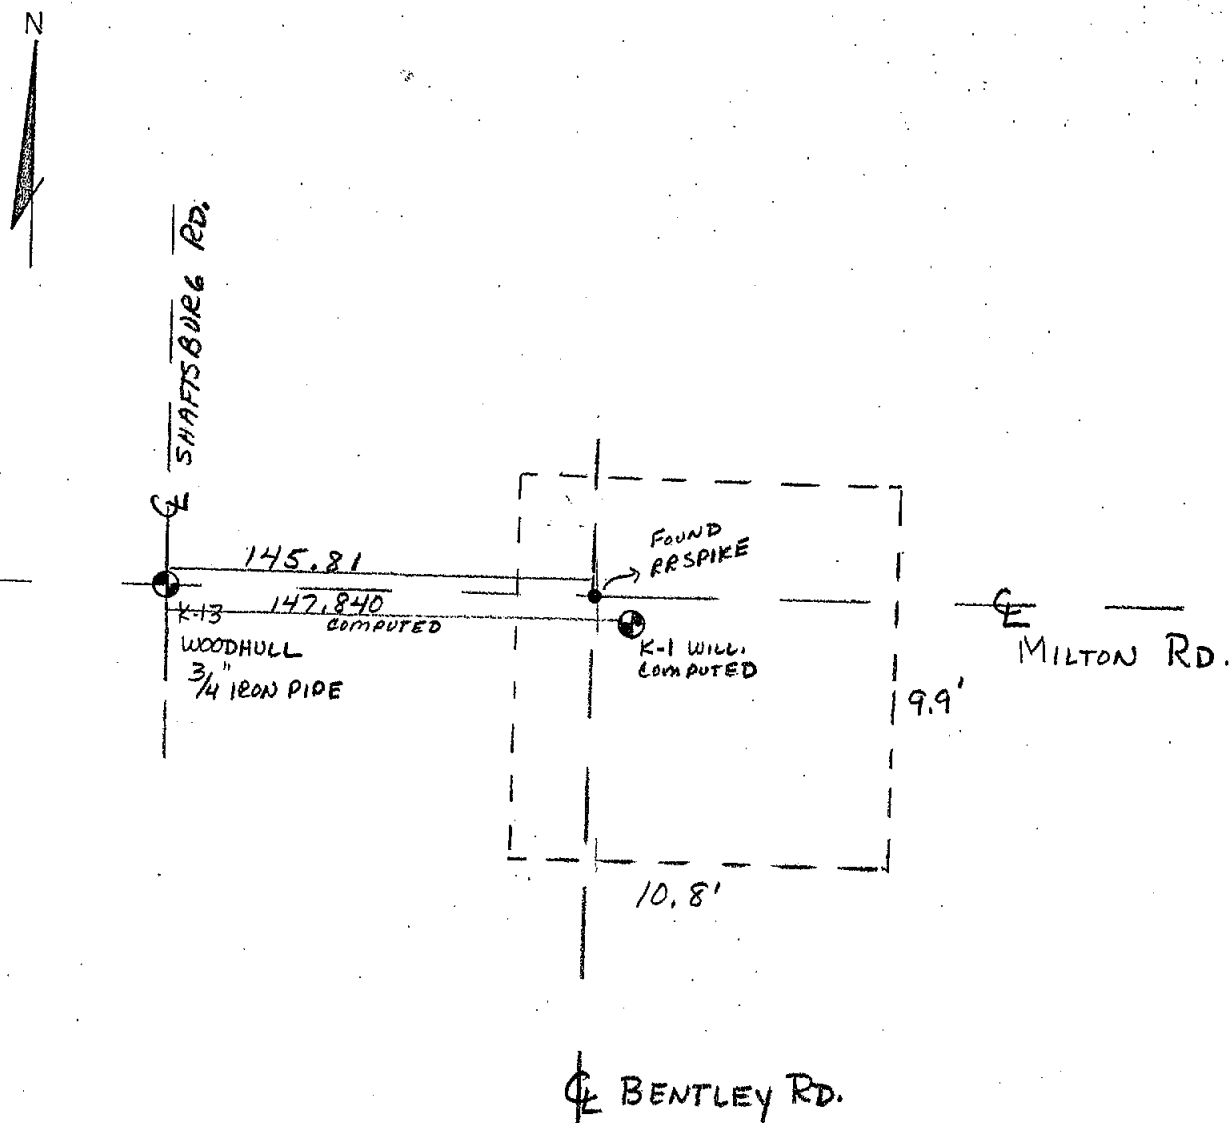

Set corner as shown

USE INCHES:

K-13 → 9099A 90-00-00  
 K-13 → K-1 90-14-14 147.84

Corner set on Twp Line between K-13 & L-13 at

611' from K-13

RL 4/1/50

OK 116


TRAVERSE SKETCH FORM

INGHAM COUNTY

TOWNSHIP WILLIAMSTON T4N-R1E

FIELD WORK BY J. AUTENRIETH DATE 1/18/80

COMPUTED BY D. LANGSCHIED DATE 2/14/80 FROM J-1 TO L-1 TRAVERSE K-1

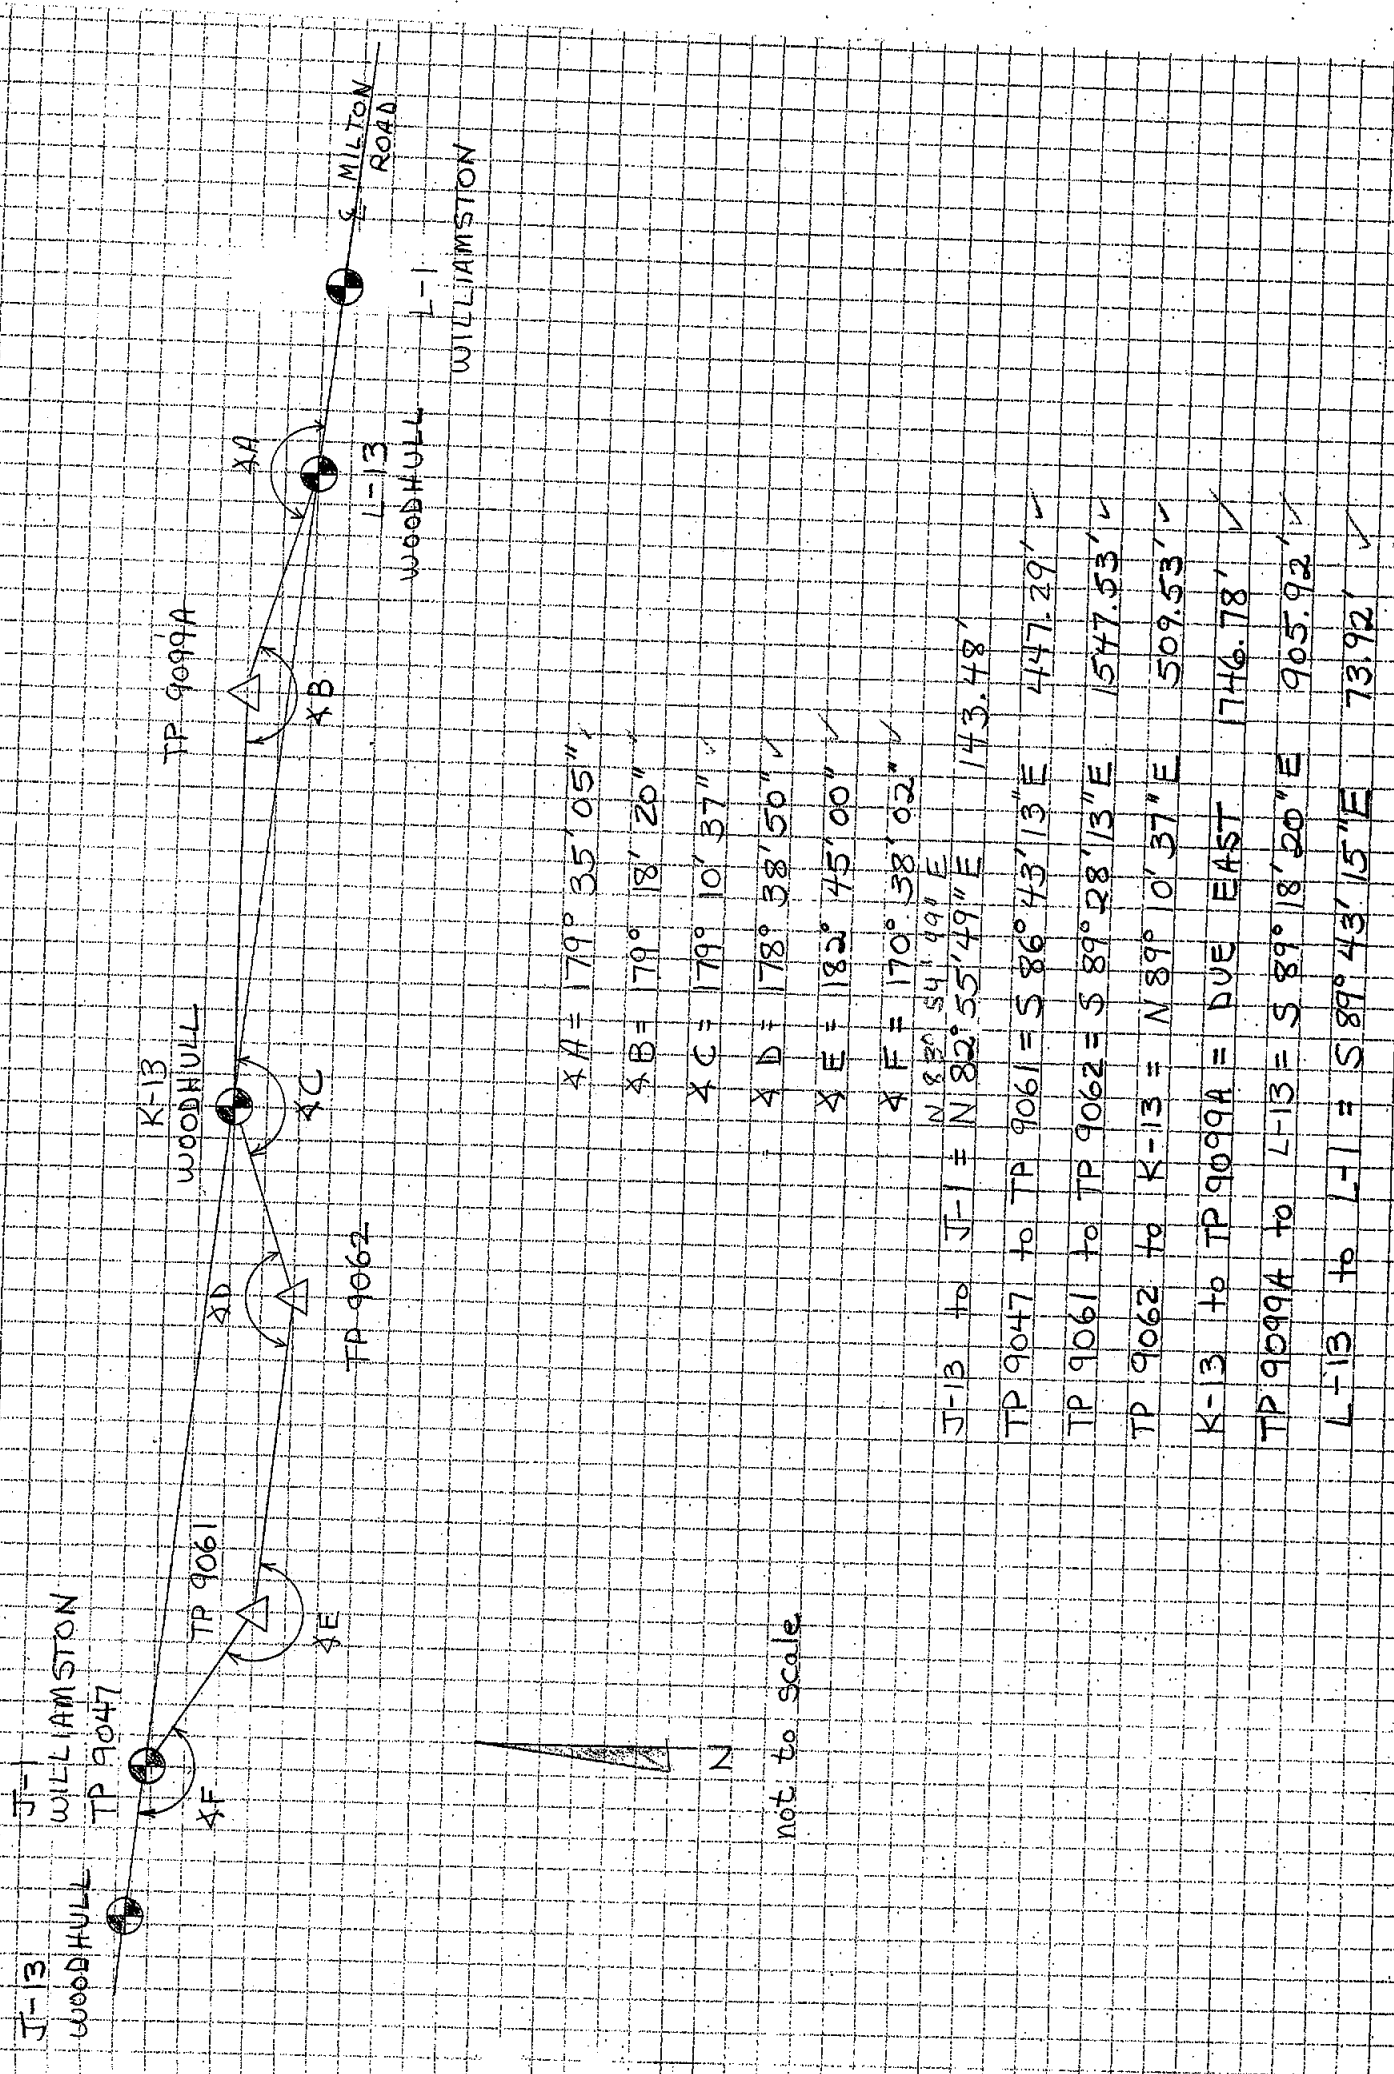

OK DL

TRAVERSE K-1

TO 2-

[illegible]

TOWNSHIP Williamston T4N-

OK W


FIELD WORK BY J. AUTENRIETH DATE 1-18-80 TRAVERSE K-1

COMPUTED BY M. MENKE DATE 2-19-80 FROM J-1 TO L-1

[illegible]



TRAVI  
TOWNSHIP W14  
FIELD WORK BY J. AUTENRIET  
COMPUTED BY D. LANGSCHIED

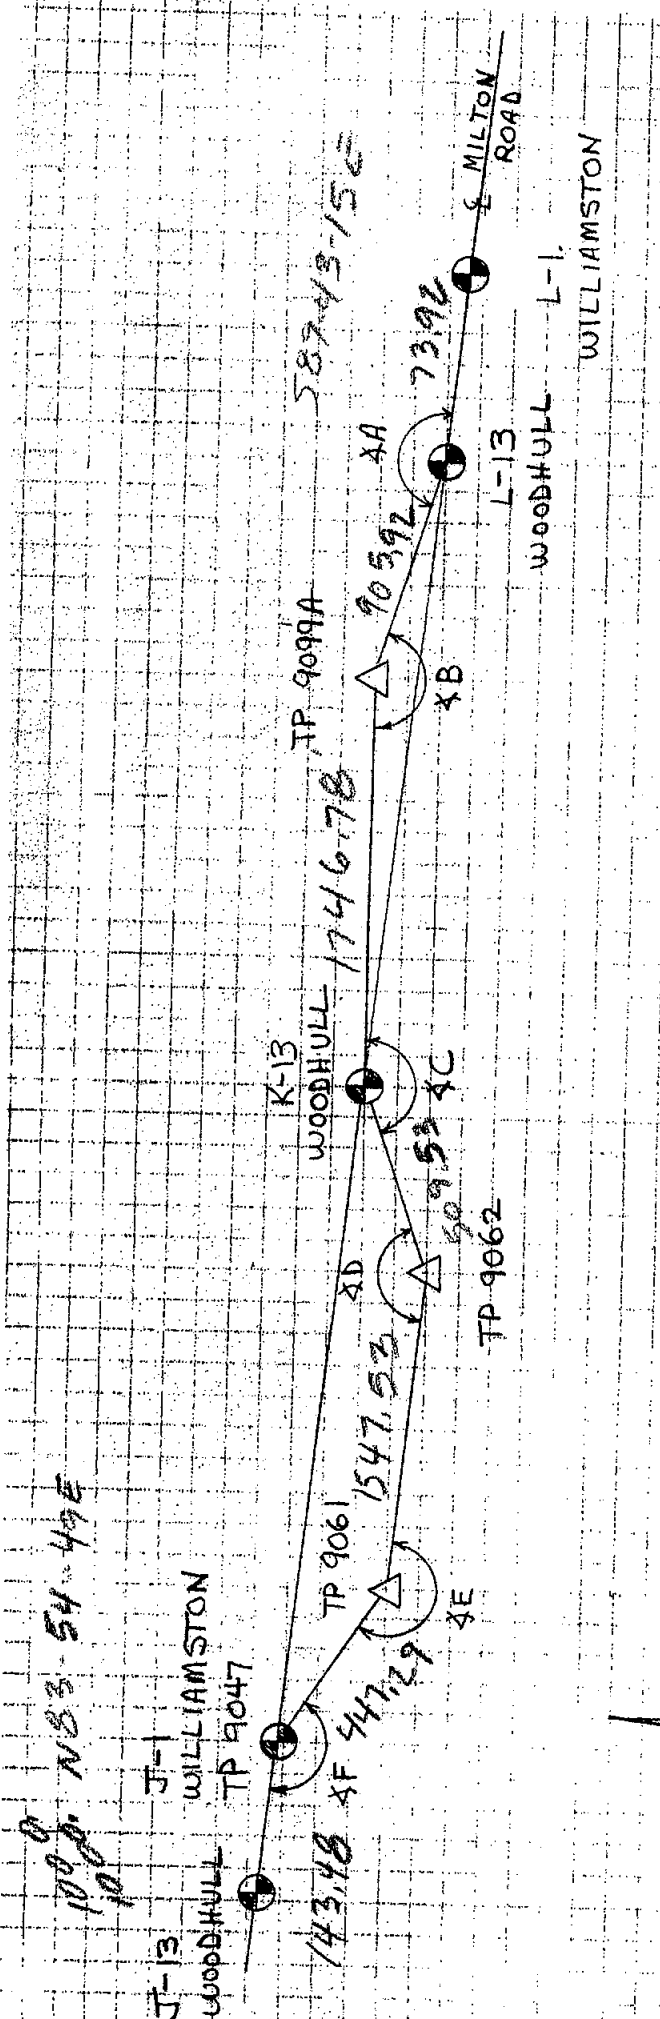

|           |     |          |     |
|-----------|-----|----------|-----|
| 13220.00  | *** |          |     |
| 1.0000    | *** | 1.       | *** |
| 1000.0000 | *** | 1000.000 | *** |
| 1000.0000 | *** | 1000.000 | *** |
| 83.5449   | *** | 90.2234  | *** |
| 83.5449   | *** | -89.3726 | *** |
| 143.4800  | *** | 2646.227 | *** |
| 2.0000    | *** | 5.       | *** |
| 1015.2129 | *** | 982.635  | *** |
| 1142.6712 | *** | 3646.170 | *** |
| 93.1647   | *** | 90.1414  | *** |
| 447.2900  | *** | -89.4546 | *** |
|           |     | 2652.656 | *** |
|           |     | 7.       | *** |
|           |     | 971.655  | *** |
|           |     | 6298.803 | *** |
| 3.0000    | *** | 2.       | *** |
| 989.6231  | *** | 1015.213 | *** |
| 1589.2286 | *** | 1142.671 | *** |
| 90.3147   | *** | 90.2852  | *** |
| 1547.5300 | *** | -89.3108 | *** |
| 4.0000    | *** | 5230.236 | *** |
| 975.3158  | *** | 8.       | *** |
| 3136.6925 | *** | 971.295  | *** |
| 89.1037   | *** | 6372.723 | *** |
| 509.5300  | *** |          |     |
| 5.0000    | *** |          |     |
not to scale

|                 |  |
|-----------------|--|
| TP 9047 to TP   |  |
| TP 9061 to TP   |  |
| TP 9062 to K-   |  |
| K-13 to TP 9091 |  |
| TP 9099A to L-  |  |

L-13 to L-1 = S 89° 43' 15" E 73.92'

9 SHAFTSBURG ROAD

SHAFTSBURG ROAD

NOT TO  
SCAL

X-13 Woodwell

C MILTON ROAD

Found 3/4" Pipe

TP9054

## Found R.R. Spike

2.2'

2.4'

C BENTLY ROAD

0.6' ASPHALT

0.7' GRAVEL

CLAY

DEPTH 2.0'

NOTES:

1. FOUND NOTHING TO VERIFY CORNER.
2. CORNER LOST. L.B. 11/27/78

# CORNER EXCAVATION REPORT

TECH. SUP'R. C. GILLESPIE TOWNSHIP WILLIAMSTON  
 COMPANY POLARIS CORNER CODE K-1  
 FIELD SQUAD M. WHIPPLE #3 PAGE 1 OF 1 DATE 11-22-78


EXCAVATED AREA: 58' SQ. FT.; AVG. DEPTH 2.0 SURFACE ASPHALT

Sketch and describe roads, monuments found or set, and witnesses established:



FOUND NOTHING TO  
VERIFY CORNER

0.6' ASPHALT  
0.7' GRAVEL  
0.7' CLAY

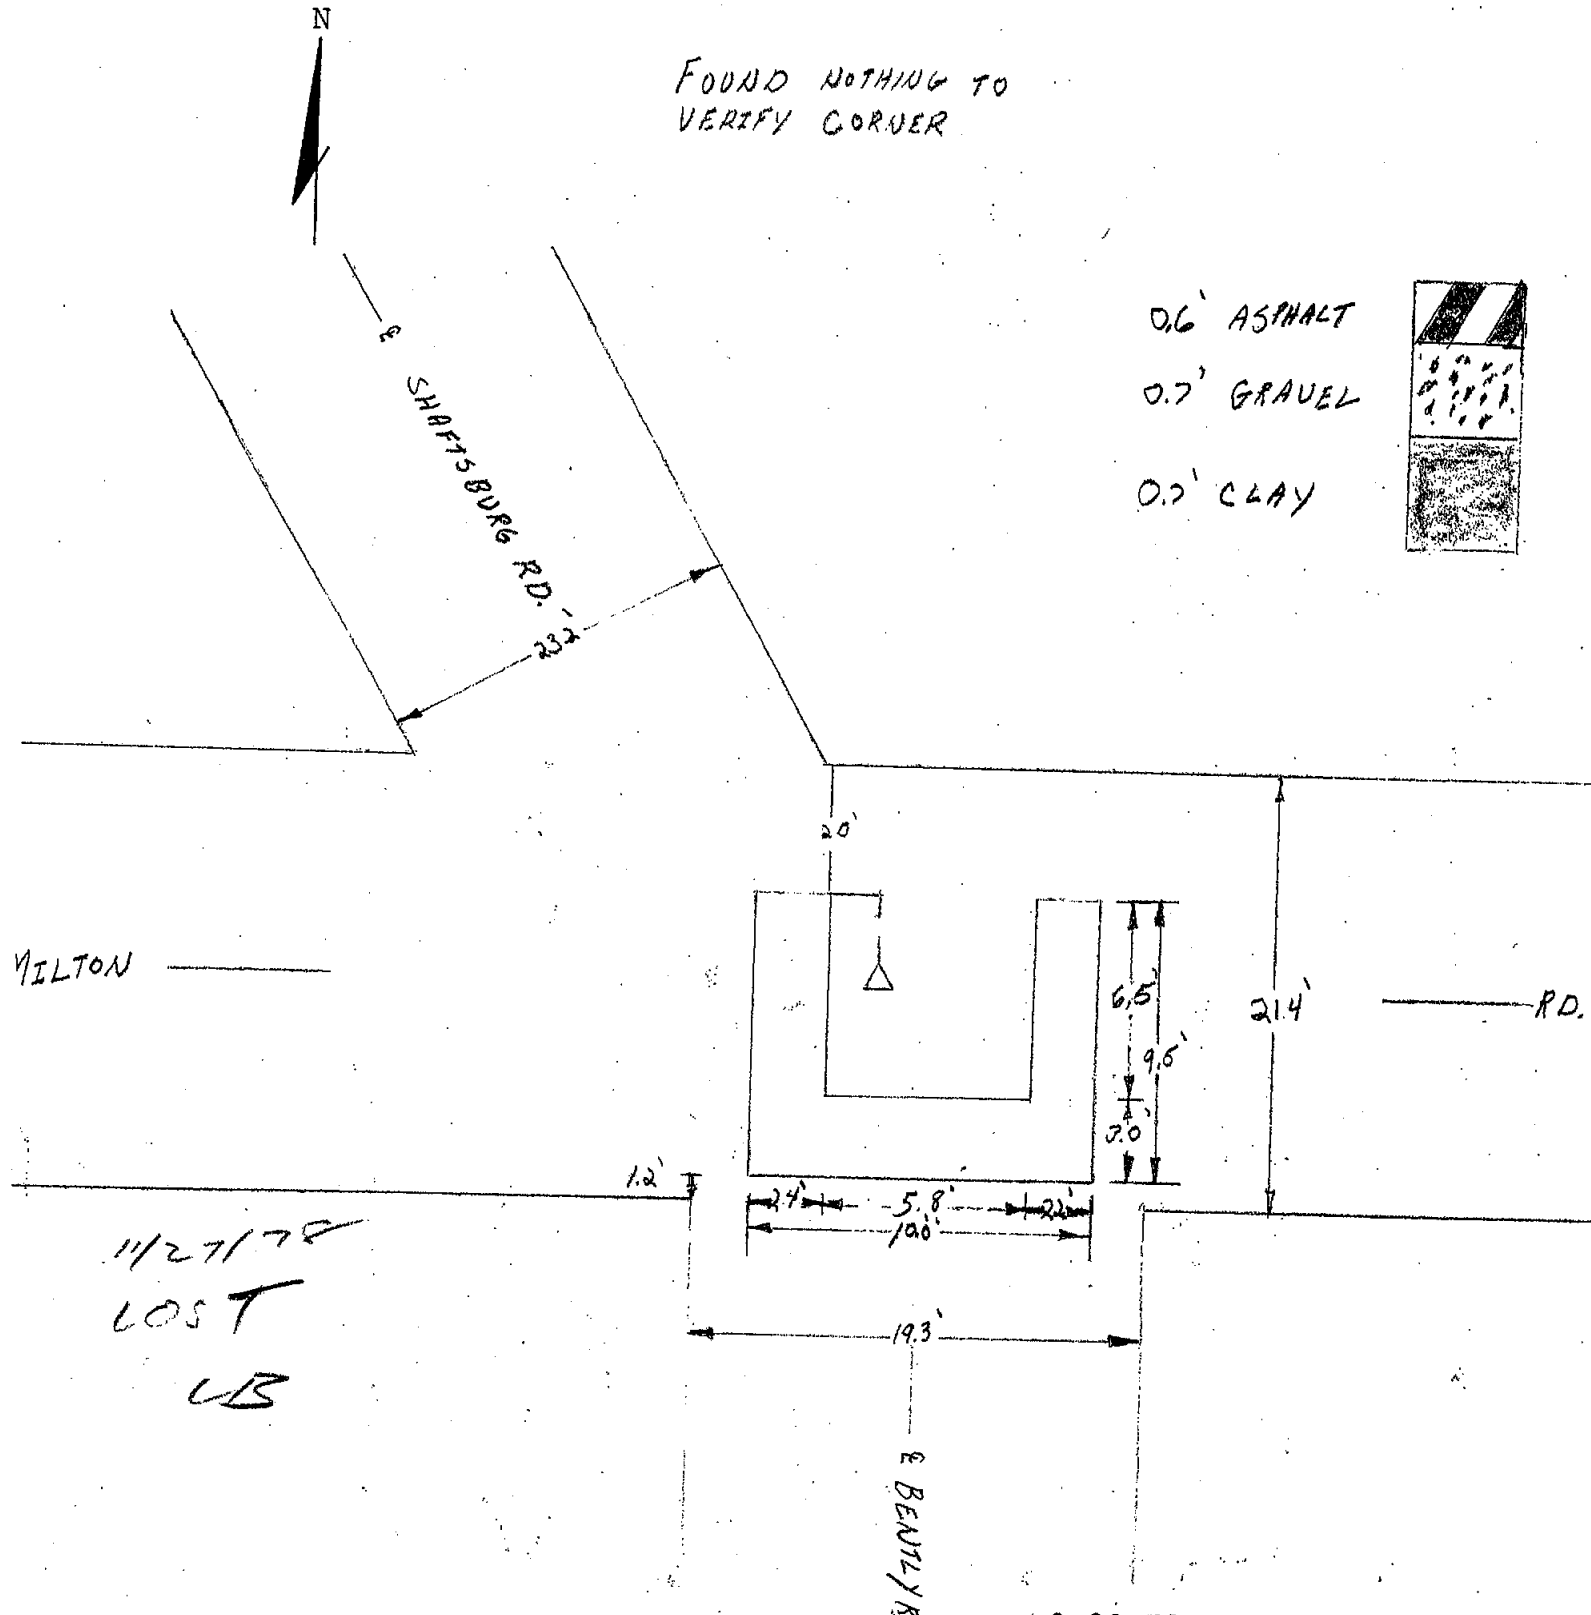




# CORNER EXCAVATION REPORT

TECH. SUP'R. C. GILLESPIE TOWNSHIP WILLIAMSTON  
 COMPANY POLARIS CORNER CODE K-1  
 FIELD SQUAD M. WHIPPLE PAGE 1 OF 1 DATE 11-21-78

EXCAVATED AREA: 42' SQ. FT.; AVG. DEPTH 2.0' SURFACE ASPHALT


Sketch and describe roads, monuments found or set, and witnesses established:  
 PT (A) FD RR SPIKE CUT IN HALF 0.3' BELOW ROAD SURFACE  
 N 0.6' OF ASPHALT, TOP OF RR SPIKE WAS HALF WAY IN ASPHALT  
 6.72' WEST  
 9.01' NW  
 7.70' NORTH

PT (B) FD. 1/2" RE-ROD W/ING TEMP CAP TP# 9054  
 4.70' SW  
 5.63' NW  
 5.70' NE

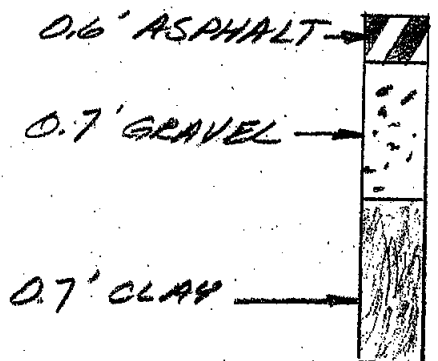

SHAFER RD

E MILTON

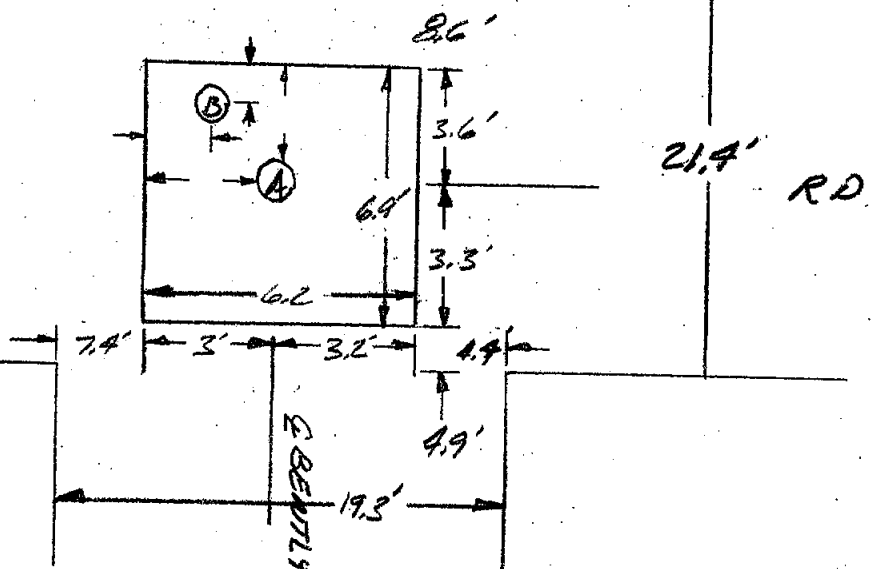

# PRELIMINARY EXCAVATION REPORT

TECH. SUP'R. L. BRYAN TOWNSHIP WMSTN.

COMPANY POLARIS CORNER CODE K-1

FIELD SQUAD #9 UNUSUAL ROAD NAME MILTON @ BENTLEY / ASPHALT

Sketch, witness, and describe monuments found and proposed excavation site relative to traverse point and centerline of road.

BELMIN EXCAVATION 2.4' EAST & 2.2' SOUTH OF TP 9054



SHAFTSBURG RD.

145.81'

MILTON

TP 9054

RD.

FD. 3/4" PIPE  
 & MILTON  
 & SHAFTSBURG


FD. READING (DEEP)  
 IN & OF INTER.

BENTLY RD.

TP 9054

2.2'

2.4'

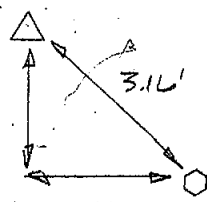

OK ULM

10/31/78


K-1

FD. R.R. SPIKE 0.3' below RD SURFACE.  
ALSO FD. 1/2" RE-ROD W/ INQ. CO. TEMP. CAP # T.P. 9054.  
NO OTHER EVIDENCE VISIBLE, MUST FINISH  
EXCAVATION AS CALLED FOR.

CQH.

# VILLIAMSTON

T. 3-4 N-R. 1 E. <sup>M2</sup>

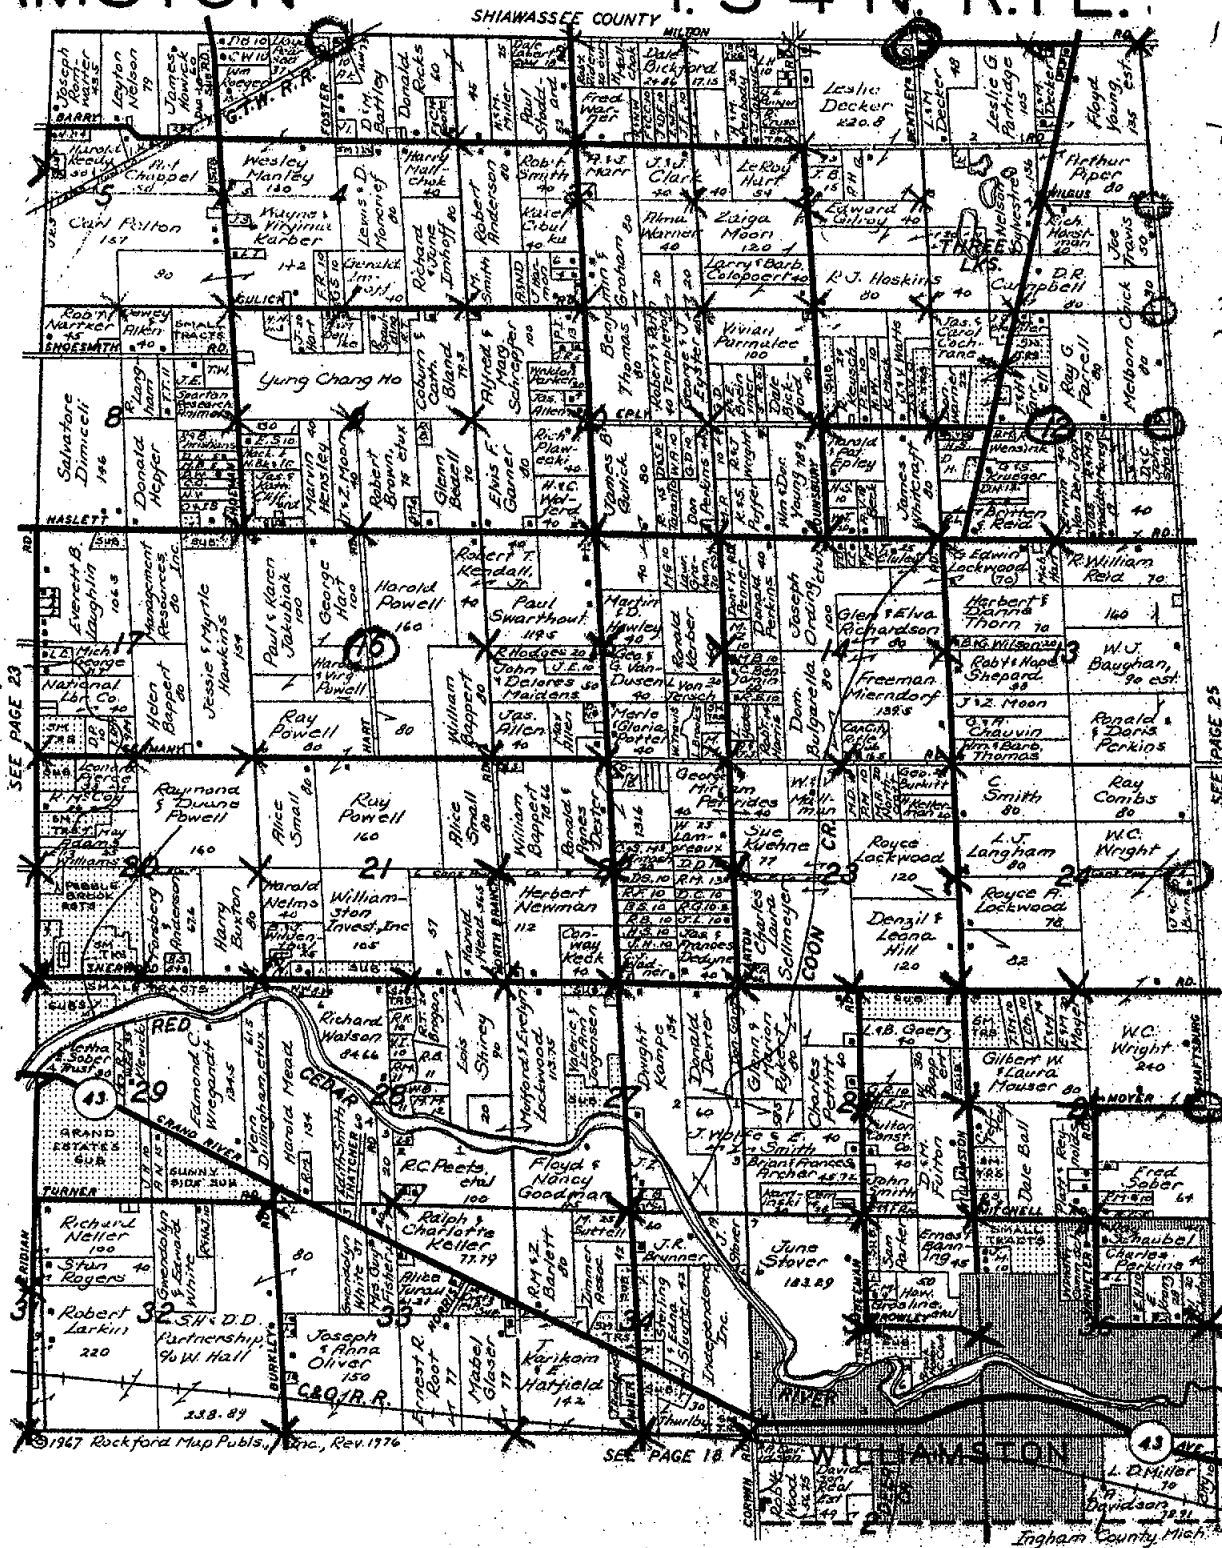

PRELIMINARY CORNER FIELD INSPECTION

Date 11/15/77

CORNER  
CODE K-1

Team L. BRYAN

TWP WILLIAMSTON

M. WHIPPLE

Corner: UNRECORDED

Road Name MILTON RD

Road Surface: CONCRETE ASPHALT GRAVEL OTHER: \_\_\_\_\_

FILL CUT Section

VISIBLE MONUMENT EVIDENCE: \_\_\_\_\_ Monument Box

\_\_\_\_\_ Pipe


\_\_\_\_\_ Iron Bar

\_\_\_\_\_ Nail

X Other: 1

\_\_\_\_\_ No Evidence Visible

MONUMENT LOCATION (Relative to centerline of road)

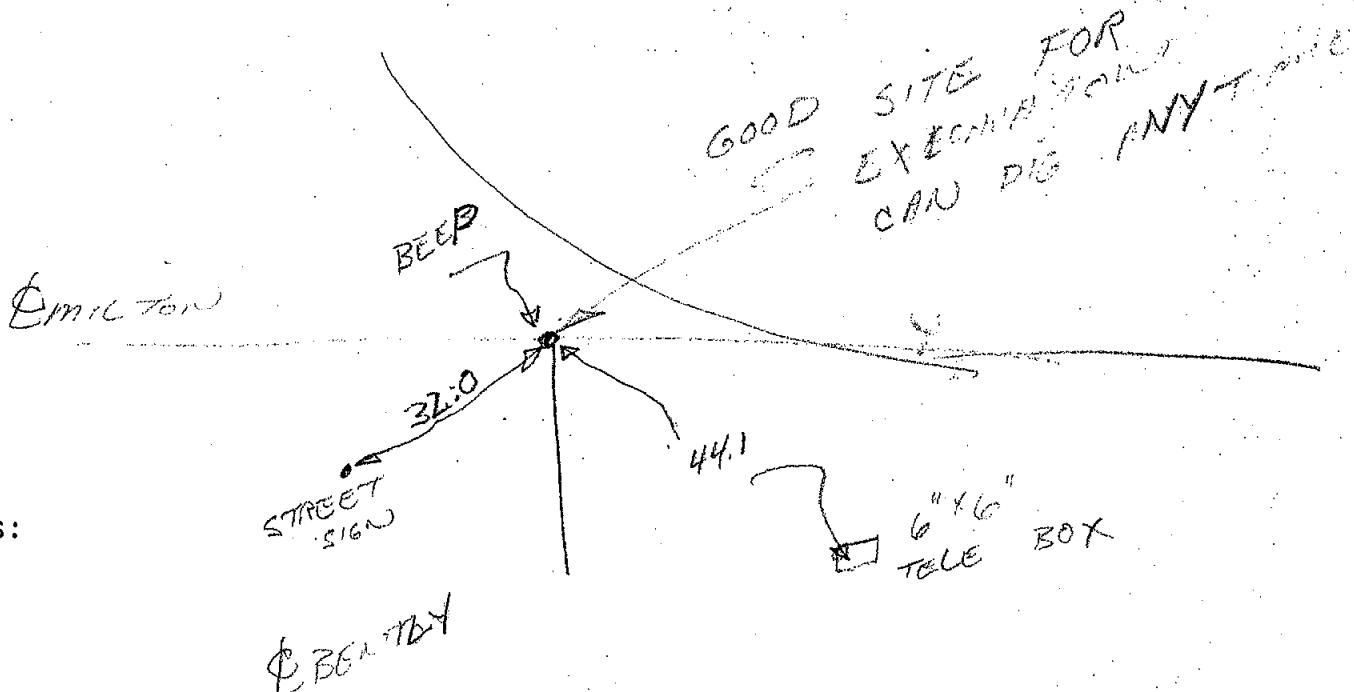

Remarks:

# TRAVERSE POINT WITNESS REPORT

Traverse Point No. 9054

Tech. Sup'r. L. BRYAN

Township Williamston

Company POLARIS




Recorded  
Corner  
Code           

Field Squad GENEVAUX #4


Date 3-23-78

Sketch and describe roads, monuments found or set, and witness established:

- 1) Set N & T N.W. side 24" Hickory  
S. 50° W. 44.95'
- 2) Set N & T N side 50" OAK  
S. 55° E. 52.16'
- 3) Top center buried cable box  
S. 35° E. 47.07'

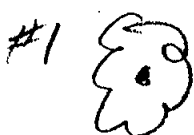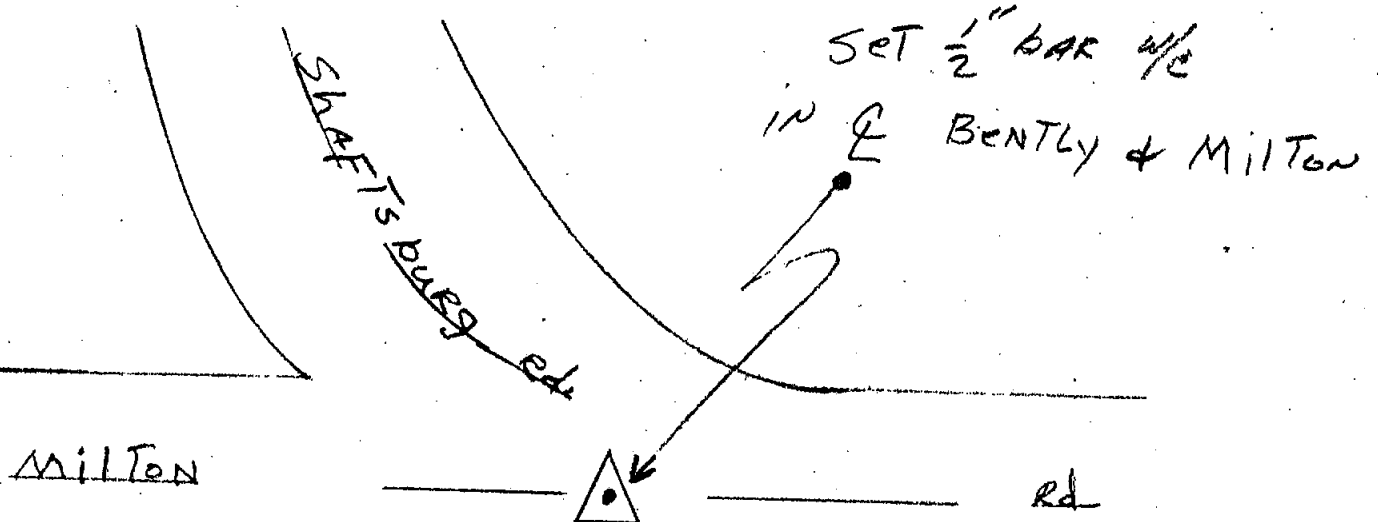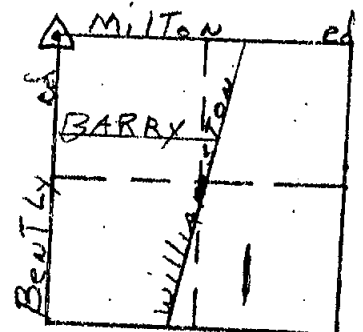

ed  
mily

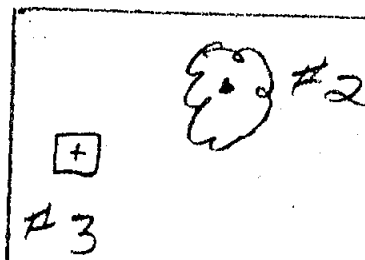

PRELIMINARY CORNER FIELD INSPECTION

Date \_\_\_\_\_

CORNER  
CODE \_\_\_\_\_

Team \_\_\_\_\_

TWP \_\_\_\_\_

Corner:             
UNRECORDED

Road Name \_\_\_\_\_

Road Surface: CONCRETE ASPHALT GRAVEL OTHER: \_\_\_\_\_

FILL CUT Section

VISIBLE MONUMENT EVIDENCE: \_\_\_\_\_ Monument Box  
\_\_\_\_\_ Pipe  
\_\_\_\_\_ Iron Bar  
\_\_\_\_\_ Nail  
\_\_\_\_\_ Other: \_\_\_\_\_  
\_\_\_\_\_ No Evidence Visible

MONUMENT LOCATION (Relative to centerline of road)

Remarks:

INGHAM COUNTY SURVEY and REMONUMENTATION PROJECT

Township WILLIAMSTON , T 4 N , R 1E

Corner Code K-2

# OFF ROAD

[illegible]



SOURCE: CORNER RECORDATION CERTIFICATE

TRANSCRIBED from ORIGINAL  
DUPLICATE on file at REGISTER OF DEEDS

**LAND CORNER RECORDATION CERTIFICATE**  
FILING REQUIREMENT OF ACT 74, MICH. P.A. 1970

FOR CORNERS OF: Sec. LOCATED IN: CORNER CODE NUMBER  
1. PUBLIC LAND SURVEY 2 T. 4 N. R. 1 E. K-2  
2. PROPERTY CONTROLLING IN SECTION T. N. S. R. E.  
3. MISCELLANEOUS PROPERTY IN SECTION T. N. S. R. E.  
4. LOT NO. RECORDED PLAT  
5. PRIVATE CLAIMS

LMR 1 R 155

FILED

AUG 26 8 20 AM '71

REGISTER OF DEEDS  
MRS. BILL HUMPHREY  
INGHAM COUNTY, MICH.

REGISTER OF DEEDS STAMP AND  
FILING NUMBER

I, Gary D. Lester do hereby certify that under requirements of P.A. 74, Michigan P.A. of 1970, the corner points mentioned in lines 1 and 2 above (identified with circles on index code diagram - over) were, in a field survey on July 8 1971, established, re-established, monumented, re-monumented, recovered or restored as expressed below and in conformance with regulations and rules therefore as required in the current manual of survey instructions of the United States Department of the Interior, Bureau of Land Management or by a decree of a court of law. Furthermore, that the corner points mentioned in lines 3, 4 and 5 above were, in a field survey on July 8 1971, found, recovered, restored, established or re-established as expressed below and in conformance with the rules of the Michigan State Board of Registration for Land Surveyors or, by a Decree of a Court of law:

A. Description of original monument and accessories and/or subsequent restoration:

Original monument and accessories obliterated.

B. Description of corner evidence found and/or method applied in restoring or re-establishing corner:

Found 1/2" pinch pipe at fence intersection corner location supported by field measurement West and old fence location.

C. Description of monument for corner and accessories established to perpetuate location of the corner:

1/2" pinch pipe.

E 1/4 Corner, Section 2, T4N, R1E  
Nail & Tag in 36" oak tree WSW, 7.58'  
Nail & Tag in 24" tamarack tree ENE, 7.30'  
Nail & Tag in 8" tamarack tree NW, 23.72'

SIGNED BY Gary D. Lester DATE 8/16/71  
SURVEYOR'S MICHIGAN REGISTRATION NO. 17624  
FOR STATE AND UNITED STATES AGENCIES

SIGNED BY \_\_\_\_\_ DATE \_\_\_\_\_  
APPROVED AND SIGNED BY \_\_\_\_\_ DATE \_\_\_\_\_

SURVEYOR'S MICHIGAN REGISTRATION NO. \_\_\_\_\_  
FORM NO. 10, 0728  
COPYRIGHT 1968, S. S. CALDWELL, MICH.

FORM APPROVED BY MICHIGAN STATE BOARD OF REGISTRATION, JAN. 28, 1971  
DISTRIBUTED BY MICHIGAN SOCIETY OF REGISTERED LAND SURVEYORS

# INGHAM COUNTY SURVEY and REMONUMENTATION PROJECT

Township WILLIAMSTON , T 4 N , R 1E

Corner Code K-3

## OFF ROAD

| Research Record:                                            | attachment<br>number(s) | no. of<br>sheets | researched<br>by | reviewed<br>by |
|-------------------------------------------------------------|-------------------------|------------------|------------------|----------------|
| Corner Recordation Certificate<br>Liber 1 Page 157          | 1                       | 1                | K.L.             | DKH            |
| Recorded Land Survey<br>Liber Page                          |                         |                  |                  |                |
| Recorded Subdivision Plat<br>Liber Page                     |                         |                  |                  |                |
| MDSHT Right-of-Way Maps<br>Sheet No.                        |                         |                  |                  |                |
| Ingham County Road Comm. Maps<br>Sheet No.                  |                         |                  |                  |                |
| Record of the Ingham County<br>Surveyor Vol. Page Year      |                         |                  |                  |                |
| General Land Office Maps<br>Sheet No.                       |                         |                  |                  |                |
| Form 280, Gov't. Monument<br>Witness Record                 |                         |                  |                  |                |
| Ingham County Drain Comm.<br>File No.                       |                         |                  |                  |                |
| East Lansing City Engineer                                  |                         |                  |                  |                |
| Lansing Public Service Office<br>Cade's 1921 Survey p.      |                         |                  |                  |                |
| Lansing Public Service Office<br>J.B. Davis' Field Notes p. |                         |                  |                  |                |
| G.L.O. Field Notes                                          |                         |                  |                  |                |
| Misc. I.C. S. Notes                                         |                         |                  |                  |                |
| Field Recon. Form                                           | N.D.                    |                  | K.L.             | DKH            |
| RESEARCH COMPLETED date                                     | Total                   | Total            |                  |                |
| Consumers Power Company<br>Sheet No. Index No.              |                         |                  |                  |                |
| Chesapeake & Ohio Railroad Co.<br>Val. Sec. Drawer Sheet    |                         |                  |                  |                |
| RESEARCH COMPLETED date                                     | Total                   | Total            |                  |                |
| REMARKS                                                     |                         |                  |                  |                |
|                                                             |                         |                  |                  |                |
|                                                             |                         |                  |                  |                |
SOURCE: CORNER RECORDATION CERTIFICATE

TRANSCRIBED from ORIGINAL on file at REGISTER OF DEEDS

### LAND CORNER RECORDATION CERTIFICATE

FILING REQUIREMENT OF ACT 74, MICH. P.A. 1970

LIBER 18 157  
FILED

| FOR CORNERS OF --                    | Sec. | LOCATED IN --    | CORNER CODE NUMBER |
|--------------------------------------|------|------------------|--------------------|
| 1. PUBLIC LAND SURVEY                | 2    | T 4 N, R 1 E     | K-3                |
| 2. PROPERTY CONTROLLING IN SECTION   |      |                  |                    |
| 3. MISCELLANEOUS PROPERTY IN SECTION |      |                  |                    |
| 4. LOT NO. --                        |      | RECORDED PLAT -- |                    |
| 5. PRIVATE CLAIMS                    |      |                  |                    |

SEP 10 2 51 PM '71  
REGISTER OF DEEDS  
Miss Bill Humphrey  
INGHAM COUNTY, MICH.

REGISTER OF DEEDS STAMP AND  
FILING NUMBER

I, Gary D. Lester, do hereby certify that under requirements of P.A. 74, Michigan P.A. of 1970, the corner points mentioned in lines 1 and 2 above (identified with circles on index code diagram - over) were, in a field survey on August 13, 1971, established, re-established, monumented, re-monumented, recovered or restored as expressed below and in conformance with regulations and rules therefore as required in the current manual of survey instructions of the United States Department of the Interior, Bureau of Land Management or by a decree of a court of law. Furthermore, that the corner points mentioned in lines 3, 4 and 5 above were, in a field survey on August 13, 1971, found recovered, restored, established or re-established as expressed below and in conformance with the rules of the Michigan State Board of Registration for Land Surveyors or, by a Decree of a Court of law:

A. Description of original monument and accessories and of subsequent restoration:

Original monument and accessories obliterated.

B. Description of corner evidence found and of method applied in restoring or re-establishing corner:

Found 1" pipe at fence intersection.  
Fences East, West and South.

C. Description of monument for corner and accessories established to perpetuate locating the position of the corner:

1" pipe

Nail & Tag South side 24" maple tree E, 12.96'  
Nail & Tag North side 30" ash tree WSW, 19.90'  
P.K. Nail West side 24" tamarack South, 3.23'

SIGNED BY

*Gary D. Lester*

DATE Sept. 1, 1971

SURVEYOR'S MICHIGAN REGISTRATION NO. 17624

(SEAL)

FOR STATE AND UNITED STATES AGENCIES:

SIGNED BY

CHIEF OF SURVEY PARTY

DATE

APPROVED AND SIGNED BY

MICHIGAN REGISTERED LAND SURVEYOR

DATE

(SEAL)

SURVEYOR'S MICHIGAN REGISTRATION NO.

Form No. 60, 1970  
Revised 1970

FORM APPROVED BY MICHIGAN STATE BOARD OF REGISTRATION, JAN. 28, 1971  
DISTRIBUTED BY MICHIGAN SOCIETY OF REGISTERED LAND SURVEYORS

INGHAM COUNTY SURVEY and REMONUMENTATION PROJECT

Township WILLIAMSTON , T 4 N , R 1E

Corner Code 4-1

## PAVED

[illegible]

SOURCE: CORNER RECORDATION CERTIFICATE

TRANSCRIBED from ORIGINAL  
~~DUPLICATE~~ on file at REGISTER OF DEEDS

*Williamston*

**LAND CORNER RECORDATION CERTIFICATE**  
FILING REQUIREMENT OF ACT 74, MICH. P.A. 1970  
LIBER 3 R 537

| FOR CORNERS OF:-                     | LOCATED IN:-            | CORNER CODE NUMBER |
|--------------------------------------|-------------------------|--------------------|
| 1. PUBLIC LAND SURVEY                | Sec. 1 T. 4N. S. 1E. E. | M-1 L-1            |
| 2. PROPERTY CONTROLLING IN SECTION   | T. S. R. E.             |                    |
| 3. MISCELLANEOUS PROPERTY IN SECTION | T. S. R. E.             |                    |
| 4. LOT NO.                           | RECORDED PLAT           |                    |
| 5. PRIVATE CLAIMS                    |                         |                    |

FILED  
Feb 4 4 01 PM '78  
REGISTER OF DEEDS  
Ingham County, Mich.

REGISTER OF DEEDS STAMP AND FILING NUMBER

1. Marvin F. Fouty do hereby certify that under requirements of P.A. 74, Michigan P.A. of 1970, the corner points mentioned in lines 1 and 2 above were, in a field survey on 9-30-75, 19   established, re-established, monumented, re-monumented, recovered or restored as expressed below and in conformance with regulations and rules therefore as required in the current manual of survey instructions of the United States Department of the Interior, Bureau of Land Management or by a decree of a court of law. Furthermore, that the corner points mentioned in lines 3, 4 and 5 above were, in a field survey on   , 19   found, recovered, restored, established or re-established as expressed below and in conformance with the rules of the Michigan State Board of Registration for Land Surveyors or, by a Decree of a Court of law:

A. Description of original monument and accessories and or subsequent restoration:  
M-1 Original monument and accessories obliterated. In a survey dated Feb. 28, 1849 County Surveyor Louis D. Preston called for the original corner in his survey of the Section. No subsequent call or description of the corner could be found in Ingham or Shiawassee County Records.

L-1 Corner not set in original government survey. This corner was apparently established by County Surveyor Preston the the survey mentioned above.

B. Description of corner evidence found and or method applied in restoring or re-establishing corner:  
M-1 Found old 1" pipe buried 1 foot at north edge of gravel road on old fence line south. Records of eight area Registered Land Surveyors disclosed no conflicting evidence of the corner location. Replaced 1" pipe with 1/2" bar and cap.  
L-1 Set 1/2" bar on Township line on fence line to south. Closing distance to adjacent 81/4 corner of Section 36, T5N, R1E in accord with original government survey.

C. Description of monument for corner and accessories established to perpetuate locating the position of the corner:  
M-1 NE Corner Section 1, T4N, R1E  
1/2" bar and cap  
Tag and Nail east side 8" anchor post North 10.15'  
Tag and Nail south side 16" twin Maple East 86.00'  
Tag and Nail east side 1" elm south 33.30'  
L-1 N 1/4 Corner Section 1, T4N, R1E 1/2" bar  
Tag and Nail south side 6" elm NW 49.10'  
Tag and Nail North side 14" walnut SSE 45.00'  
1/2" bar N88°39'30"W 73.92' (S 1/4 Corner Section 36, T5N, R1E)

SIGNED BY: Marvin Fouty DATE: January 26, 1976  
SURVEYOR'S MICHIGAN REGISTRATION NO. 10909  
FOR STATE AND UNITED STATES AGENCIES:  
SIGNED BY: \_\_\_\_\_ DATE: \_\_\_\_\_  
APPROVED AND SIGNED BY: \_\_\_\_\_ DATE: \_\_\_\_\_

SURVEYOR'S MICHIGAN REGISTRATION NO. \_\_\_\_\_  
MAY PLACE SECTION ON BACK ON ATTACHED SHEET

931

Traverse Point No. 9099

Township W.L. Livingston

Recorded

## Corner

Code

Date \_\_\_\_\_

1) - 1.5" bar N. 88° W. 73.92'

2) Ed Nut 14" Walnut N. side

5.50 45.00


3) Fl. Nat. 5 m. 6" Twin E/119

N.W. 49.10'

ALS<sup>27</sup>

18989

F. Forty

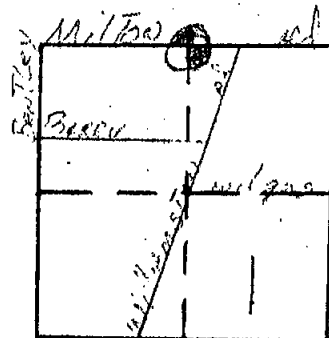

43  
30

1-  $\frac{1}{2}$ " bar

6.05' N. of P.

Milton #1



α 8-31-78  
Munch

INGHAM COUNTY SURVEY and REMONUMENTATION PROJECT

Township WILLIAMSTON, T 4 N, R 1E  
 Corner Code

Corner Code L-2

PAVED

[illegible]

SOURCE: CORNER RECORDATION CERTIFICATE

TRANSCRIBED from ORIGINAL  
DUPLICATE on file at REGISTER OF DEEDS

### LAND CORNER RECORDATION CERTIFICATE

FILING REQUIREMENT OF ACT 74, MICH. P.A. 1970

LIBER 26 373

FOR CORNERS OF: LOCATED IN: CORNER CODE NUMBER

1. PUBLIC LAND SURVEY L-2

FILED

2. PROPERTY CONTROL  
NO IN SECTION

MAR 28 10 11 AM '73

3. MISCELLANEOUS  
PROPERTY IN SECTION

REGISTER OF DEEDS  
*Paul M. Lewis*  
INGHAM COUNTY MICH

4. LOT NO. RECORDED PLAT

REGISTER OF DEEDS STAMP AND  
FILING NUMBER

5. PRIVATE CLAIMS

I, Richard W. Stedman do hereby certify that under requirements of P.A. 74, Michigan P.A. of 1970, the corner points mentioned in lines 1 and 2 above (identified with circles on index code diagram - over) were, in a field survey on MARCH 13, 1973, established, re-established, monumented, re-monumented, recovered, or restored as expressed below and in conformance with regulations and rules therefore as required in the current manual of survey instructions of the United States Department of the Interior, Bureau of Land Management or by a decree of a court of law. Furthermore, that the corner points mentioned in lines 3 and 4 above were, in a field survey on MARCH 13, 1973, found, recovered, restored, established or re-established as expressed below and in conformance with the rules of the Michigan State Board of Registration for Land Surveyors or by a Decree of a Court of law:

A. Description of original monument and accessories and of subsequent restoration:

Not set as part of the Public Land Survey.

From Ingham County Surveyor's Records in Register of Deeds Office:

In 1849, in Survey #542, the first survey on record in this section, Surveyor Louis Preston refers to the center of Section 1, which he probably established, as being witnessed by a 32" Yellow Oak bearing South - 5 lks.; in 1856, Surveyor Anson Jackson used this corner in Survey #918, Vol. 2, Page 271, giving a 24" E. Oak bearing N21°0'W 27-3/4 lks. and a 16" W. Oak bearing S78-3/4°W 85-2/3 lks. as witnesses, but no monument description. (For Survey #542, see V. 2-P.82)

B. Description of corner evidence found and of method applied in restoring or re-establishing corner:

This corner is now occupied by a 3" dia. steel anchor post about 10 ft. North of the center of Wilgus Rd. and on the West side of Williamston Rd.

C. Description of monument for corner and accessories established to perpetuate locating the position of the corner:

3" dia. steel anchor post.

Witnesses: Nail and tag in power pole - N.W.E. 76.75 ft.  
Nail and tag in power pole - E.N.E. 94.52 ft.  
Nail and tag in guy pole - E.S.E. 81.48 ft.

76.75  
94.52  
81.45

SIGNED BY Richard W. Stedman DATE March 22, 1973

SURVEYOR'S MICHIGAN REGISTRATION NO. 11379

FOR STATE AND UNITED STATES AGENCIES:

SIGNED BY \_\_\_\_\_ DATE \_\_\_\_\_

APPROVED AND SIGNED BY \_\_\_\_\_ DATE \_\_\_\_\_

SURVEYOR'S MICHIGAN REGISTRATION NO.

510

Form No. 611-720  
DOUGLASS BROS. & CO., ANN ARBOR, MICH.

FORM APPROVED BY MICHIGAN STATE BOARD OF REGISTRATION, JAN. 28, 1971  
DISTRIBUTED BY MICHIGAN SOCIETY OF REGISTERED LAND SURVEYORS





# TRAVERSE POINT WITNESS REPORT

Traverse Point No. 9047

Tech. Sup'r. L. BRYAN

Company POLARIS

Field Squad B. MARTIN #4


Township Williamston

Recorded Corner Code L-2

Date 3-28-78

Sketch and describe roads, monuments found or set, and witness established:

- 1) Fl. N & T on S side of P. Pole  
NNE 94.62'
- 2) Fl. N & T on N side of Guy Pole  
ESE 81.45'
- 3) Fl. N & T on W side of P. Pole  
NNE 26.85'

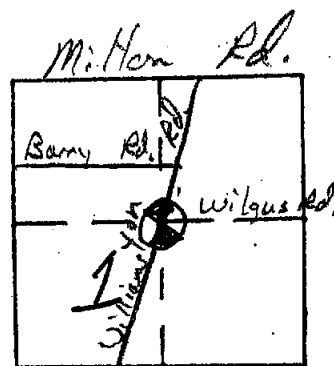

VOID  
USE AS  
REFERENCE  
ONLY

Fl. 3" dia steel anchor  
post used as section corner  
approx. 10.00' N. of Wilgus

E & W. of  
Williamston Rd.



Wilgus

Rd.

o #2

WILLIAMSTON

INGHAM COUNTY SURVEY and REMONUMENTATION PROJECT

Township WILLIAMSTON , T 4 N , R 1E  
 Corner Code

Corner Code L-3

# OFF ROAD

| <b>Research Record:</b>                                                         | <b>attachment<br/>number(s)</b> | <b>no. of<br/>sheets</b> | <b>researched<br/>by</b> | <b>reviewed<br/>by</b> |
|---------------------------------------------------------------------------------|---------------------------------|--------------------------|--------------------------|------------------------|
| <b>Corner Recordination Certificate</b><br><b>Liber 2 Page 375</b>              | 1                               | 1                        | K.L.                     | DKH                    |
| <b>Recorded Land Survey</b><br><b>Liber                  Page</b>               |                                 |                          |                          |                        |
| <b>Recorded Subdivision Plat</b><br><b>Liber                  Page</b>          |                                 |                          |                          |                        |
| <b>MDSHT Right-of-Way Maps</b><br><b>Sheet No.</b>                              |                                 |                          |                          |                        |
| <b>Ingham County Road Comm. Maps</b><br><b>Sheet No.</b>                        |                                 |                          |                          |                        |
| <b>Record of the Ingham County</b><br><b>Surveyor Vol.      Page      Year</b>  |                                 |                          |                          |                        |
| <b>General Land Office Maps</b><br><b>Sheet No.</b>                             |                                 |                          |                          |                        |
| <b>Form 280, Gov't. Monument</b><br><b>Witness Record</b>                       |                                 |                          |                          |                        |
| <b>Ingham County Drain Comm.</b><br><b>File No.</b>                             |                                 |                          |                          |                        |
| <b>East Lansing City Engineer</b>                                               |                                 |                          |                          |                        |
| <b>Lansing Public Service Office</b><br><b>Cade's 1921 Survey p.</b>            |                                 |                          |                          |                        |
| <b>Lansing Public Service Office</b><br><b>J.B. Davis' Field Notes p.</b>       |                                 |                          |                          |                        |
| <b>G.L.O. Field Notes</b>                                                       |                                 |                          |                          |                        |
| <b>Misc. I.C. S. Notes</b>                                                      |                                 |                          |                          |                        |
| <b>Field Recon. Form</b>                                                        | N.D.                            |                          | K.L.                     | DKH                    |
| <b>RESEARCH COMPLETED</b><br><div style="text-align: right;">date</div>         | Total                           | Total                    |                          |                        |
| <b>Consumers Power Company</b><br><b>Sheet No.      Index No.</b>               |                                 |                          |                          |                        |
| <b>Chesepeak &amp; Ohio Railroad Co.</b><br><b>Val.    Sec.    Drawer Sheet</b> |                                 |                          |                          |                        |
| <b>RESEARCH COMPLETED</b><br><div style="text-align: right;">date</div>         | Total                           | Total                    |                          |                        |
| <b>REMARKS</b>                                                                  |                                 |                          |                          |                        |
|                                                                                 |                                 |                          |                          |                        |
SOURCE: CORNER RECORDATION CERTIFICATE

TRANSCRIBED from ORIGINAL  
~~DUPLICATE~~ on file at REGISTER OF DEEDS

LAND CORNER RECORDATION CERTIFICATE  
FILING REQUIREMENT OF ACT 74, MICH. P.A. 1970

FOR CORNERS OF: LOCATED IN: CORNER CODE NUMBER

1. PUBLIC LAND SURVEY 4 R 1 L-3

2. PROPERTY CONTROL-  
ING IN SECTION 1 S. R. 1

3. MISCELLANEOUS  
PROPERTY IN SECTION 1 S. R. 1

4. LOT NO. RECORDED PLAT

5. PRIVATE CLAIMS

LIBER 21 375

FILED

MAR 28 10 11 AM '73

REGISTER OF DEEDS

Paul M. Lewis  
LEGISLATIVE COUNCIL

REGISTER OF DEEDS STAMP AND  
FILING NUMBER

1. Richard W. Steadman do hereby certify that under requirements of P.A. 74, Michigan P.A. of 1970 the corner points mentioned in lines 1 and 2 above identified with circles on index code diagram - over were, in a field survey on March 13, 1973, established, re-established, monumented, re-monumented, recovered or restored as expressed below and in conformance with regulations and rules thereto as required in the current manual of survey instructions of the United States Department of the Interior, Bureau of Land Management or by a decree of a court of law. Furthermore, that the corner points mentioned in lines 3, 4 and 5 above were, in a field survey on March 13, 1973, found, recovered, restored, established or re-established as expressed below and in conformance with the rules of the Michigan State Board of Registration for Land Surveyors or by a Decree of a Court of law:

A. Description of original monument and accessories and/or subsequent restoration:  
Original monument: Wood post set in 1826 by Joseph Weapler, D.S.  
Bearing Trees: 18" W. Oak N12°W - 46 lks.; 13" W. Oak N50°W 36 lks.  
From Ingham County Surveyor's Records in Register of Deeds Office:  
In 1846, Surveyor Louis Preston used this corner in Survey #542, Vol. 2, Page 82, but gave no monument description or witnesses; in 1856, Surveyor Anson Jackson used this corner in Survey #328, Vol. 2, Page 274, giving a 4" Hickory bearing N24°W 24 lks. and a 12" W. Oak bearing S55-2/3°W 102 lks. as witnesses, but no monument description; (continued below)

B. Description of corner evidence found and/or method applied in restoring or re-establishing corner.  
In 1883, Surveyor John McCreary in Survey #1800, Vol. 3, Page 203, notes the corner to be a stone which residents said was set by Surveyor Jackson, and witnessed by a 12" Hickory-S46°W 25 lks. and a 8" Hickory-S47°E 33 lks.

The corner is now occupied by a wood anchor post. Dug at base of post, but found no stone as mentioned above.

C. Description of monument for corner and accessories established to perpetuate locating the position of the corner:  
Set 3/4" iron pipe and cap at base of post.

Witnesses: Nail and tag in 14" Wild Cherry - West 26.23 ft.  
Nail and tag in 28" Oak - South 4.40 ft.  
Nail and tag in triple 8" Hickory - East 2.78 ft.

SIGNED BY: Richard W. Steadman DATE: March 22, 1973

SURVEYOR'S MICHIGAN REGISTRATION NO. 11370

FOR STATE AND UNITED STATES AGENCIES:

SIGNED BY: \_\_\_\_\_ DATE: \_\_\_\_\_

APPROVED AND SIGNED BY: \_\_\_\_\_ DATE: \_\_\_\_\_

SURVEYOR'S MICHIGAN REGISTRATION NO. 511

Form No. 511-77B  
Copyright © 1970 by S. S. K. & Co., East Lansing, Mich.

FORM APPROVED BY MICHIGAN STATE BOARD OF REGISTRATION, JAN. 28, 1971  
DISTRIBUTED BY MICHIGAN SOCIETY OF REGISTERED LAND SURVEYORS

# INGHAM COUNTY SURVEY and REMONUMENTATION PROJECT

Township WILLIAMSTON, T 4 N, R 1E

Corner Code M-2

| Research Record:                                                                 | attachment<br>number(s) | no. of<br>sheets | researched<br>by | reviewed<br>by |
|----------------------------------------------------------------------------------|-------------------------|------------------|------------------|----------------|
| Corner Recordation Certificate<br>Liber 5 Page 257                               | 0                       | 1                | Monke            | Jeb            |
| Recorded Land Survey<br>Liber 3 Page 1227-28                                     | N.D.                    |                  |                  | Jeb            |
| Recorded Subdivision Plat<br>Liber Page                                          | N.D.                    |                  |                  | Jeb            |
| MDSHT Right-of-Way Maps<br>Sheet No.                                             | N.D.                    |                  |                  | Jeb            |
| Ingham County Road Comm. Maps<br>Sheet No.                                       | N.D.                    |                  |                  | Jeb            |
| Record of the Ingham County<br>Surveyor Vol. 2 Page 82 Year 1849                 | 1                       | 1                |                  | Jeb            |
| 2 271 1856                                                                       | 2                       | 1                |                  | Jeb            |
| General Land Office Maps<br>Sheet No. 16                                         | 3                       | 1                |                  | Jeb            |
| Form 280, Gov't. Monument<br>Witness Record                                      | N.D.                    |                  |                  | Jeb            |
| Ingham County Drain Comm.<br>File No. 401 WILLIAMSTON, LOCKE,<br>AND PERRY DRAIN | 4                       | 1                |                  | Jeb            |
| East Lansing City Engineer                                                       | N.D.                    |                  |                  | Jeb            |
| Lansing Public Service Office<br>Cade's 1921 Survey p.                           | N.D.                    |                  |                  | Jeb            |
| Lansing Public Service Office<br>J.B. Davis' Field Notes p.                      | N.D.                    |                  |                  | Jeb            |
| G.L.O. Field Notes p. 12                                                         | 5                       | 1                |                  | Jeb            |
| Misc. I.C. S. Notes                                                              | N.D.                    |                  |                  | Jeb            |
| Field Recon. Form                                                                | N.D.                    |                  | ✓                | Jeb            |
|                                                                                  |                         |                  |                  | Jeb            |
| RESEARCH COMPLETED                                                               | Total                   | Total            |                  |                |
| date                                                                             |                         |                  |                  |                |
| Consumers Power Company<br>Sheet No. Index No.                                   | N.D.                    |                  | Monke            | Jeb            |
| Chesapeake & Ohio Railroad Co.<br>Val. Sec. Drawer Sheet                         | N.D.                    |                  | "                | Jeb            |
|                                                                                  |                         |                  |                  | Jeb            |
|                                                                                  |                         |                  |                  |                |
| RESEARCH COMPLETED                                                               | Total                   | Total            |                  |                |
| date                                                                             |                         |                  |                  |                |
| REMARKS                                                                          |                         |                  |                  |                |
| NOTHSTINE NOTES                                                                  | N.D.                    |                  | Monke            | Jeb            |
| FOLDER SET #1 p. 3, 5                                                            | 6/7                     | 1/1              | "                | Jeb            |
| p. 4, 6                                                                          | N.D.                    |                  | "                | Jeb            |
| FOLDER SET #2 p. 1, 2                                                            | N.D.                    |                  | "                | Jeb            |
|                                                                                  |                         |                  |                  |                |

INGHAM COUNTY-WILLIAMSTON TWP.  
**LAND CORNER RECORDATION CERTIFICATE**  
FILING REQUIREMENT OF ACT 74, MICH. P.A.1970

| FOR CORNERS OF--                                       | LOCATED IN--                                                        | CORNER CODE NUMBER |
|--------------------------------------------------------|---------------------------------------------------------------------|--------------------|
| 1. PUBLIC LAND SURVEY                                  | T. <u>4</u> N. <u>3</u> R. <u>1</u> E. <u>X</u>                     | <u>M-2</u>         |
| 2. PROPERTY CONTROLLING IN SECTION                     | T. <u>      </u> N. <u>      </u> R. <u>      </u> E. <u>      </u> | <u>      </u>      |
| 3. MISCELLANEOUS PROPERTY IN SECTION                   | T. <u>      </u> N. <u>      </u> R. <u>      </u> E. <u>      </u> | <u>      </u>      |
| 4. LOT NO. <u>      </u> , RECORDED PLAT <u>      </u> |                                                                     |                    |
| 5. PRIVATE CLAIMS <u>      </u>                        |                                                                     |                    |

REGISTER OF DEEDS STAMP AND  
FILING NUMBER

I, Ronnie M. Lester, do hereby certify that under requirements of P.A. 74, Michigan P.A. of 1970, the corner points mentioned in lines 1 and 2 above were, in a field survey on May 17, 1979, established, re-established, monumented, re-monumented, recovered or restored as expressed below and in conformance with regulations and rules therefore as required in the current manual of survey instructions of the United States Department of the Interior, Bureau of Land Management or by a decree of a court of law. Furthermore, that the corner points mentioned in lines 3, 4 and 5 above were, in a field survey on       , 19      , found, recovered, restored, established or re-established as expressed below and in conformance with the rules of the Michigan State Board of Registration for Land Surveyors or, by a Decree of a Court of law:

A. Description of original monument and accessories and/or subsequent restoration:

M-2

Post set in original government survey by J. Wampler dated between March 3 and 13, 1826.

Corner referred to in a survey by L.D. Preston, County Surveyor, Feb. 24, 1849 (v.2, p.82).

Corner referred to in a survey by A. Jackson, County Surveyor, Feb. 21, 1856 (v.2, p.271).

B. Description of corner evidence found and/or method applied in restoring or re-establishing corner:

M-2

Excavated a hole 6' x 14' to an average depth of 3.0', south of the intersection of Wilgus Road and Shaftsbury Road and on fence line to the north. Found pile of rocks 2.5' x 1.0' with pointed rock on top 5" below road surface, + 3.0' east of fence line to the north, + 3.0' east of the centerline of Shaftsbury Road and + 12.0' south of the centerline of Wilgus Road. Accepted pointed rock for corner.  
Excavation conducted by Ingham County Survey and Remonumentation Project crew.

C. Description of monument for corner and accessories established to perpetuate locating the position of the corner:

M-2

Ex Corner, Section 1, T4N-R1E

Set 4" x 36" concrete monument with  $\frac{1}{2}$ " x 38" rerod and cap #18998 in location of pointed rock described above:

Nail & tag, #18998, west side 32" Maple, ESE, 22.33'

Nail & tag, #18998, west side 32" Maple, SE, 43.87'

Nail & tag, #18998, south side 12" Oak, NE, 131.48'

Nail & tag, #18998, east side 34" Oak, NW, 45.80'

SIGNED BY Ronnie M. Lester DATE 7/6/79

SURVEYOR'S MICHIGAN REGISTRATION NO. 18998


SIGNED BY [Signature] DATE 7-11-79

APPROVED AND SIGNED BY        DATE       


MICHIGAN REGISTERED LAND SURVEYOR

Director, Ingham County Survey and  
Remonumentation Project

SURVEYOR'S MICHIGAN REGISTRATION NO. 17624

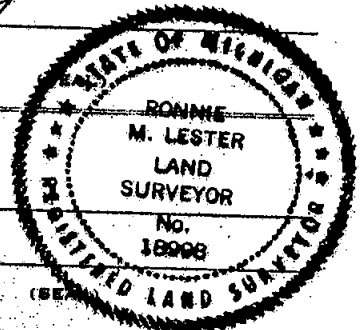

SOURCE: GLO MAP #16  
 TRANSCRIBED from ~~ORIGINAL~~ DUPLICATE on file at Remon. OFFICE

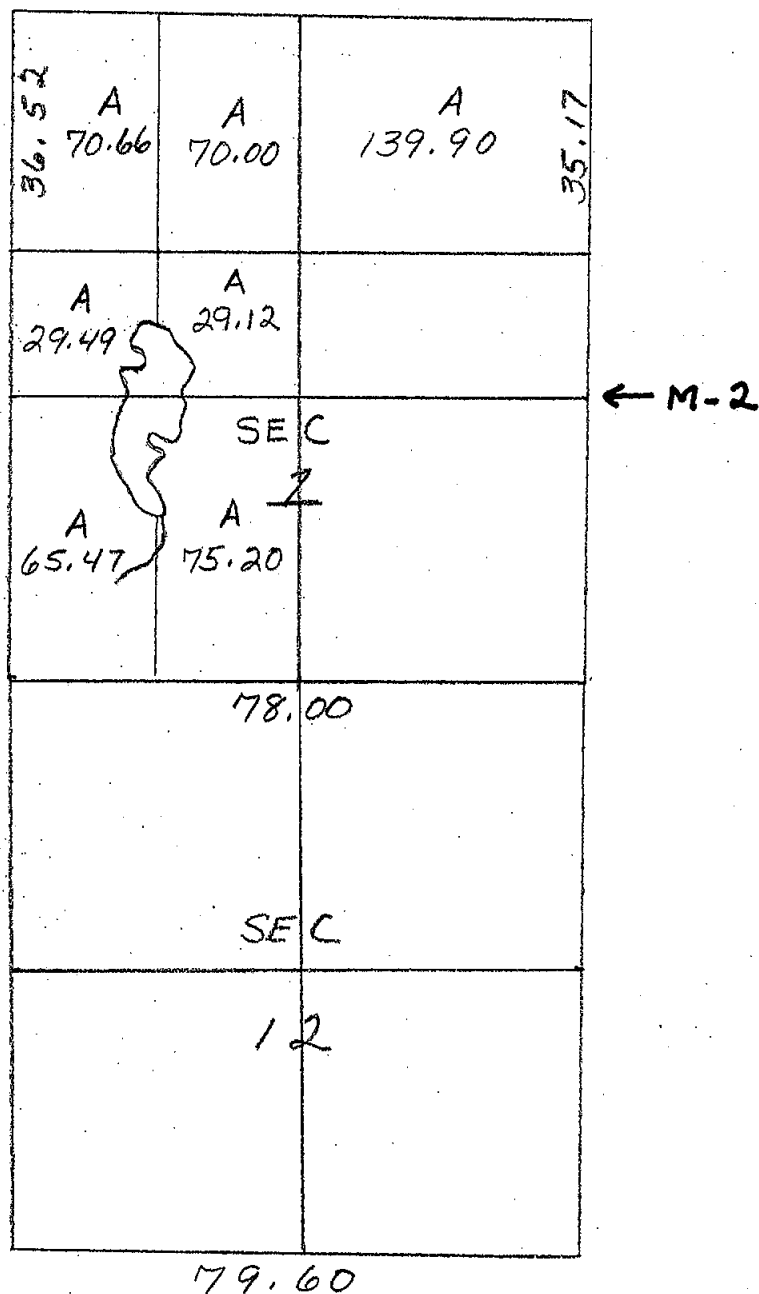

M-2 = 55.17 chs. from M-1 (No written distance)  
 M-2 = 40.00 chs from M-3 (No written distance)

SOURCE: ING. Co. DRAIN Comm. #401 WILLIAMSTON, LOCKE & PERRY DRAIN  
TRANSCRIBED from ORIGINAL on file at Remon. OFFICE  
DUPLICATE

WILLIAMSTON LOCKE & PERRY DRAIN #401

Town 4 North Range 2 East (Locke township, Ingham County), Frank Hart, owner, S 15° 40' E 8.96 chs to the point of a curve; thence curve to the right on a 19° curve 4.64 chs to the point of tangent; thence S 22° 30' W 8.91 chs; thence S 27° W 12.62 chs; thence S 54° W 5.87 chs to the south line of said lands at a point 15.50 chs east of the south-west corner thereof. Total length of drain on said lands is 41.03 chs.

Thence on the west thirty-one (31) acres of the south part of the North-west fractional one-fourth (1/4) of said section six (6), Mary L. Hammond, owner, S 54° W 17.54 chs to the west line of said lands at a point in the west line of said section six (6), 9.85 chs north of the west one-fourth (1/4) post thereof.

Thence on the south one-half (1/2) of the North-east fractional one-fourth (1/4) of Section one (1) Town 4 North Range 1 East (Williamston township, Ingham County) S 54° W 8.76 chs to the point of a curve; thence curve left on a 40° curve 2.56 chs to the point of tangent; thence S 5° 30' E 2.55 chs to the south line of said lands at a point 8.68 chs west of the east one-fourth (1/4) post of said Section one (1). Total length of drain on said lands is 13.87 chs. *W. D. Sten*

Thence on the North 50 acres of the East one-half (1/2) of the South-east one-fourth (1/4) of Section one (1), Almira Wilgus, owner, S 6° 45' E 7.90 chs; Thence S 4° 30' E 4.71 chs; thence S 2° 15' W 3.48 chs; thence S 11° 45' W 9.90 chs to the upper end of said drain in the south line of said lands at a point 11.32 chs west of the south-east corner thereof. Total length of drain on said lands is 25.99 chs.

The total length of said drain is 2 miles and ninety and eight-tenths (90 8/10) rods.

SPECIFICATIONS.

1.- Station stakes and grade hubs are set every eight (8) rods and numbered consecutively from 0 at the lower end of said drain to station 91 plus 70 lks at the upper end.

2.- The slopes of each bank from station 0 to station 79 shall

SOURCE: G.L.O. FIELD NOTES p. 12  
TRANSCRIBED from ORIGINAL on file at Remon. OFFICE  
DUPLICATE

11. <sup>12</sup> T. 4 N. R. 1 E.  
North on the E. Bound! Sec. 4  
41.87 W. Oak 9 in diam.  
42.25 Elm 12 in diam.  
40.00 Set 3/4 Sec post 1 in  
W. 13 in N 53 W 39 1/2  
Cherry 4 in. S 75 W 35.  
42.17 Hick. 11 in diam.  
44.30 Cedar Swamp  
61.00 Lave "  
80.00 Set temp post \*  
87.50 Cedar Swamp  
Description of Land omitted  
\* From Post at corner of corner a  
Long 10 in. bears S. 75 E. 21 1/2  
Do 12 in. " N. 30 W 27 1/2



INGHAM COUNTY-WILLIAMSTON TWP.  
LAND CORNER RECORDATION CERTIFICATE  
FILING REQUIREMENT OF ACT 74, MICH. P.A.1970

| FOR CORNERS OF--                          | LOCATED IN--                                          | CORNER CODE NUMBER |
|-------------------------------------------|-------------------------------------------------------|--------------------|
| 1. PUBLIC LAND SURVEY_____                | T. <u>4</u> N. <u>X</u> , R. <u>1</u> E. <u>X</u>     | <u>M-2</u>         |
| 2. PROPERTY CONTROLLING IN SECTION_____   | T. _____ N. _____ S. _____ R. _____ E. _____ W. _____ | _____              |
| 3. MISCELLANEOUS PROPERTY IN SECTION_____ | T. _____ N. _____ S. _____ R. _____ E. _____ W. _____ | _____              |
| 4. LOT NO. _____, RECORDED PLAT _____     |                                                       |                    |
| 5. PRIVATE CLAIMS _____                   |                                                       |                    |

REGISTER OF DEEDS STAMP AND  
FILING NUMBER

I, Ronnie M. Lester, do hereby certify that under requirements of P.A. 74, Michigan P.A. of 1970, the corner points mentioned in lines 1 and 2 above were, in a field survey on May 17, 1979, established, re-established, monumented, re-monumented, recovered or restored as expressed below and in conformance with regulations and rules therefore as required in the current manual of survey instructions of the United States Department of the Interior, Bureau of Land Management or by a decree of a court of law. Furthermore, that the corner points mentioned in lines 3, 4 and 5 above were, in a field survey on \_\_\_\_\_, 19\_\_\_\_, found, recovered, restored, established or re-established as expressed below and in conformance with the rules of the Michigan State Board of Registration for Land Surveyors or, by a Decree of a Court of law:

A. Description of original monument and accessories and/or subsequent restoration:

M-2

Post set in original government survey by J. Wampler dated between March 3 and 13, 1826.

Corner referred to in a survey by L.D. Preston, County Surveyor, Feb. 24, 1849 (v.2, p.82).

Corner referred to in a survey by A. Jackson, County Surveyor, Feb. 21, 1856 (v.2, p.271).

B. Description of corner evidence found and/or method applied in restoring or re-establishing corner:

M-2

Excavated a hole 6' x 14' to an average depth of 3.0', south of the intersection of Wilgus Road and Shaftsbury Road and on fence line to the north. Found pile of rocks 2.5' x 1.0' with pointed rock on top 5" below road surface, + 3.0' east of fence line to the north, + 3.0' east of the centerline of Shaftsbury Road and + 12.0' south of the centerline of Wilgus Road. Accepted pointed rock for corner.  
Excavation conducted by Ingham County Survey and Remonumentation Project crew.

C. Description of monument for corner and accessories established to perpetuate locating the position of the corner:

M-2

Ex Corner, Section 1, T4N-R1E

Set 4" x 36" concrete monument with  $\frac{1}{2}$ " x 38" rerod and cap #18998 in location of pointed rock described above:

Nail & tag, #18998, west side 32" Maple, ESE, 22.33'

Nail & tag, #18998, west side 32" Maple, SE, 43.87'

Nail & tag, #18998, south side 12" Oak, NE, 131.48'

Nail & tag, #18998, east side 34" Oak, NW, 45.80'

SIGNED BY

Ronnie M. Lester

DATE

7/6/79

SURVEYOR'S MICHIGAN REGISTRATION NO. 18998

SIGNED BY

Ray A. Kite  
CHIEF OF SURVEY PARTY

DATE


7-11-79

APPROVED AND SIGNED BY

MICHIGAN REGISTERED LAND SURVEYOR

Director, Ingham County Survey and  
Remonumentation Project

SURVEYOR'S MICHIGAN REGISTRATION NO. 17624

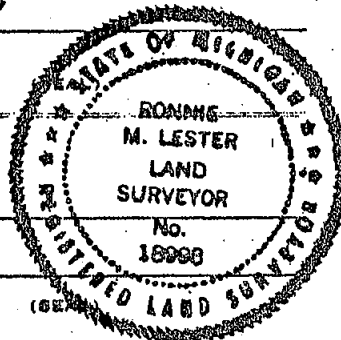

# MONUMENTED CORNER REPORT

TECH. SUP'R. G. Gillespie TOWNSHIP Williamston  
 COMPANY POIARTS CORNER CODE M-2  
 FIELD SQUAD #1 G. Hoffer RECORDED CORNER ✓  
 DATE 6-17-77 ROAD NAME SHIFTSBURG & GILGOS




Sketch, witness, and describe monuments found, and location relative to traverse point and centerline of road.

N  
 FD 1/2" ROD SET 12" FROM N 11-5-77 REPLACED  
 4" ROD MONUMENT 4x36" 4x6" ROD ENCASED ALL  
 TAGS ARE PL 15782 WITH SMOO AS WRITTEN  
 12/10/77

FINAL WITNESSES

SET N/T ON W/SIDE 32' MAPLE ESE 22.35 ✓  
 SET N/T ON W/SIDE 32' MAPLE SE 43.84 ✓  
 SET N/T ON S/SIDE 12' OAK NE 131.48 ✓  
 SET N/T ON E/SIDE 34' OAK NW 45.82 ✓

OPS  
 6-5-79

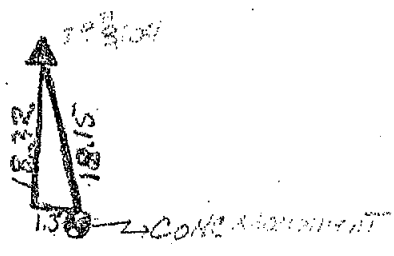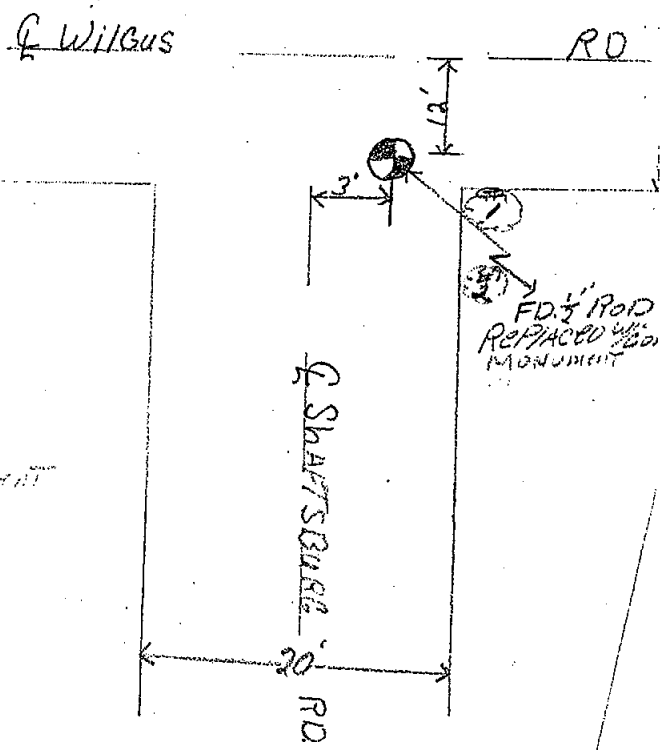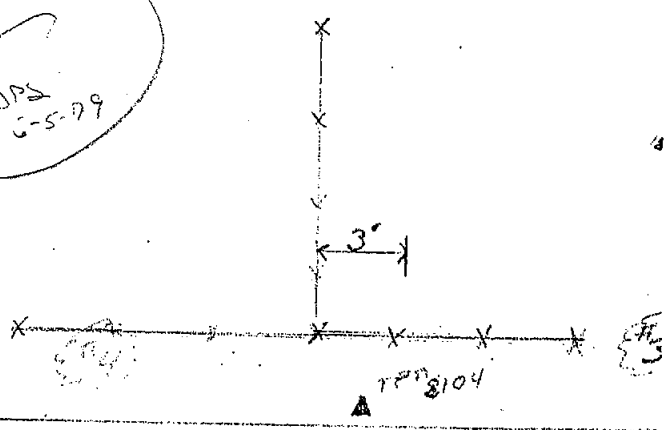

# MONUMENTED CORNER REPORT

TECH. SUP'R. G. Gillespie TOWNSHIP Williamston  
 COMPANY POLARIS CORNER CODE M-2  
 FIELD SQUAD #21 G. Hollon RECORDED CORNER ✓  
 DATE 5-17-79 ROAD NAME SHAFTSBURG & WILGUS




Sketch, witness, and describe monuments found, and location relative to traverse point and centerline of road.

N

FD 1/2" ROD SET BY REMON 11-9-77 REPLACED  
 1/4" CONC. MONUMENT 3/4" x 3/4" x 1/2" RE ROD ENCASED ALL  
 TAGS ARE PLS #18998 WITNESSED AS WRITTEN  
 BELOW

FINAL WITNESSES

1. SET N/T ON W/SIDE 32" MAPLE E.S.E. 22.31
2. SET N/T ON W/SIDE 32" MAPLE S.E. 43.89
3. SET N/T ON S/SIDE 12" OAK N.E. 45.78
4. SET N/T ON E/SIDE 34" OAK N.W. 131.47

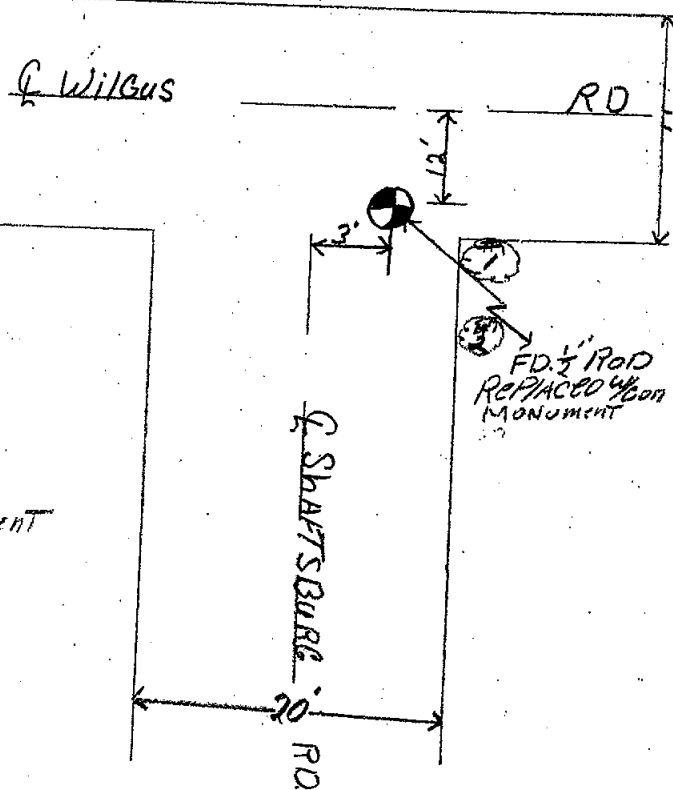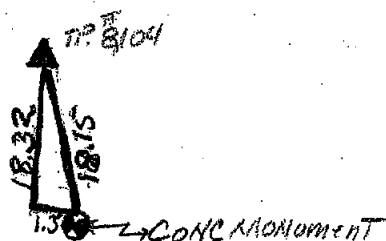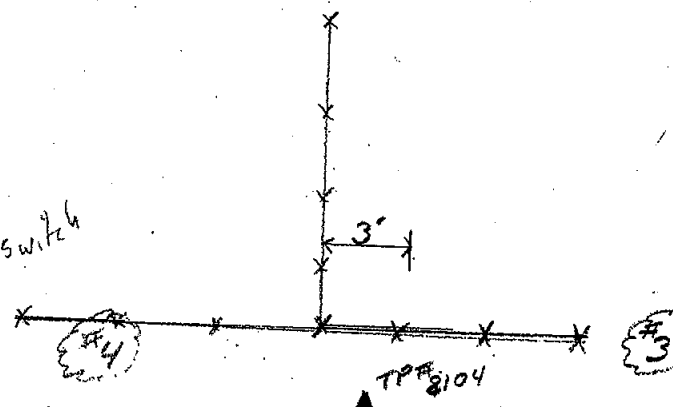


# CORNER EXCAVATION REPORT

TECH. SUP'R. Leslie TOWNSHIP Williamston CKE  
 COMPANY POLARIS CORNER CODE M-2 / A-2  
 FIELD SQUAD # 21 G. Hollen PAGE 1 OF 1 DATE 5-4-79

EXCAVATED AREA: 6' x 6' SQ. FT.; AVG. DEPTH 3' SURFACE 6" GRAVEL  
2.5' CLAY

SKETCH AND DESCRIBE ROADS, MONUMENTS FOUND OR SET, AND WITNESSES ESTABLISHED:

N  
 EXCAVATED 6x6 HOLE, WEST EDGE OF EXCAVATION  
 ON FENCELINE NORTH 1/2 ON E OF SHAFTSBURG RD.  
 12' SOUTH OF WILGUS RD TO NORTH EDGE OF EXC.  
 ED. 1/2" IRON ROD, 2' EAST OF F.L. TO NORTH.  
 12' SOUTH OF E OF WILGUS RD & 4' EAST OF  
 E OF SHAFTSBURG RD.

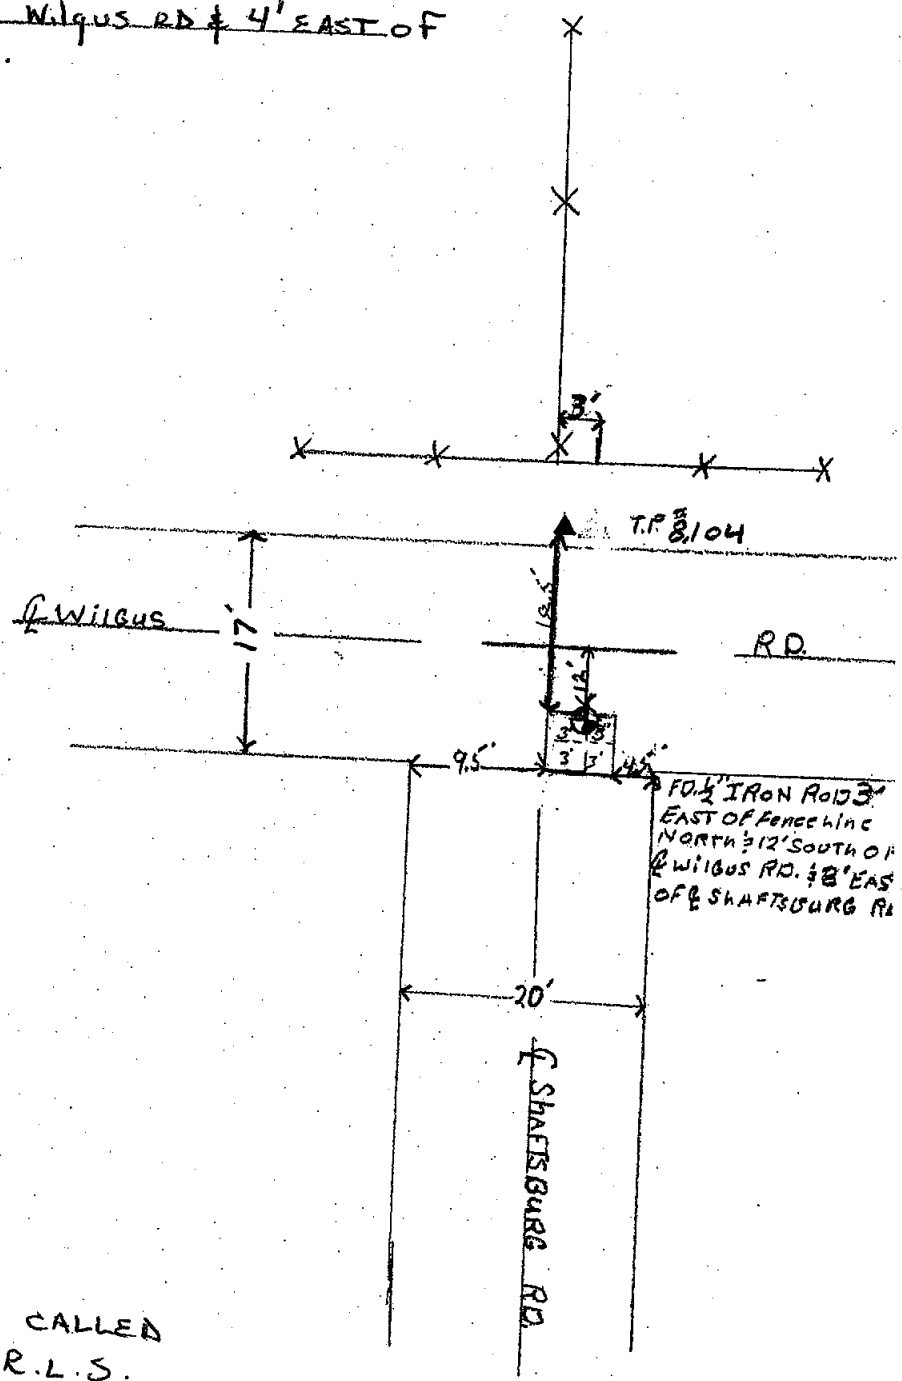


5/8/79  
 EXCAVATION FINISHED AS CALLED  
 FOR. NEED REVIEW BY R.L.S.  
 -021

# PRELIMINARY EXCAVATION REPORT

TECH. SUP'R. BRYAN TOWNSHIP LOCKE LIAMSTON  
 COMPANY POLARIS CORNER CODE A-2 / M-2  
 FIELD SQUAD #9 MINSHALL ROAD NAME WILGUS @ SHAFTSBURG / GRAVE

Sketch, witness, and describe monuments found and proposed excavation site relative to traverse point and centerline of road.

BEGIN EVC. @ FD. IRON (SET SUBSEQUENT TO EVC, 11/9/77)  
 SEE COR. EVC. REPORT FOR WITNESSES.

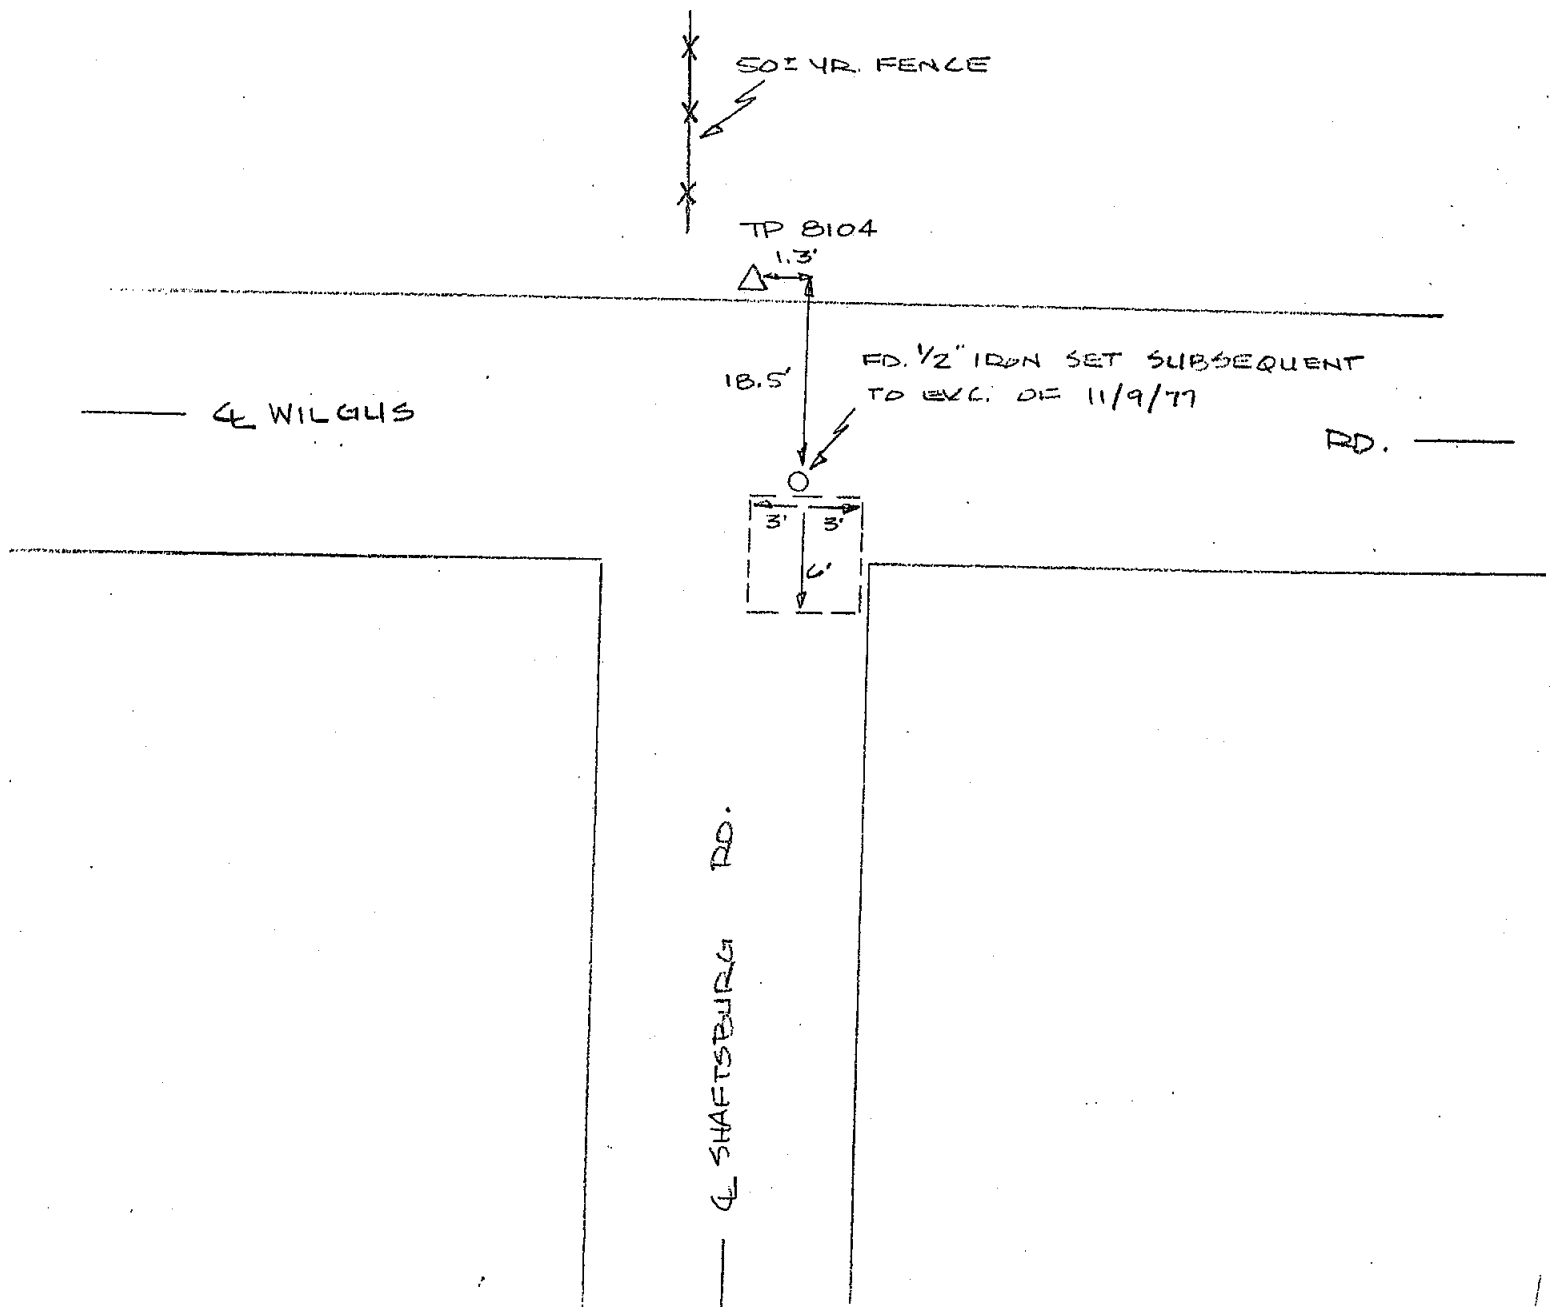

3-20-78; Fld. Form No.


# MONUMENTED CORNER REPORT

TECH. SUP'R. L. BRYAN TOWNSHIP WILL  
 COMPANY DOLARIS CORNER CODE A-2 / M-2  
 FIELD SQUAD #9 MINERAL RECORDED CORNER NO  
 DATE 8-17-78 ROAD NAME WILGUS @ SHATTSBURG

Sketch, witness, and describe monuments found, and location relative to traverse point and centerline of road.



FD 1/2" IRON RODS SET DURING EXCAVATION OF 11-9-77.  
 SEE LOG EXCAVATION REPORT FOR WITNESSES TO FD. 1054.

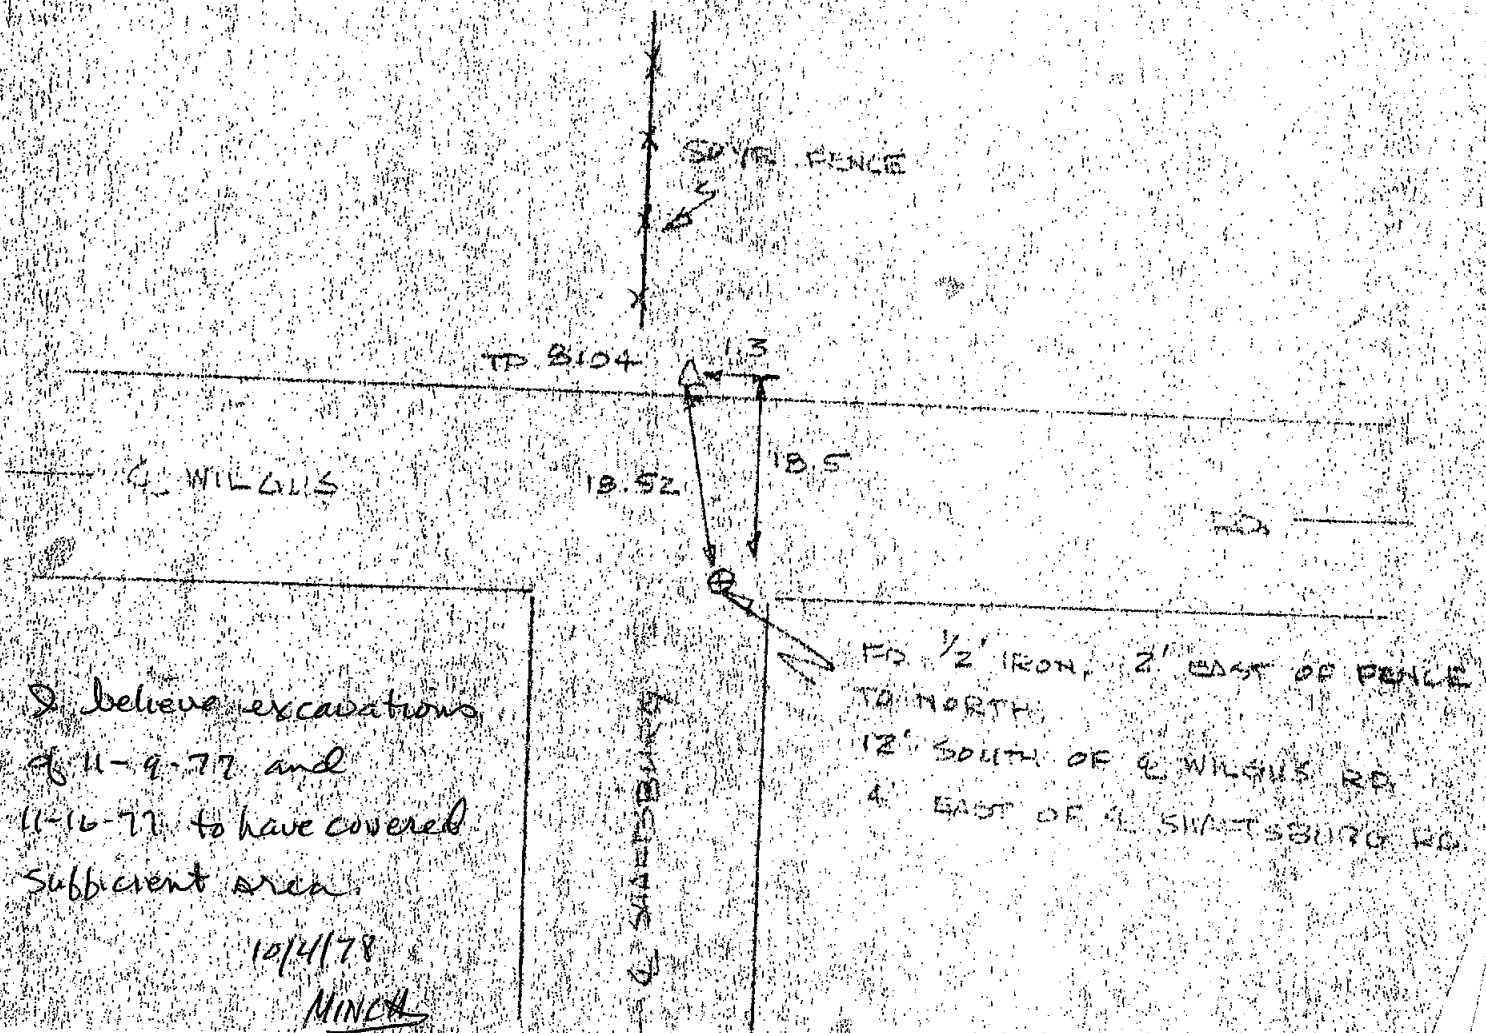

## CORNER AVATION REPORT

Tech. Sup'r L. BRYAN

Company **POLARIS**

Field Squad JOHN M. Campos

Township ~~the~~ Williamstown

Corner Code ~~11-2~~ 1M-2


Page 7 of 7

Date 11-16-77

Excavated Area: 18 sq. ft., Avg. depth 3; Surface: GRAVEL  
second hole 6 " " " "

Sketch and describe roads, monuments found or set, and witnesses established:

No findings on hole dug north side of centerline  
" " " " " South " " "

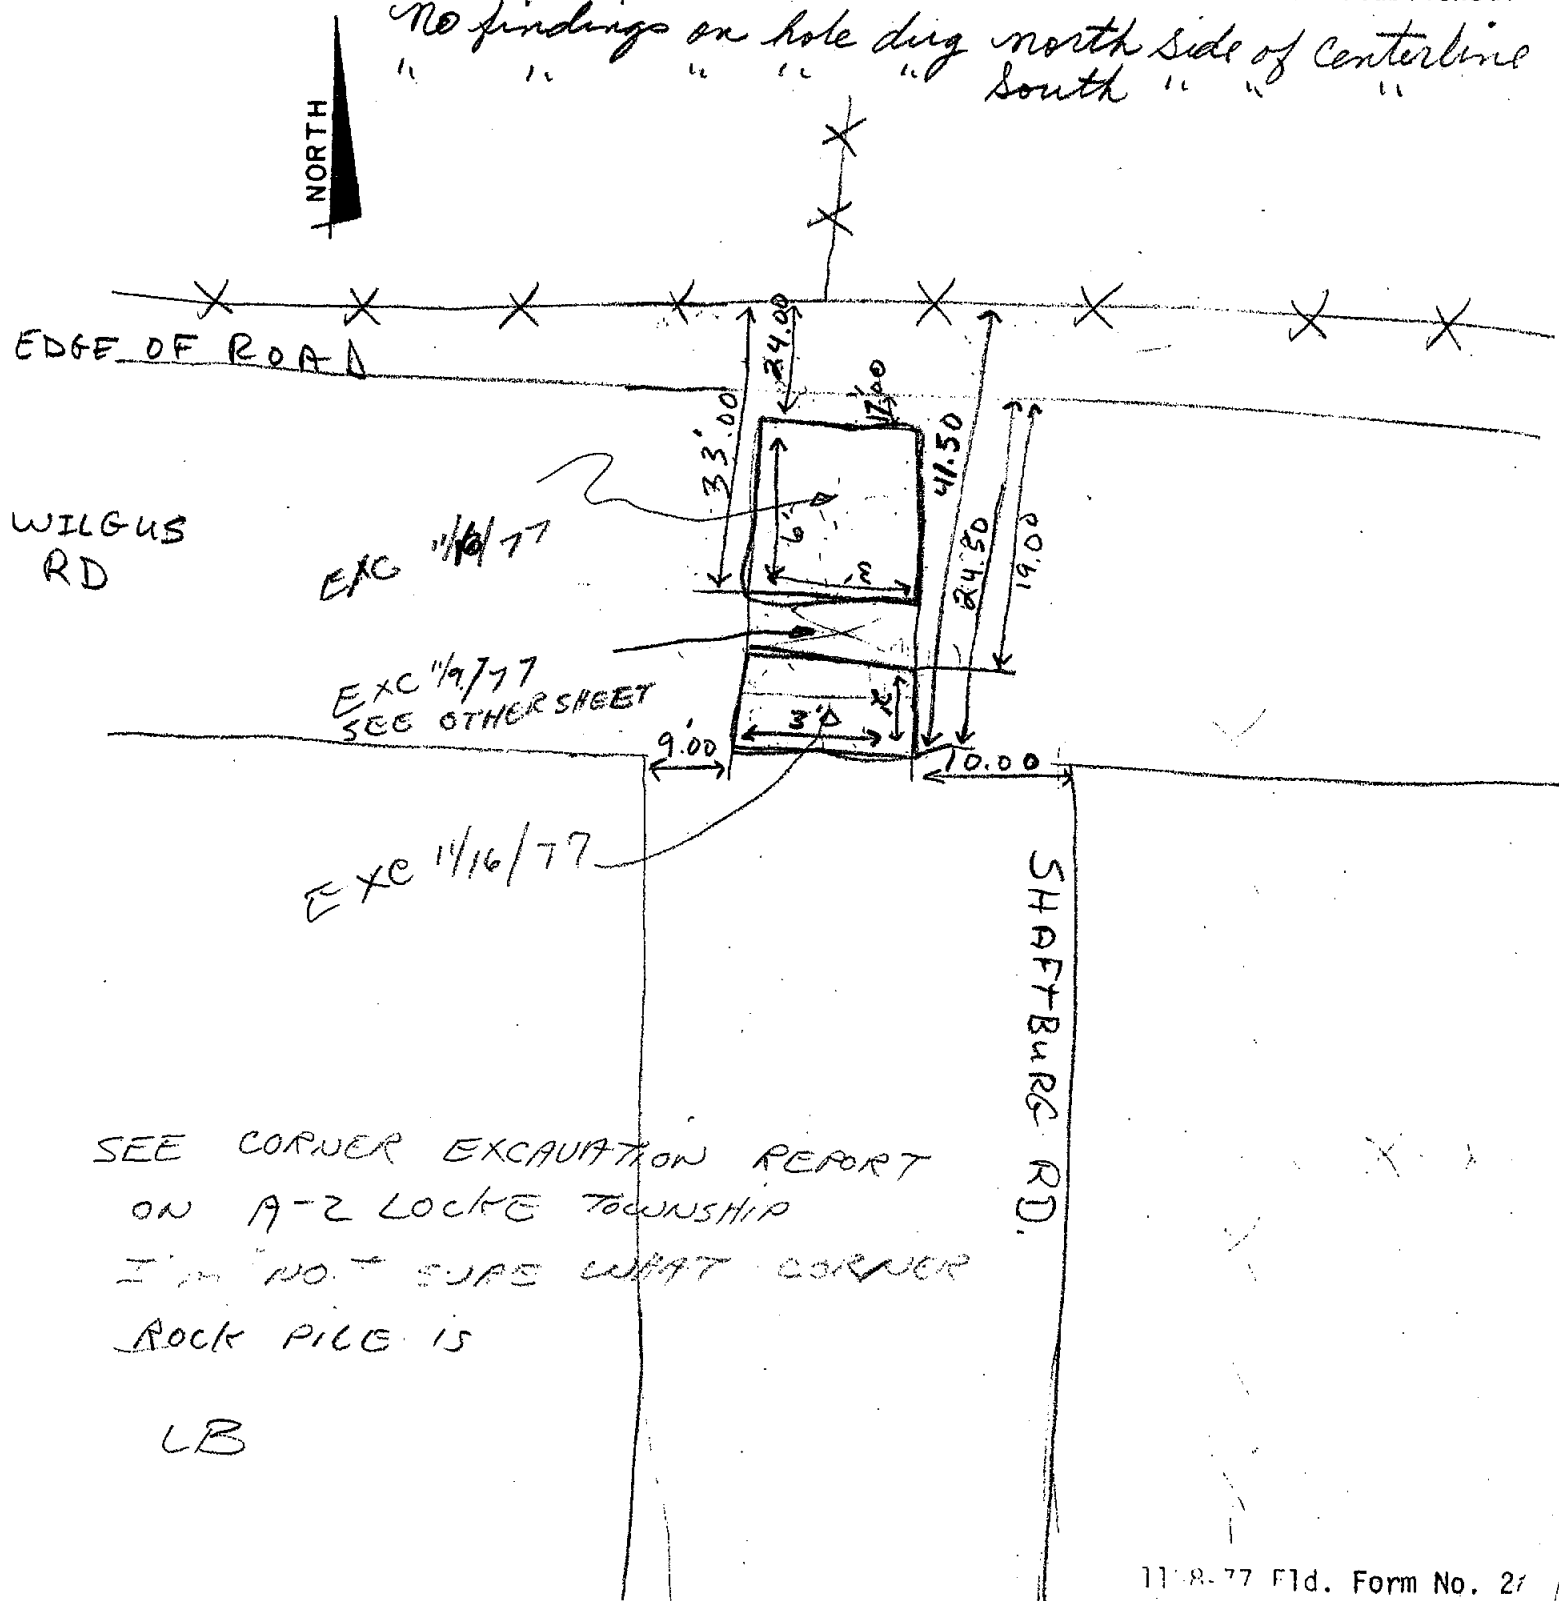

# CORNER E VATION REPORT

Tech. Sup'r L. BRYAN

Company POLARS

Field Squad JOHN CAMPOS

Township Loc 1/1116

Corner Code A-2 / M-2

Page 1 of 1

Date 11-9-77


Excavated Area: 3' BY 4' sq. ft.; Avg. depth 2'; Surface: GRAVEL

Sketch and describe roads, monuments found or set, and witnesses established:

monu. found pile of rocks 5' down with 3' of gravel on top. 2 1/2 by 1' and 10 pieces of iron. Pile with a pointed rock of top  
witnesses

W. TAG E. SIDE Oak tree N. 45° N.W. 45.25 32" size of tree  
W. TAG W. SIDE Maple tree 45° S.E. 22.32 32"  
W. TAG W. SIDE Maple tree 30° S.E. 43.92 32"  
W. TAG S. SIDE OAK TREE N. 65° E. 131.62 24"

WOODEN FENCE POLE

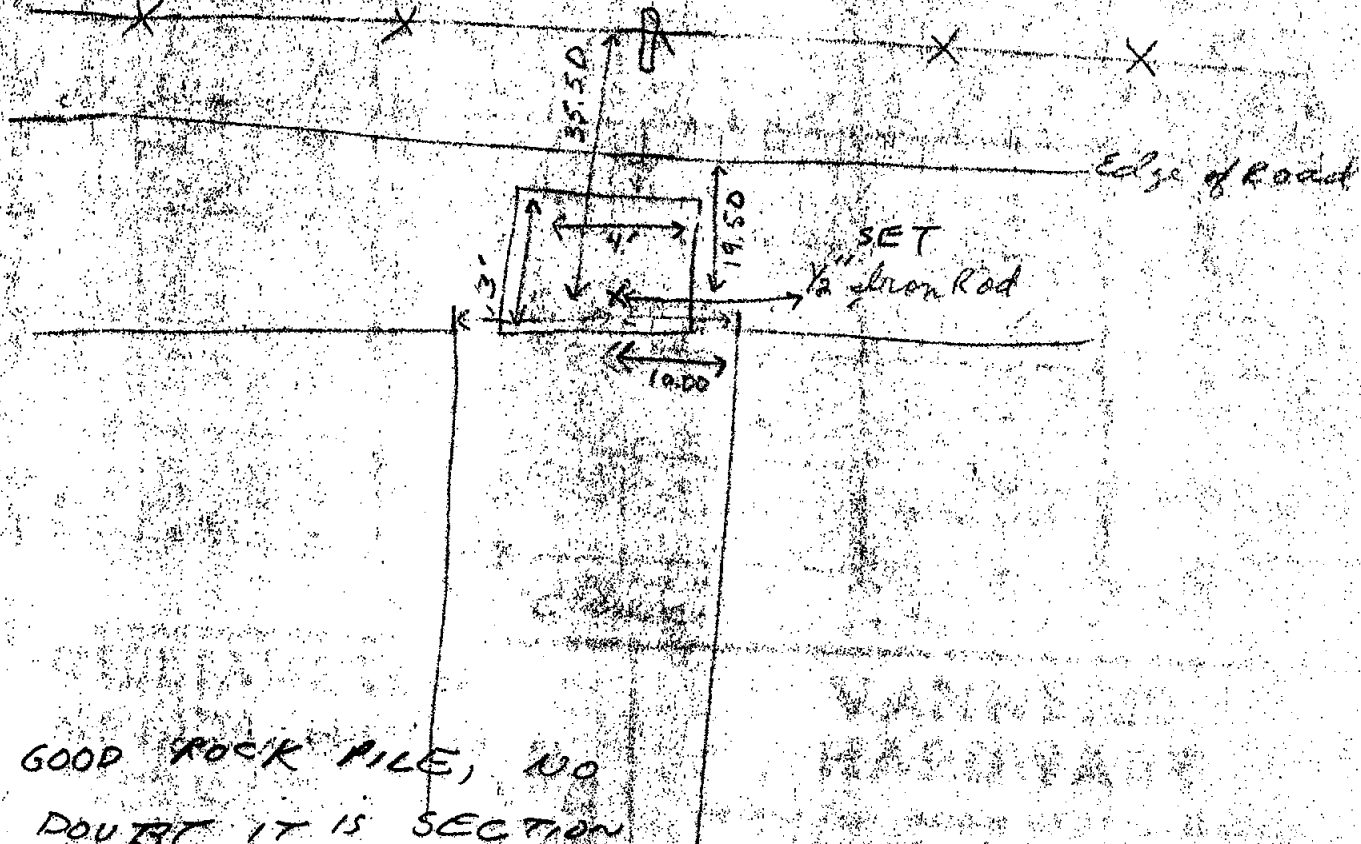

GOOD ROCK PILE, NO  
DOUBT IT IS SECTION  
CORNER, ON OLD FENCE  
LINE NORTH



# TRAVERSE POINT WITNESS REPORT

Traverse Point No. 8104

Tech. Sup'r. L. BRYAN

Township Locke

Company POLARIS

Recorded

Corner

Code

Field Squad MARTIN #4

Date 3-15-78


GENERAUX

Sketch and describe roads, monuments found or set, and witness established:

37.87 (1) Fd N+T on W side 25" MAPLE  
S 45° E 37.87'

61.51 (2) Fd N+T on W side 24" MAPLE  
S 20° E 61.51'

31.95 (3) Fd N+T on E side OAK  
N 60° W 31.95'

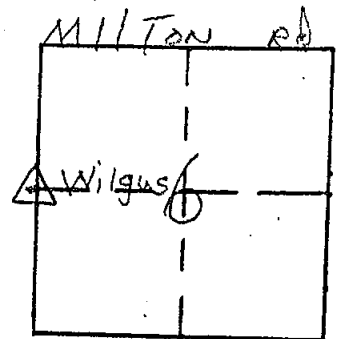

#3

Set 1/2" re rod.  
w/ing Temp pt cap

8.30' N of E Wilgus

1.60' W of E SHAFTS burg

Wilgus



SHAFTS burg rd

#1

#2

# INGHAM COUNTY SURVEY and REMONUMENTATION PROJECT

Township WILLIAMSTON , T 4 N , R 1E

Corner Code M-3

| Research Record:                                                 | attachment<br>number(s) | no. of<br>sheets | researched<br>by | reviewed<br>by |
|------------------------------------------------------------------|-------------------------|------------------|------------------|----------------|
| Corner Recordation Certificate<br>Liber 5 Page 242               | 0                       | 1                | Menhe            | Jeb            |
| Recorded Land Survey<br>Liber Page                               | N.D.                    |                  |                  | Jeb            |
| Recorded Subdivision Plat<br>Liber Page                          | N.D.                    |                  |                  | Jeb            |
| MDSHT Right-of-Way Maps<br>Sheet No.                             | N.D.                    |                  |                  | Jeb            |
| Ingham County Road Comm. Maps<br>Sheet No.                       | N.D.                    |                  |                  | Jeb            |
| Record of the Ingham County<br>Surveyor Vol. 2 Page 82 Year 1849 | 1                       | 1                |                  | Jeb            |
| 3 207 1889                                                       | 2                       | 2                |                  | Jeb            |
| 3 209 1889                                                       | 3                       | 1                |                  | Jeb            |
| General Land Office Maps<br>Sheet No. 16                         | 4                       | 1                |                  | Jeb            |
| Form 280, Gov't. Monument<br>Witness Record                      | N.D.                    |                  |                  | Jeb            |
| Ingham County Drain Comm.<br>File No.                            | N.D.                    |                  |                  | Jeb            |
| East Lansing City Engineer                                       | N.D.                    |                  |                  | Jeb            |
| Lansing Public Service Office<br>Cade's 1921 Survey p.           | N.D.                    |                  |                  | Jeb            |
| Lansing Public Service Office<br>J.B. Davis' Field Notes p.      | N.D.                    |                  |                  | Jeb            |
| G.L.O. Field Notes p. 11                                         | 5                       | 1                |                  | Jeb            |
| Misc. I.C. S. Notes                                              | N.D.                    |                  |                  | Jeb            |
| Field Recon. Form                                                | N.D.                    |                  | ✓                | Jeb            |
| RESEARCH COMPLETED                                               | Total                   | Total            |                  |                |
| Consumers Power Company<br>Sheet No. Index No.                   | N.D.                    |                  | Menhe            | Jeb            |
| Chesapeake & Ohio Railroad Co.<br>Val. Sec. Drawer Sheet         | N.D.                    |                  | "                | Jeb            |
| RESEARCH COMPLETED                                               | Total                   | Total            |                  |                |
| REMARKS                                                          |                         |                  |                  |                |
| NOTHING IN NOTES                                                 | N.D.                    |                  | Menhe            | Jeb            |
| FOLDER SET #1 p. 1, 3, 7, 16                                     | N.D.                    | 6/7/8/9          | "                | Jeb            |
| FOLDER SET #2 p. 2, 3, 11                                        | N.D.                    |                  | "                | Jeb            |

INGHAM COUNTY-WILLIAMSTON TWP.  
LAND CORNER RECORDATION CERTIFICATE  
FILING REQUIREMENT OF ACT 74, MICH. P.A.1970

| FOR CORNERS OF --:                                                               | LOCATED IN --: | CORNER CODE NUMBER |
|----------------------------------------------------------------------------------|----------------|--------------------|
| 1. PUBLIC LAND SURVEY _____ T. <u>4</u> N. <u>X</u> , R. <u>1</u> E. <u>X</u>    |                | M-3                |
| 2. PROPERTY CONTROLLING IN SECTION _____, T. _____ N. _____, R. _____ E. _____   |                |                    |
| 3. MISCELLANEOUS PROPERTY IN SECTION _____, T. _____ N. _____, R. _____ E. _____ |                |                    |
| 4. LOT NO. _____, RECORDED PLAT _____                                            |                |                    |
| 5. PRIVATE CLAIMS _____                                                          |                |                    |

REGISTER OF DEEDS STAMP AND  
FILING NUMBER

I, Ronnie M. Lester, do hereby certify that under requirements of P.A. 74, Michigan P.A. of 1970, the corner points mentioned in lines 1 and 2 above were, in a field survey on March 21, 1979, established, re-established, monumented, re-monumented, recovered or restored as expressed below and in conformance with regulations and rules therefore as required in the current manual of survey instructions of the United States Department of the Interior, Bureau of Land Management or by a decree of a court of law. Furthermore, that the corner points mentioned in lines 3, 4 and 5 above were, in a field survey on \_\_\_\_\_, 19\_\_\_\_, found, recovered, restored, established or re-established as expressed below and in conformance with the rules of the Michigan State Board of Registration for Land Surveyors or, by a Decree of a Court of law:

A. Description of original monument and accessories and/or subsequent restoration:

M-3

Post set in original government survey by J. Wampler, between March 3 and 13, 1826.

Corner referred to in surveys by L.D. Preston, County Surveyor, Feb. 24, 1849 (v.2, p.82) and J. McCreary, County Surveyor, March 22, 1889 (v.3, p.209).

Corner established as a gas pipe in a survey by J. McCreary, County Surveyor, March 14-15, 1889 (v.3, p.207).

Corner remonumented as 1" iron pipe by W. Lee Paddison, RLS #7256 and recorded as A-3 Locke Twp., T4N-R2E in L.4, P.204 (P74) May 19, 1972.

B. Description of corner evidence found and/or method applied in restoring or re-establishing corner:

M-3

Excavated a hole 2' x 2.8' to an average depth of 3.0' on the centerline of Shaftsbury Road and + 2.0' north of fenceline to the east. Found 1" iron pipe on the centerline of Shaftsbury Road and + 2.0' north of fenceline to the east.

Set  $\frac{1}{2}$ " bar on Nov. 9, 1977 until further measurements could be made. Measured south 3.3' to A-3 Locke Twp., T4N-R2E in close accord to G.L.O. falling distance.

Measured + 2675' south to M-4. Location of pipe also in close accord to witnesses as given in survey by J. McCreary. Accepted iron pipe for corner.

Excavation conducted by Ingham County Survey and Remonumentation Project crew.

C. Description of monument for corner and accessories established to perpetuate locating the position of the corner:

M-3

NE Corner, Section 12, T4N-R1E

Set 4" x 36" concrete monument with  $\frac{1}{2}$ " x 38" rerod and cap #18998 in location of iron pipe as described above:

Nail & tag, #18998, southwest corner fence post, SE, 43.70'

Nail & tag, #18998, north side power pole, WSW, 31.74'

Nail & tag, #18998, northwest side 30" Oak, NE, 41.04'

Nail & tag, #18998, north side 24" Maple, ESE, 30.82'

Concrete monument, A-3 Locke Twp., T4N-R2E, RLS #18998, South, 3.3'

SIGNED BY Ronnie M. Lester

DATE June 6, 1979

SURVEYOR'S MICHIGAN REGISTRATION NO. 18998

XXXXXXXXXXXXXXXXXXXXXXXXXXXXXXXXXXXXXXXXXXXXXXXXXXXXXXXXXXXXXXXXXXXXXXXXXXXX

SIGNED BY  
APPROVED AND SIGNED BY


CHIEF OF SURVEY PARTY

DATE

Director, Ingham County Survey and  
Remonumentation Project


REGISTRATION NO. 17624

DATE 6.6.79

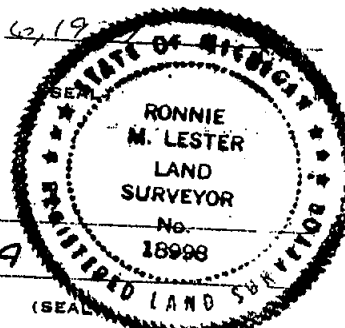

SOURCE: GLO MAP #16

TRANSCRIBED from ~~ORIGINAL~~ DUPLICATE on file at Remon. OFFICE

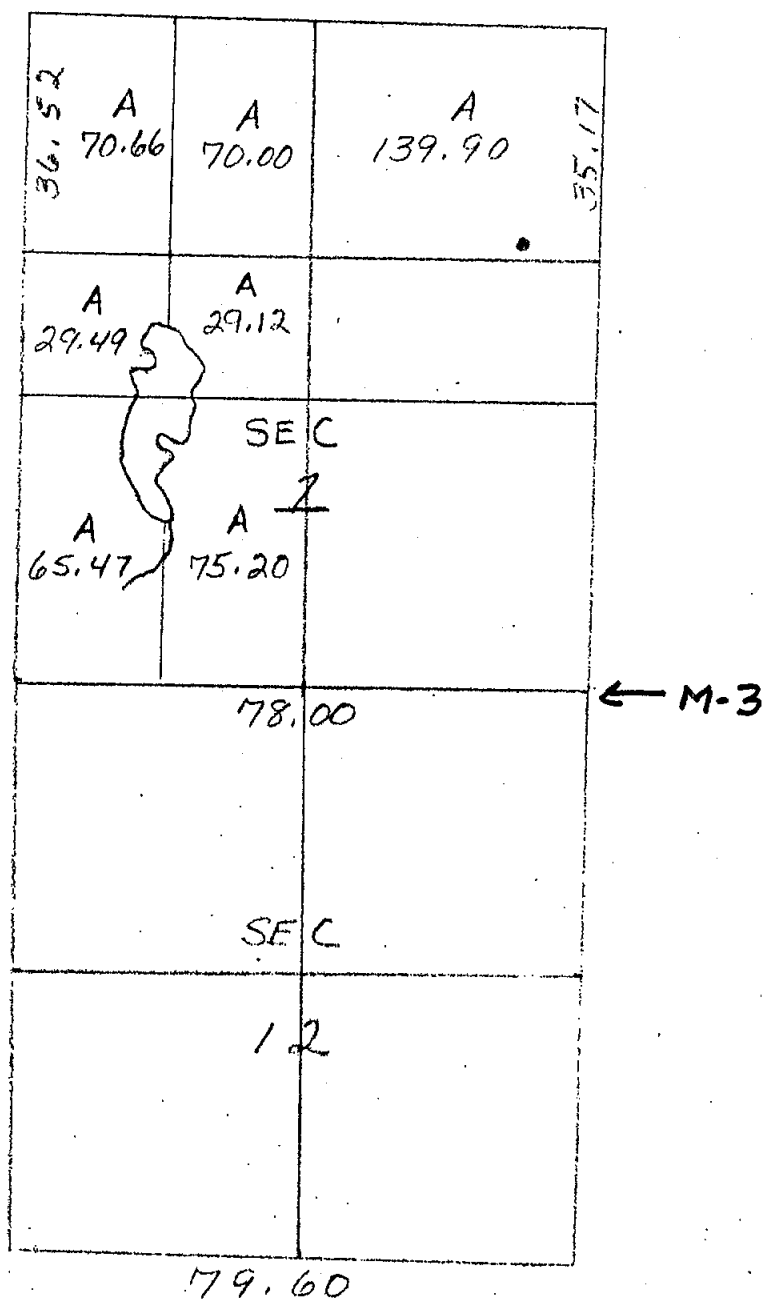

M-3 = 78.00 chs. from K-3  
M-3 = 80.00 chs. from M-5 (No written distance)  
M-3 = 95.17 chs. from M-1 (No written distance)

SOURCE: GLO FIELD NOTES p 11  
TRANSCRIBED from ORIGINAL on file at Remon. OFFICE  
DUPLICATE

*T. H. R. 1 E*  
*North in the E. corner of Sec. 12*  
*1.17 W. Oak 12 in diam*  
*25.30 B. Oak 13.*  
*40.00 Set 1/4 Sec post loc 19*  
*+ New stump 4 in 1/4 10 1/2 156 lbs*  
*12 in 1/4 196 W 203 lbs*  
*2 in 6 in 5 W 199 1/2 lbs*  
*Set gape 1/4 for corner 45 E 198*  
*74.43 W. Oak 18. diam*  
*80.52 Set 1/4 Sec post loc 12*  
*\* New stump 4 in 1/4 10 1/2 156 lbs*  
*12 in 1/4 196 W 203 lbs*  
*2 in 6 in 5 W 199 1/2 lbs*  
*Set gape 1/4 for corner 45 E 198*  
*Last timber same as last described.*  
  
*3 mi. mile to 38 lb short*  
*3 mi. mile to 38 lb short*  
*Located by measurement March 14th 1887*  
*\* Located March 14th 1889 by one of the witnesses*  
*of the U.S. Survey John H. Carey*  
*County Surveyor*

25P242

REGISTER OF DEEDS STAMP AND  
FILING NUMBER

I, Ronnie M. Lester, do hereby certify that under requirements of P.A. 74, Michigan P.A. of 1970, the corner points mentioned in lines 1 and 2 above were, in a field survey on March 21, 1979, established, re-established, monumented, re-monumented, recovered or restored as expressed below and in conformance with regulations and rules therefore as required in the current manual of survey instructions of the United States Department of the Interior, Bureau of Land Management or by a decree of a court of law. Furthermore, that the corner points mentioned in lines 3, 4 and 5 above were, in a field survey on \_\_\_\_\_, 19\_\_\_\_, found, recovered, restored, established or re-established as expressed below and in conformance with the rules of the Michigan State Board of Registration for Land Surveyors or, by a Decree of a Court of law:

Post set in original government survey by J. Wampler, between March 3 and 13, 1826.  
Corner referred to in surveys by L.D. Preston, County Surveyor, Feb. 24, 1849  
(v.2, p.82) and J. McCreary, County Surveyor, March 22, 1889 (v.3, p.209).  
Corner established as a gas pipe in a survey by J. McCreary, County Surveyor,  
March 14-15, 1889 (v.3, p.207).  
Corner remonumented as 1" iron pipe by W. Lee Paddison, RLS #7256 and recorded as  
A-3 Locke Twp., T4N-R2E in L.4, P.204 (P74) May 19, 1972.

Excavated a hole 2' x 2.8' to an average depth of 3.0' on the centerline of Shaftsbury Road and + 2.0' north of fenceline to the east. Found 1" iron pipe on the centerline of Shaftsbury Road and + 2.0' north of fenceline to the east. Set  $\frac{1}{2}$ " bar on Nov. 9, 1977 until further measurements could be made. Measured south 3.3' to A-3 Locke Twp., T4N-R2E in close accord to G.L.O. falling distance. Measured + 2675' south to M-4. Location of pipe also in close accord to witnesses as given in survey by J. McCreary. Accepted iron pipe for corner. Excavation conducted by Ingham County Survey and Remonumentation Project.

NE Corner, Section 12, T4N-R1E  
Set 4" x 36" concrete monument with ½" x 38" rerod and cap #18998 in location  
of iron pipe as described above:  
Nail & tag, #18998, southwest corner fence post, SE, 43.70'  
Nail & tag, #18998, north side power pole, WSW, 31.74'  
Nail & tag, #18998, northwest side 30" Oak, NE, 41.04'  
Nail & tag, #18998, north side 24" Maple, ESE, 30.82'  
Concrete monument, A-3 Locke Twp., T4N-R2E, RLS #18998, South, 3.3'

DATE June 6, 19

~~XXXXXXXXXXXXXXXXXXXXXXXXXXXXXXXXXXXX~~

CHIEF OF SURVEY PARTY  
*James W. Smith*  
 MICHIGAN REGISTERED LAND SURVEYOR  
 Director, Ingham County Survey and  
 Remonumentation Project  
 REGISTRATION NO. 17624

DATE \_\_\_\_\_  
DATE 6.6.79

62.19

STATE OF MISSISSIPPI

SEAL

RONNIE  
M. LESTER  
LAND  
SURVEYOR  
No. 18998

MISSISSIPPI LAND SURVEYOR

(SEAL)

FORM APPROVED BY MICHIGAN STATE BOARD OF REGISTRATION, JAN. 28, 1971  
REVISOR MAY 14, 1975

MAY PLACE SKETCH ON BACK OR ATTACHED SHEET

# MONUMENTED CORNER REPORT

TECH. SUP'R. C. H. H. C. S. P. C.

TOWNSHIP WILKINSON

COMPANY POLARIS

CORNER CODE M-3

FIELD SQUAD 21 G. Hollen

RECORDED CORNER

DATE 3-21-79

ROAD NAME SHAFTSBURG

Sketch, witness, and describe monuments found, and location relative to traverse point and centerline of road.

C/R

1) 43.71 43.71  
 2) 31.76 31.71  
 3) 41.04 41.03  
 4) 30.81 30.82  
 5) 3.35

N.

FD 1 1/2" PIPE BY WIT. FD IN CRC. M-3  
REPLACED WITH CONC. MONUMENT <sup>PLS</sup> 18998 SET  
TO WIT. WRITTEN BELOW

NO RLS. Tack  
NEED TO BE REWITNESSED  
3-21-79 G. Holloway  
#21

## FINAL WITNESSES

SET CONC. MOUNT W/ 1/2" RERO  
ENCASED RLS #18998 ALL N/TAGS SET  
ARE RLS. #18998

1.) NAIL  $\frac{1}{3}$  TAG S/W corner Fence post S.E. 43.54

2.) NAIL  $\frac{1}{2}$  TAG N/side P.P. W.S.W. 31.71

3.) NAIL  $\frac{1}{2}$  TAG  $\frac{1}{4}$  SIDE 30" OAK N.E. 41.15'


1. NAIL; TAG N/SIOC 24" VIAPLE E.S. E29.91

2. A-3 CONC. MON RLS# 18993 S. 3.35'

Checked CRC 4-18-79


50 21 Billion

OK

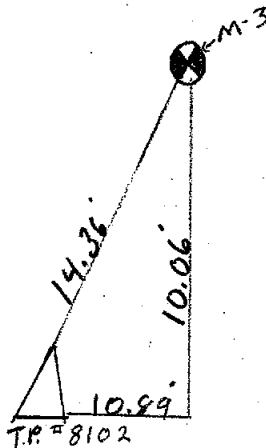

Checked FINAL W.T's  
Changed TAG Bearings

3-27-79  
Sø 21 B. Hollow

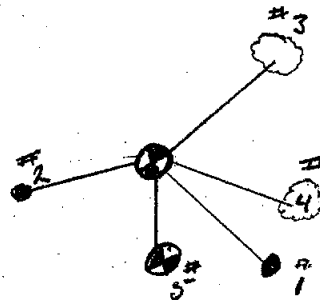

22<sup>+</sup>

11.5 x

RD 

141-3 FD 1 1/2" PIPE  
REPLACED WITH CONC. MON  
R/S # 18999

→ A-3 FD. CONC. 141011  
RLS. = 18998

Checked W: 4-17-79

SC 216. Hollon  
G/P

|           |       |
|-----------|-------|
| 1.) 43.70 | 43.69 |
| 2.) 31.69 | 31.73 |
| 3.) 41.04 | 41.43 |
| 4.) 30.83 | 30.81 |
| 5.) 3.37  | 3.37  |

# PRELIMINARY EXCAVATION REPORT

TECH. SUP'R. B. BRIAN

TOWNSHIP LOCKE / WILLIAMSTON

COMPANY POLARIS

CORNER CODE A-3 LOCKE / A-3 WILLIAMSTON

FIELD SQUAD \_\_\_\_\_

ROAD NAME SHUTTSBURG RD.

Sketch, witness, and describe monuments found and proposed excavation site relative to traverse point and centerline of road.

WITNESSES M-3 WILL.

N+T N side FENCE POST  
S 50 E 43.63'

N+T S side 24" MAPLE  
S 80 E 31.10'

N+T N side 30" OAK  
N 18 E 41.06'

N+T N side POWER POLE  
S 25 W 31.80'

WITNESSES A-3 LOCKE

N+RIBBON S. SIDE OAK ESE  
27.78'


N+RIBBON N. SIDE FENCE POST  
SE 40.96'

N+RIBBON N. SIDE PHONE POLE  
SW 30.16'

N+RIBBON OAK NE 43.80'

SET MON HERE  
FOR M-3 WMSTN.


9-12-76 C. EVERITT  
TRIP M-3 WILLIAMSTON  
Twp. AND A-3 LOCKE  
Twp. INTO TRAVERSE.

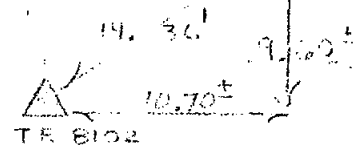

1" IRON PIPE  
M-3 WILLIAMSTON

XXXXXXXXXXXX

1/2" IRON BAR W/INSTR. TEMP.  
CAP A-3 LOCKE

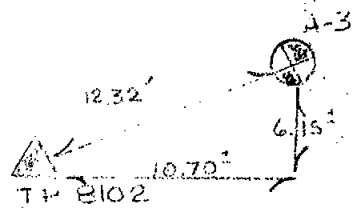





GARY D. LESTER, RLS  
RONNIE M. LESTER, RLS  
MAYNARD R. DYER, RLS  
LARRY A. BRYAN, RLS

3422 HAGADORN ROAD

MASON, MICHIGAN 48854

PHONE 517 / 351-7410

November 21, 1978

Mr. W. Lee Paddison  
1414 Sunnyside Ave.  
Lansing, MI 48910

Dear Mr. Paddison,

Upon review of excavation reports for A-3 Locke Township and M-3 Williamston Township, submitted by the Field Operations staff of the Ingham County Survey and Remonumentation Project, it appears as though the corner recorded by you in Liber 4 Page 204, Ingham County Land Corner Recordation Certificates as A-3 Locke Township may be M-3 Williamston Township. Our research on the two corners in question shows the following: 1) the General Land Office Field notes show that A-3 Locke is located 5 links (3.3') south of M-3 Williamston; 2) John McCreary, County Surveyor, set a gas pipe for M-3 Williamston on March 14 & 15, 1889 and used these witnesses: 2" Maple, S73E, 47 lks, and 4" White Oak, N43E, 61 lks. Our excavation crew found a 1" pipe in the centerline of Schaftsburg Road and a pointed rock, 3.3' south of the pipe at the correct G.L.O. falling distance between M-3 Williamston and A-3 Locke. We also noted that the 24" Maple, S72°30'E, 29.97' used as a witness in your recordation of A-3 Locke, matches closely the 2" Maple, S73E, 47 lks. (31.02') used by John McCreary for M-3 Williamston as well as the 30" White Oak, N43E, 41.10' which closely matches the 4" White Oak N43E, 61 lks. (40.26') used by McCreary for M-3 Williamston in his 1889 survey. Attached are copies of the appropriate G.L.O. field notes for A-3 Locke and McCreary's 1889 survey.

We appreciate your attention to this matter. Please feel free to contact us if we may be of further assistance.

Sincerely,

Ronnie M. Lester  
Registered Land Surveyor

RML;lp

*set iron & record proper  
corner RL 2/19/79*

Dear Mr. Paddison,

Upon review of excavation reports for A-3 Locke Township and M-3 Williamston Township, submitted by the Field Operations staff of the Ingham County Survey and Remonumentation Project, it appears as though the corner recorded by you in Liber 4 Page 204 Ingham County Land Corner Recordation Certificates as A-3 Locke Township may be M-3 Williamston Township. Our research on the two corners in question shows the following: 1) the General Land Office Field notes show that A-3 Locke is located 5 links (3.3') south of M-3 Williamston 2) John McCreary, County Surveyor, set a gas pipe for M-3 Williamston on March 14 & 15, 1889 and used these witnesses: "2" Maple, S73E, 47 lks. and 4" White Oak, N43E, 61 lks. Our excavation crew found a 1" pipe in the centerline of Schaftsborg Road and a pointed rock, 3.3' south of the pipe at the correct G.L.O. falling distance between M-3 Williamston and A-3 Locke. We also noted that the 24" Maple, S72 30'E, 29.97' used as a witnesses in your recordation of A-3 Locke, matches closely the 2" Maple, S73E, 47lks. (31.02') used by John McCreary for M-3 Williamston as well as the 30" White Oak, N43E, 41.10' which closely matches the 4" White Oak N43E, 61 lks. (40.26') used by McCreary for M-3 Williamston in his 1889 survey. Attached are copies of the appropriate G.L.O. field notes for A-3 Locke and McCreary's 1889 survey.

We appreciate your attention to this matter. Please feel free to contact us if we may be of further assistance.

letter  
has been  
sent 11-28-79  
MT

# PRELIMINARY EXCAVATION REPORT

TECH. SUP'R. BRYAN TOWNSHIP LOCKE / WILLIAMSTON  
 COMPANY POLARIS CORNER CODE A-3 LOCKE / M-3 WILLIAMS  
 FIELD SQUAD \_\_\_\_\_ ROAD NAME SHAFTSBURG RD.

Sketch, witness, and describe monuments found and proposed excavation site relative to traverse point and centerline of road.

N  
↑

WITNESSES M-3 WILL.

N+T N side FENCE POST  
S50E 43.63'

N+T S side 24" MAPLE  
S80E 31.10'

N+T N side 30" OAK  
N18E 41.06'

N+T N side POWER POLE  
S25W 31.80'


WITNESSES A-3 LOCKE

N+RIBBON S. SIDE OAK ESE  
29.78'

N+RIBBON N. SIDE FENCE POST  
SE 40.96'

N+RIBBON N. SIDE PHONE POLE  
SW 30.16'

N+RIBBON OAK NE 43.80'

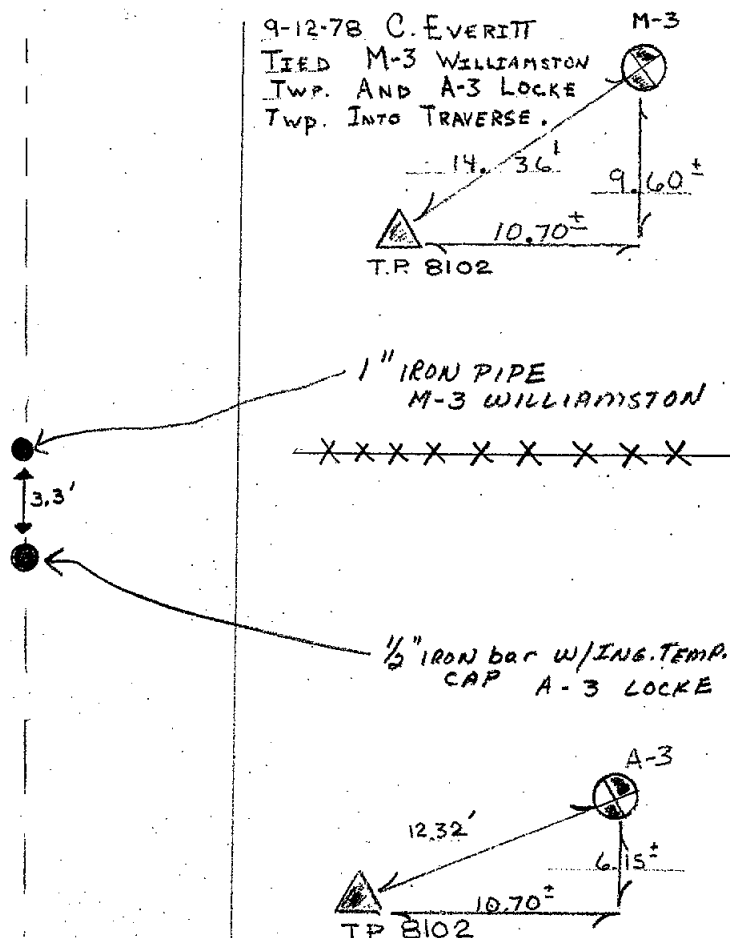

# CORNER EXCAVATION REPORT

Township WILLIAMSTON  
 Te Sup'r L. BRYAN

Corner Code M-3  
 Page 1 of 1



Company POLARIS ASSOC.

Field Squad SLINTON

Date 9 NOV 77

Excavated Area: \_\_\_\_\_ sq. ft.; Avg. depth 35"; Surface: GRAVE

Sketch and describe roads, monuments found or set, and witnesses established:

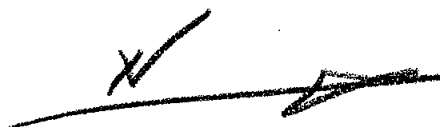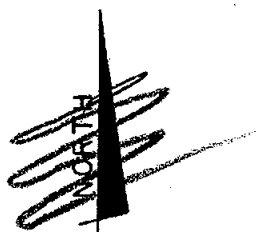


|     |         |                                   |
|-----|---------|-----------------------------------|
| RD. | 1" PIPE | E ROAD - ON FENCE EAST            |
|     | S 50° E | 43.63 NAIL & TAG IN N. SIDE FENCE |
|     | S 80° E | 31.10 " " " 5' 11" 24" MAPL       |
|     | N 18° E | 41.06 " " " N " 30" OAK           |
|     | S 25° W | 31.86 " " " N " POWER POLE        |

Witnesses - OK  
 Draw is  
 wrong!

Pl. 1" pipe  
 no iron bar thru  
 no sup. was set

Tried to set 1/2" iron bar  
 thru middle of pipe but  
 was not able to.

R.M.

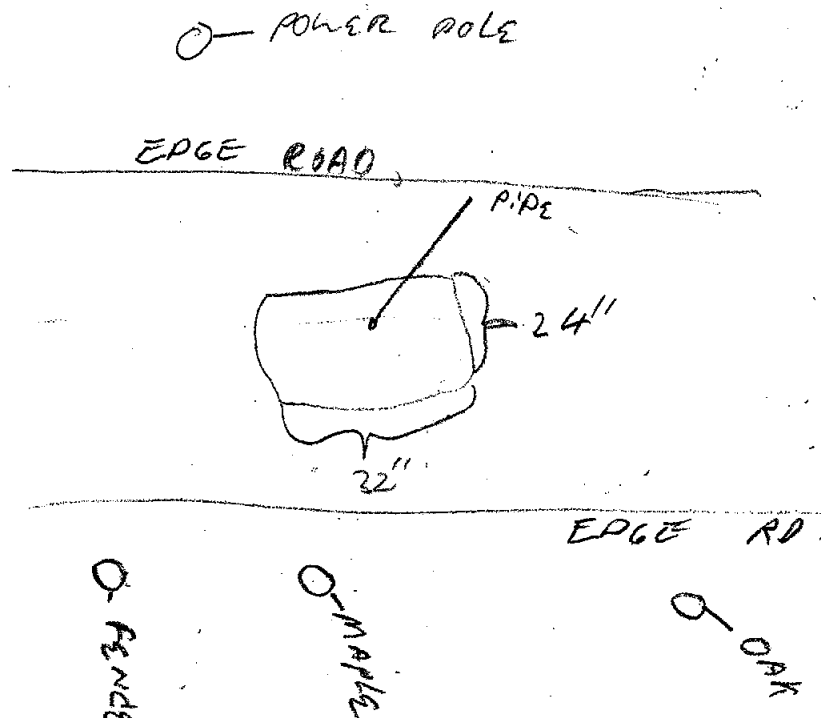

HOLE  
 35" DEEP  
 CENTERED  
 ON ROAD

OVER

# TRAVERSE POINT WITNESS REPORT

Traverse Point No. 8102

Tech. Sup'r. L. Bryan

Township Locke

Company POLARIS

Recorded  
Corner  
Code       


Field Squad MARTIN #4  
GENECCAUX

Date 3-16-78



N

Sketch and describe roads, monuments found or set, and witness established:

- 1) Fd. N+T on N side Wood Fence post  
S. 50° E. 45.10'
- 2) Fd. N+T on S side 18" Maple  
Due E 39.01'
- 3) Fd. N+F on N side 24" OAK  
N 45° E 55.40'

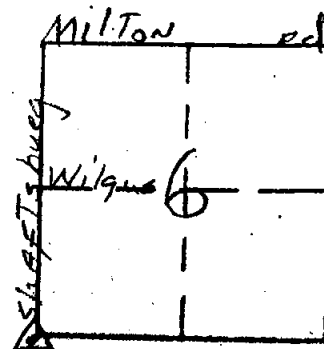

SET  $\frac{1}{2}$ " R-Rod  
w/ Ing. Temp. pt. cap  
11.22' W. of E

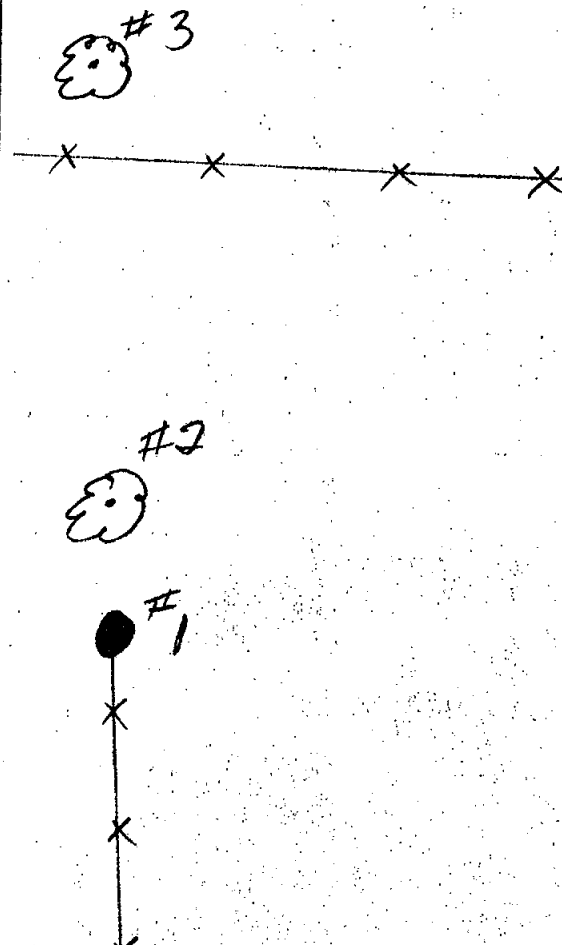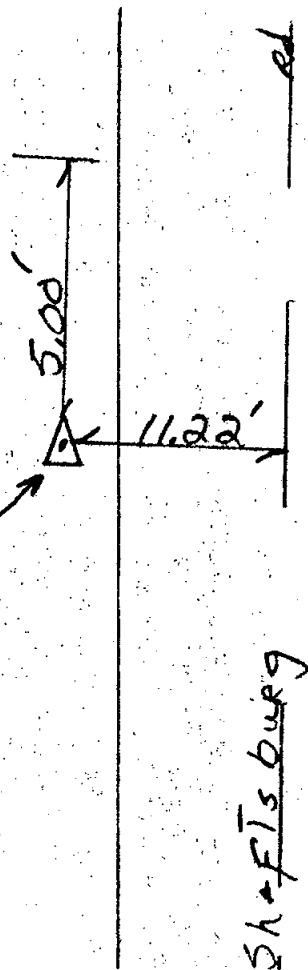

# WILLIAMSTON

T. 3-4 N.-R. 1 E. <sup>m1</sup>

SHIAWASSEE COUNTY

